

PWS 7855712



# New Southington K-12 School

Southington Local Schools  
2482 St. Rt. 534  
Southington, Oh 44470

IRN# 050237

Ph 330898-7480

Opening in School Year beginning August 2011

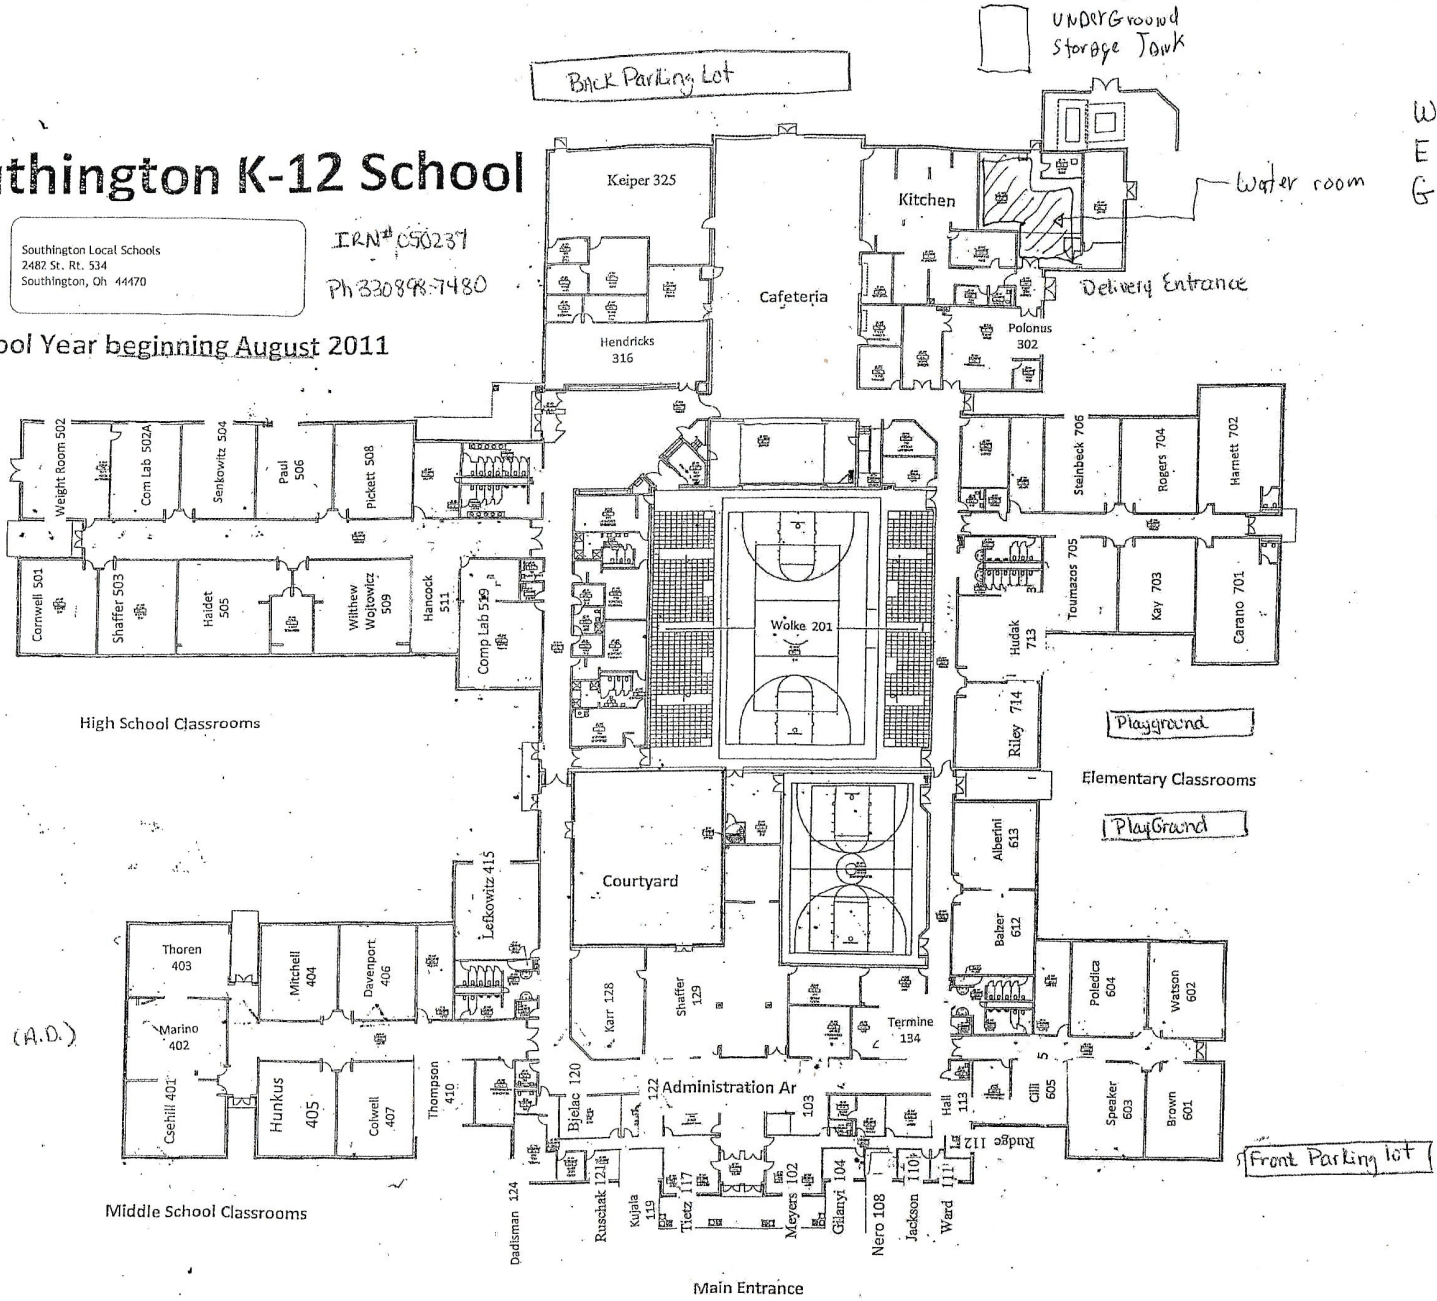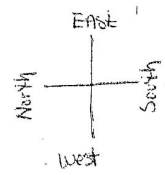

W  
E  
G

AED's located  
Front = 103  
Back = 205 (A.D.)

Southington Schools  
PWS 7855712  
nontransient noncommunity water system

2482 state route 534  
Southington, Ohio 44470

LC 201- room 702 - sink  
LC 202- room 706 - sink  
LC 203- room 714 - sink  
LC 204- room 612 - sink  
LC 205- room 410 - sink  
LC 206- room 402 - sink #4  
LC 207- room 509 - sink #2  
LC 208- room 505 - sink #5  
LC 209- kitchen - sink #1 north wall  
LC 210- kitchen - island sink

school was built in 2011. plastic pipe (pvc) used in water room  
well #1- 400 feet west of water room - service line plastic  
well water enters the water room than goes to water softeners. after the water softeners is RO unit. the water than goes to a outside underground 10,000 gallons storage tank for contact time.

the water system for the buildings than draws from this tank to by the use of two alternating pumps to pressurize the inside 250 gallons tank. the 250 gallons tank is steel. an oil less air pump keeps tank filled with proper amount of air.

the water is delivered to the rest of the building by copper pipe that has an o-ring crimp style connection. no solder joints at all.

all water fixtures are lead free