

*Village of Centerburg*  
*"In The Heart of Ohio"*

Dave Beck, Mayor  
740-625-7808  
mayor@centerburgoh.org

M. Joseph Hardin, Utility Superintendent  
740-625-6075  
jhardin@centerburgoh.org

Philip Lohmeyer, Village Administrator  
740-625-6075  
administrator@centerburgoh.org

RE: Lead Service Line and Fixture Mapping Project



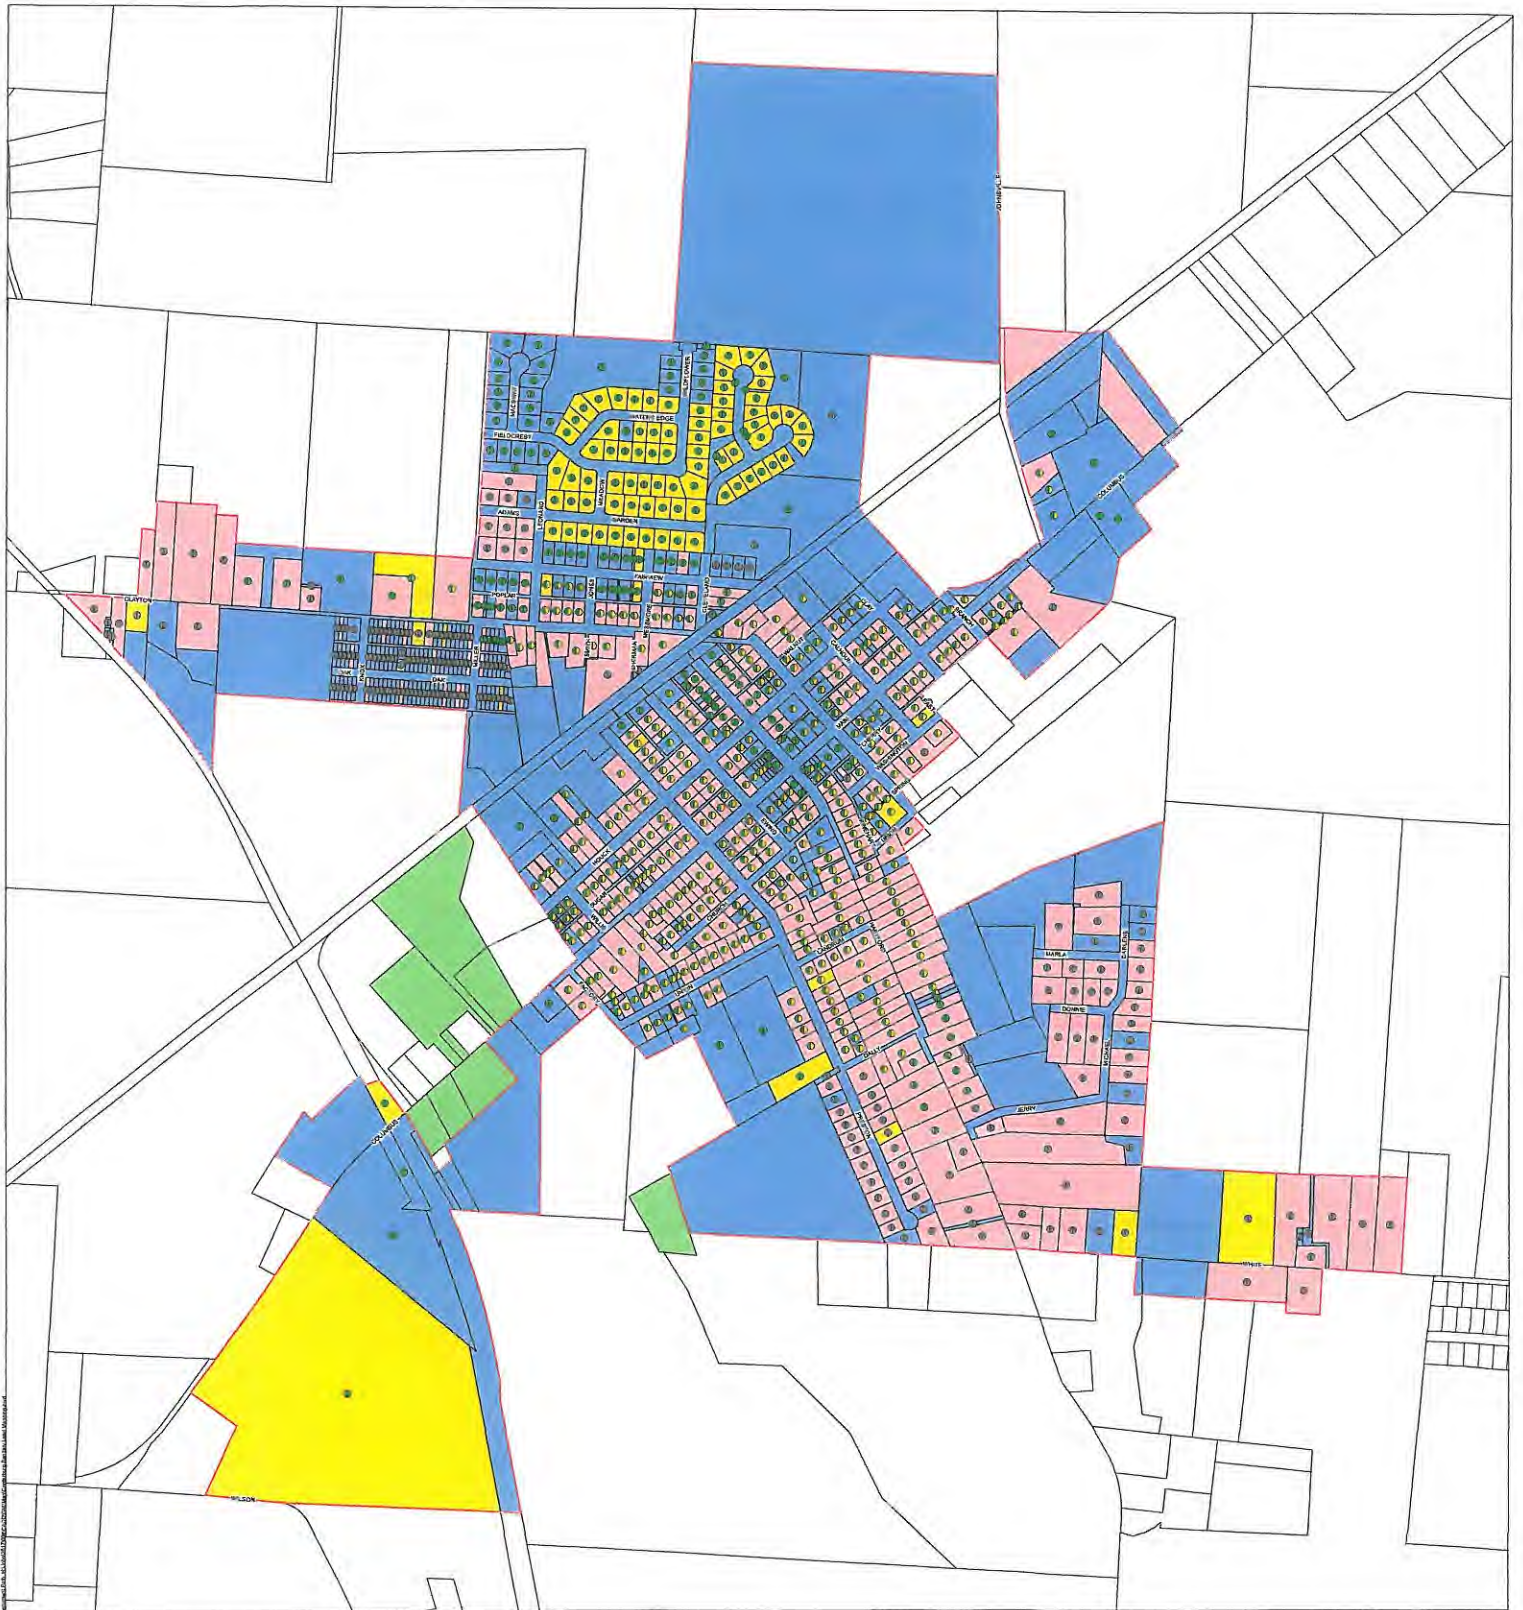
To whom it may concern,

 







Enclosed is a map of the Village of Centerburg with an overlay representing Public Water System #4200012. Parcels are shaded individually as to what year the structures were built which indicates the possibility or lack thereof to contain lead plumbing, fixtures and/or lead solder. A marker is placed on each parcel noting the water service line material. All parcels built between 1850 and 1998 are marked as lead service due to the possibility or likelihood of the service line material to have been installed as lead unless the Village or its personnel know that the material is non-lead. The Village has marked parcels as non-lead service material only if the material has been uncovered and known to be non-lead or if the material was installed per a non-lead specification. Areas or parcels marked as unknown are believed by the Village to be non-lead services however the Village does not have enough information on said area or parcel to deem it completely non-lead. As services are uncovered in the future and found to be other than depicted on this map the appropriate changes will be made.

Respectfully,


M. Joseph Hardin  
Utility Superintendent





<b>Lead</b>	 Centerburg City data
<b>Parcels</b>	
 Unknown	 Parcels serviced by Centerburg
 Lead Service	
 All Lead	
<b>Year Built</b>	
 Unknown	
 1950-1989	
 1990-2015	



 Village of Centerburg, Ohio PWS# <b>Lead Mapping</b>	
1 inch = 250 feet	Job No. 17-008
DWN, RJ, CKD, BPC Date: 3/1/2017	1 OF 1