



JESS HOWARD ELECTRIC COMPANY ENGINEERING & CONTRACTING

EQUAL OPPORTUNITY EMPLOYER

P.O. BOX 400 • 6630 TAYLOR RD. • BLACKLICK, OHIO 43004
PHONE (614) 861-1300 • FAX (614) 861-1830
STATE OF OHIO LICENSE NO: 18390

March 9, 2017

Jess Howard Electric
PWS-ID #: OH2547512
6630 Taylor Road
Blacklick OH 43004

The copper plumbing in the Jess Howard Electric (OH2547512) public water system was installed in 1973.

Sincerely,

A handwritten signature in blue ink, appearing to read 'Jonathan F. Howard', is written over the word 'Sincerely,'.

Jonathan F. Howard
President

PRIMARY

TRANSFORMERS • SUBSTATIONS
POLE LINE • CONSTRUCTION

INDUSTRIAL


MOTORS • COMPENSATORS
RECTIFIERS • ALL OTHER
FACTORY EQUIPMENT

COMMERCIAL

LIGHTING
& WIRING

RESIDENTIAL

THE LATEST WIRING
FOR MODERN LIVING

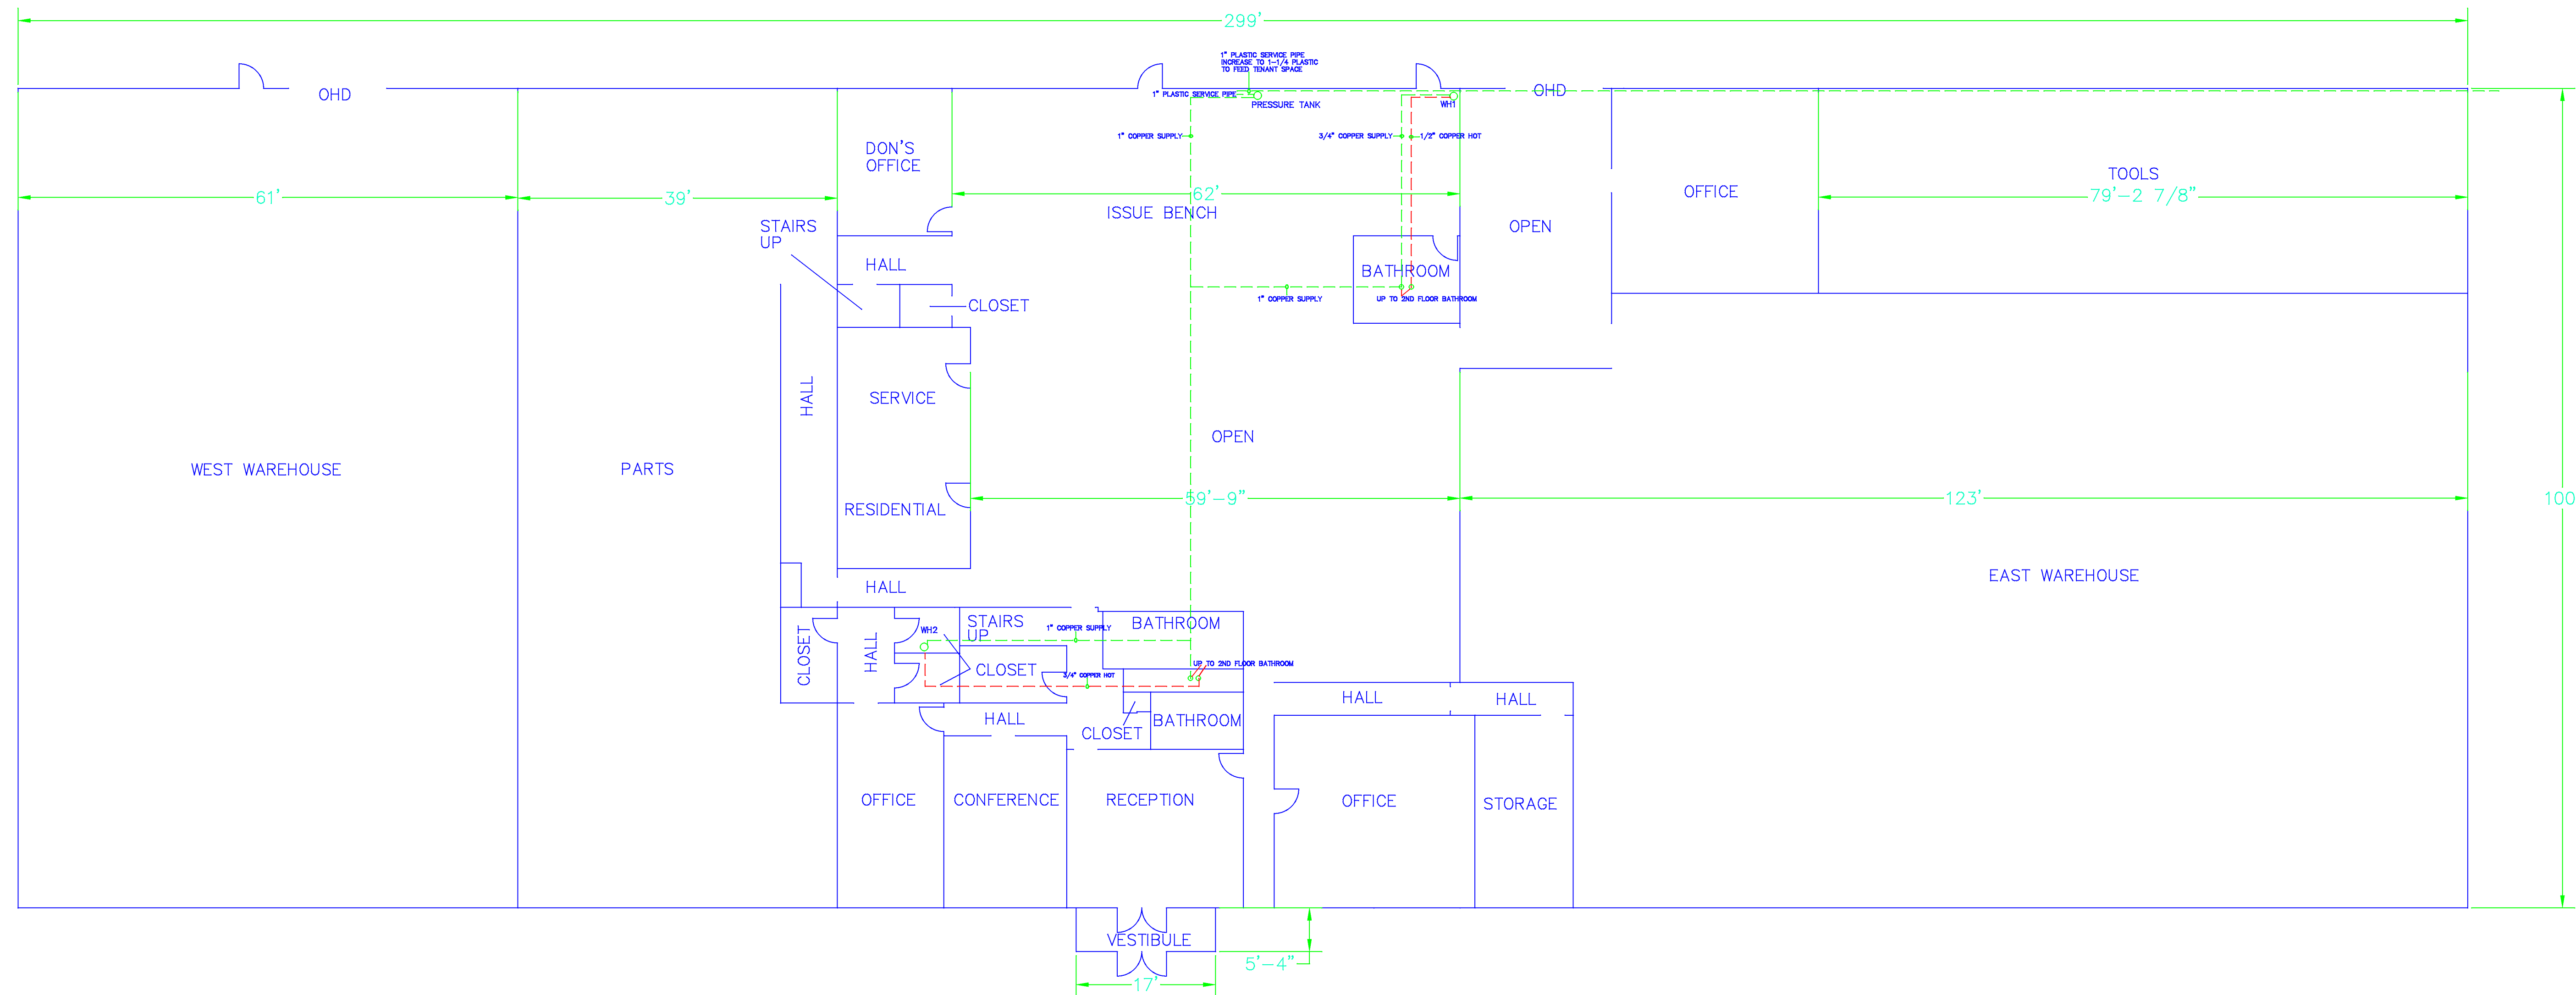


(614) 861-1300
 Fax (614) 861-1830
JESS HOWARD
ELECTRIC COMPANY
 6630 TAYLOR ROAD
 BLACKICK, OHIO 43004
 MEMBER OF ABC
 OH LICENSE #1590

REVISIONS	
NO.	DATE:

JESS HOWARD BLDG.
1ST FLOOR

DRAWING TITLE
FIRST FLOOR
 SCALE: 3/32"=1'
 DATE: 12/29/14
 DRAWN BY: MD

DRAWING NUMBER	
FILE NAME	
JOB NUMBER	
SHEET	OF
1	

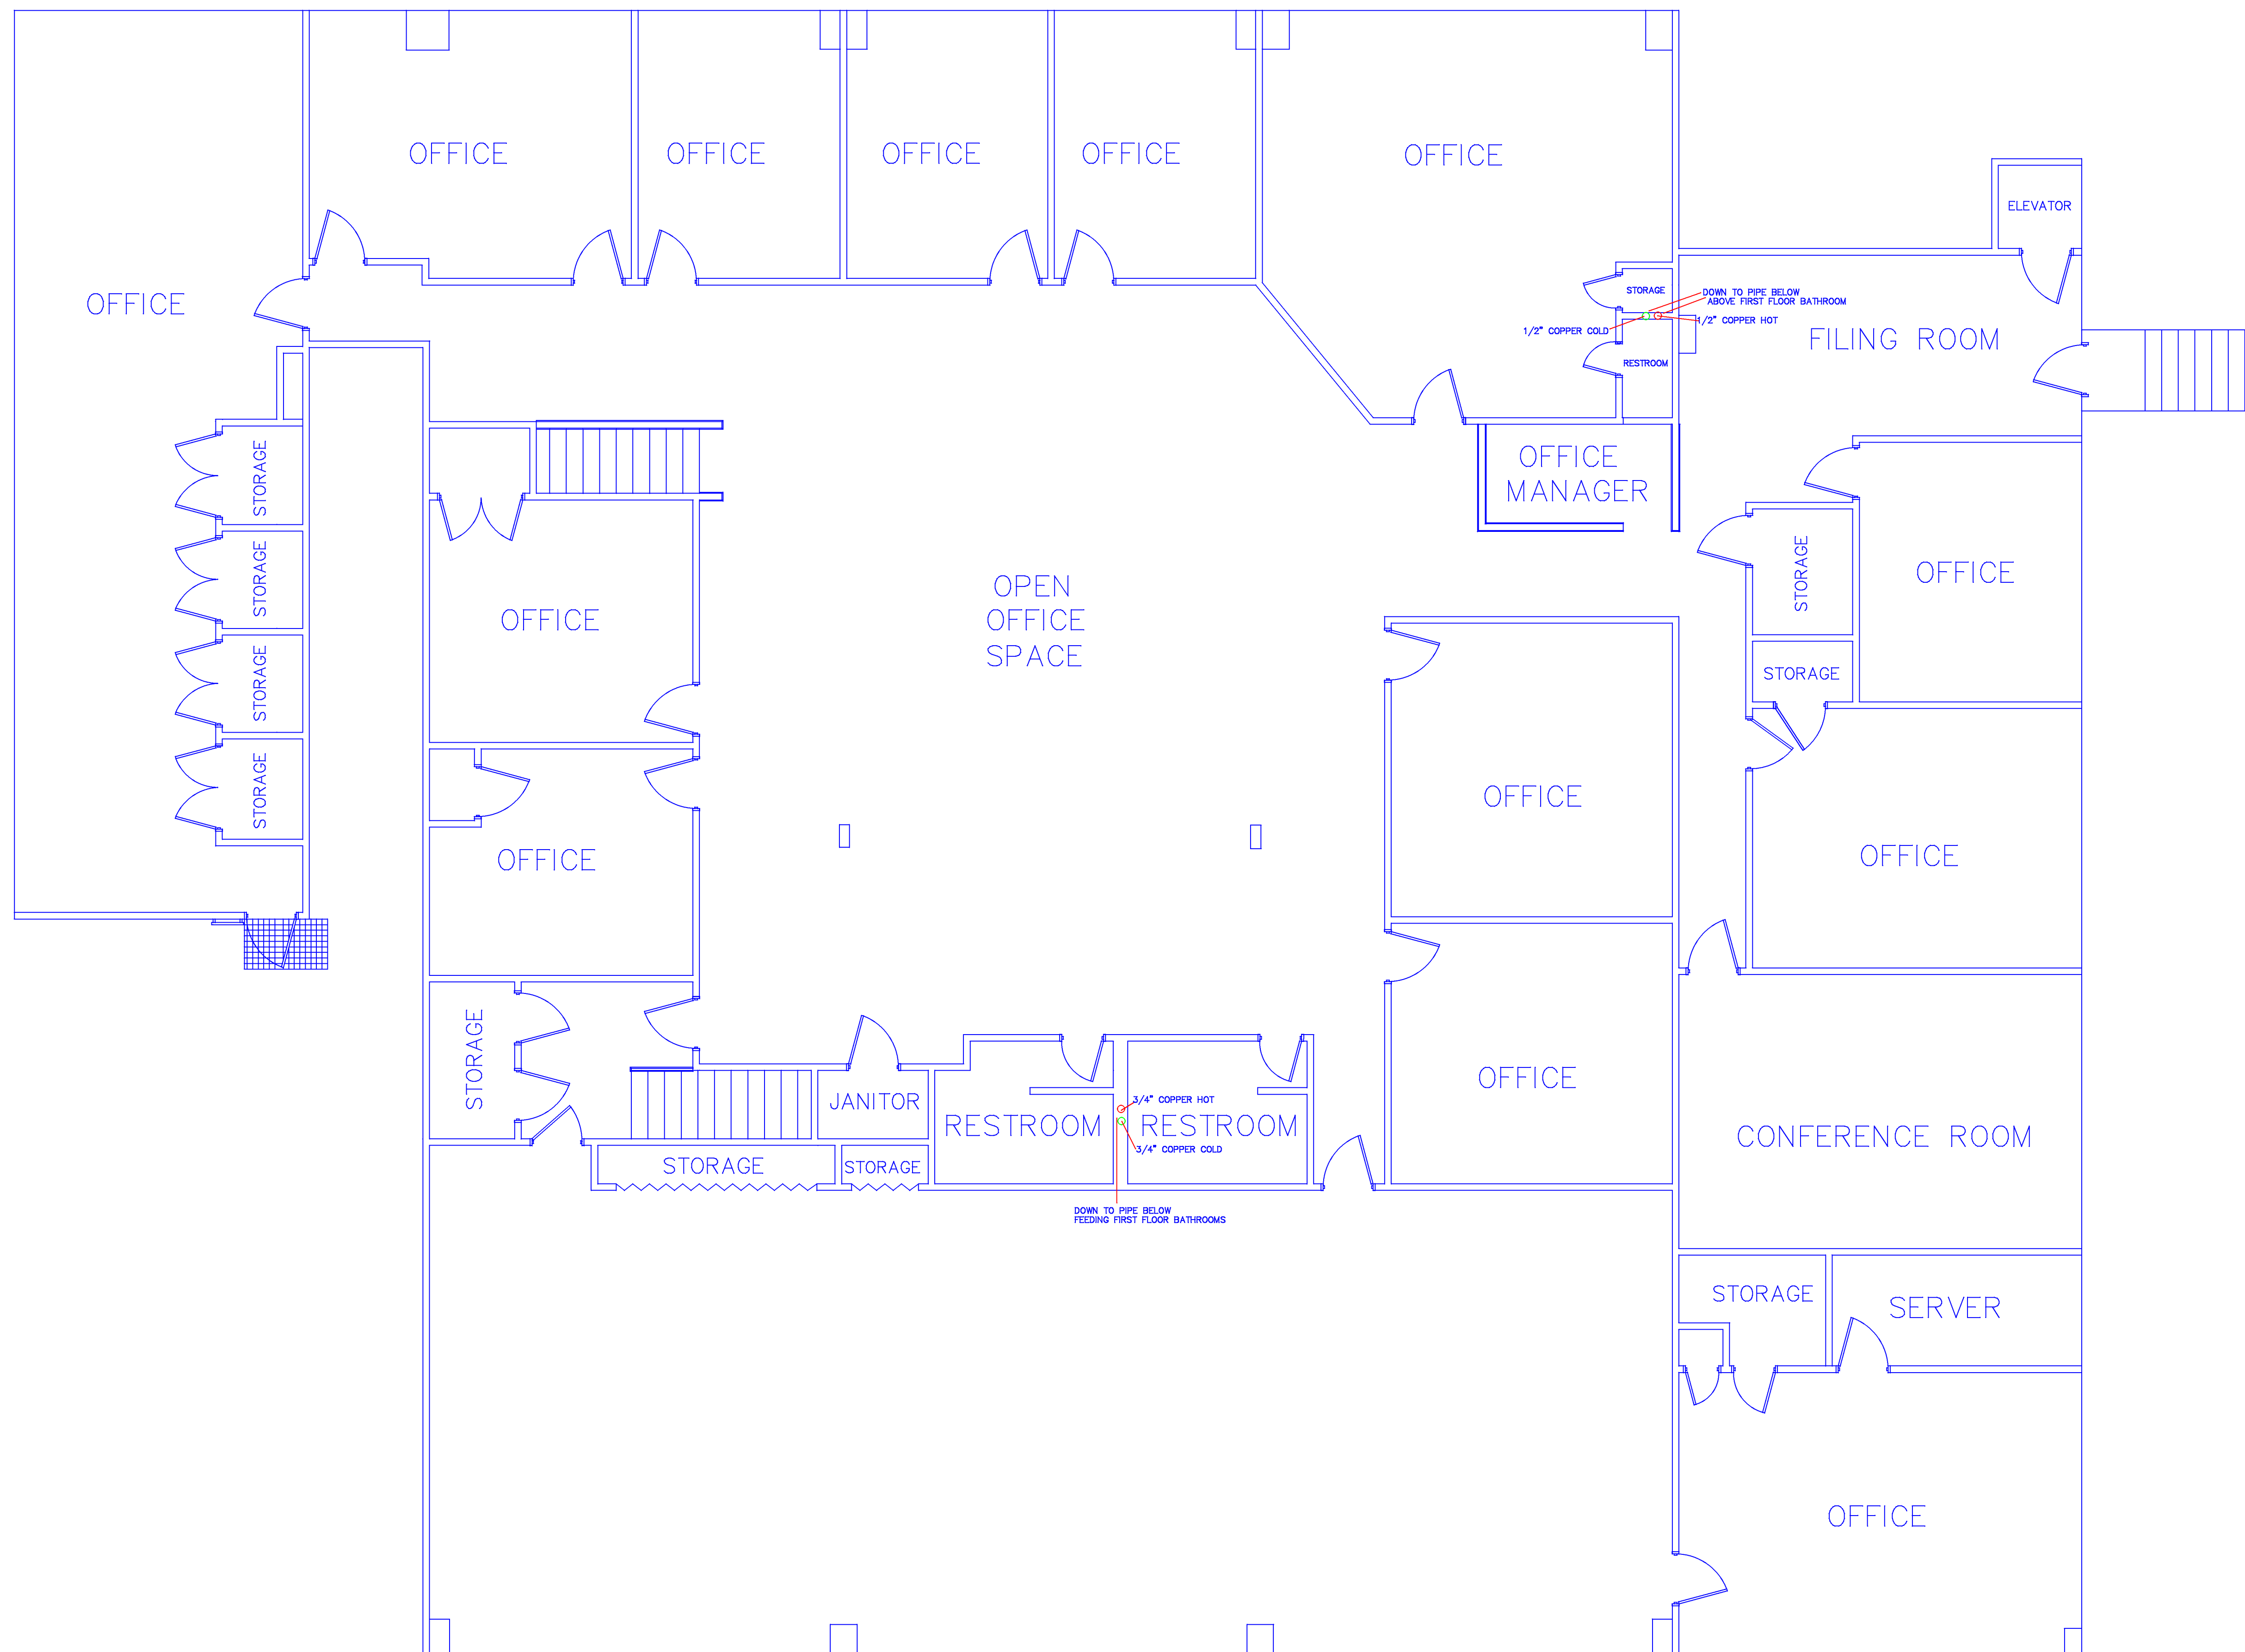

(614) 861-1300
 Fax (614) 861-1830

JESS HOWARD
 ELECTRICAL COMPANY
 6630 TAYLOR ROAD
 BLACKICK, OHIO 43004

MEMBER OF ABC
 OH LICENSE #1590

REVISIONS	
NO.	DATE:

DRAWING TITLE

2ND FLOOR

SCALE: 3/16"=1'

DATE: 12/30/14

DRAWN BY: MD

DRAWING NUMBER

FILE NAME

JOB NUMBER

SHEET OF

A1