


Sutphen Corporation  
4450 E. Terman Rd  
Dublin OH 43016

PWS ID: OH 2545512

Contact Lee Dearth 614 889-1005

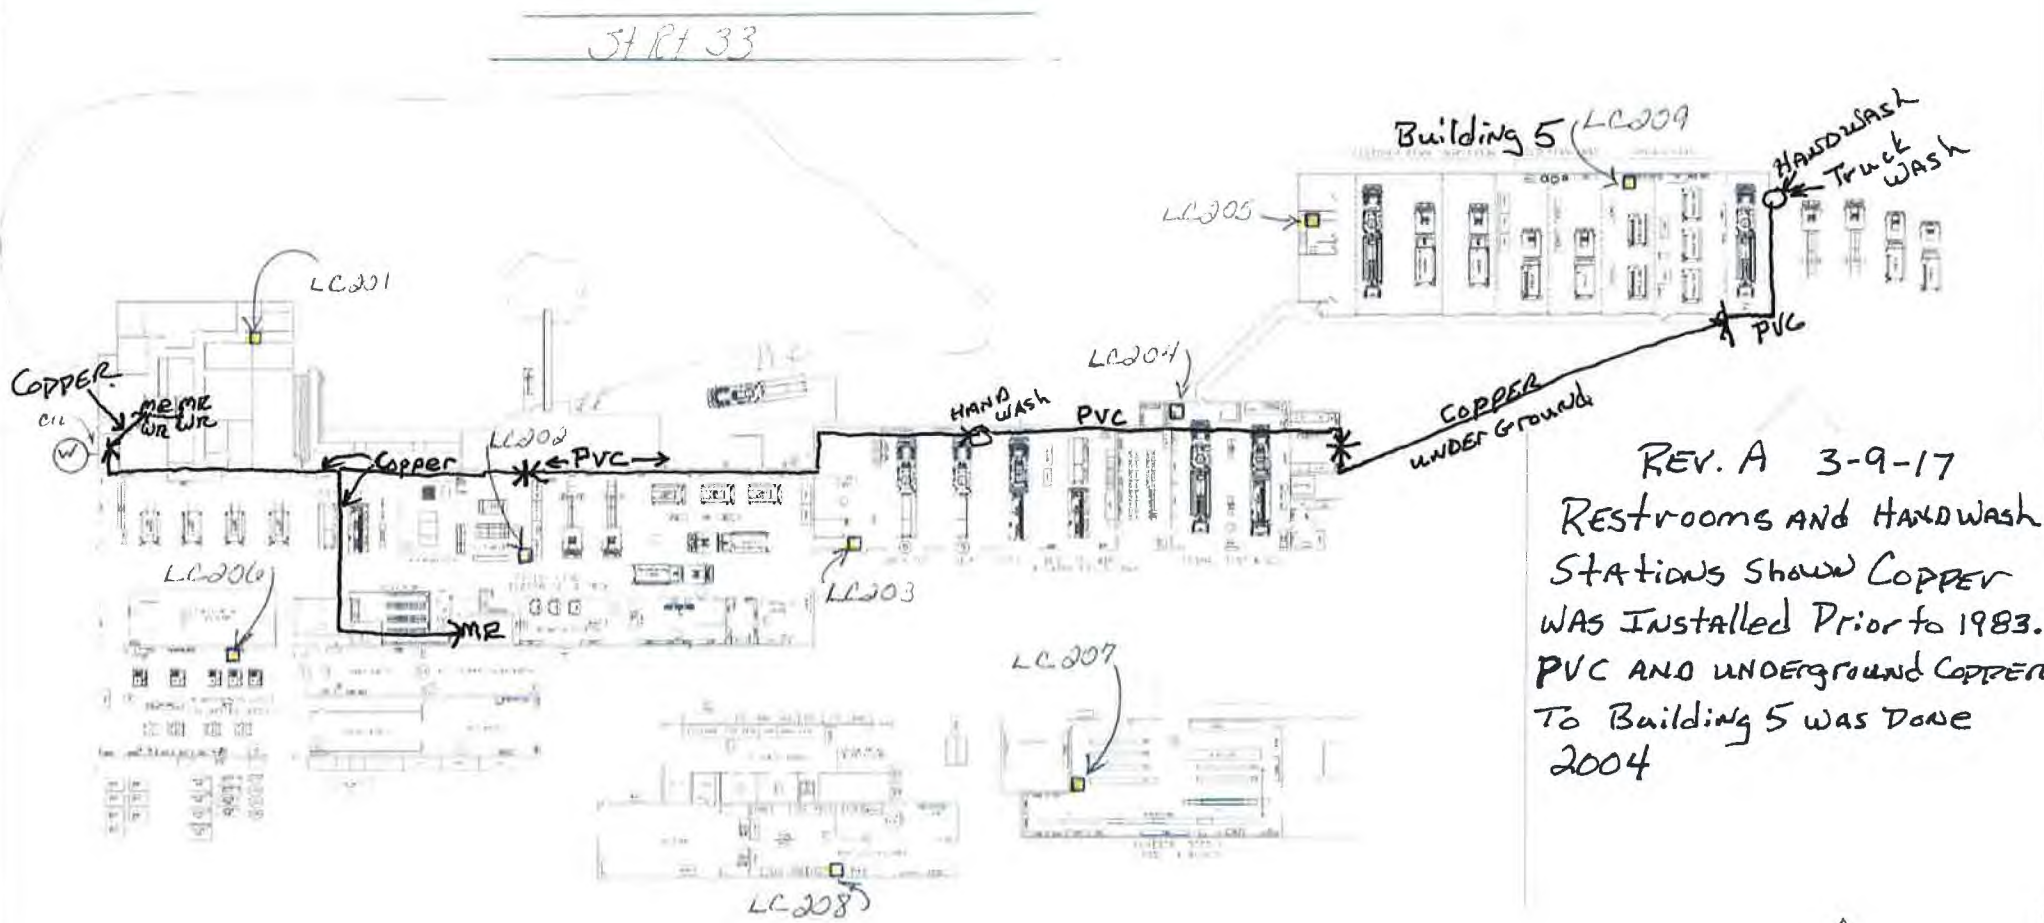

REV. A 3-9-17  
RESTROOMS AND HANDWASH  
STATIONS SHOW COPPER  
WAS INSTALLED PRIOR TO 1983.  
PVC AND UNDERGROUND COPPER  
TO BUILDING 5 WAS DONE  
2004

Water lines are cupb < 83. SMP's LC201 through LC209 are LEAD FREE POLDS  
service line from well is copper. NYLON TUBE w/ NYLON CONNECTIONS.

There are no lead lines in this system.

"Buildings in Ohio built prior to 1998 or that use plumbing material or solder manufactured before 1998 may have materials with greater than 8% lead and are at a higher risk of contributing lead to the drinking water than materials manufactured after 1998. In addition, building built and plumbing material manufactured after 2014 were required to have less than 0.25% lead by weight and have the lowest risk for contributing lead to the drinking water. It should be noted however that, although prohibited, some use of leaded solder or leaded components may have occurred after the prohibitions became effective."

