

SITALOM UMC
FAMILY LIFE CENTER
WAS CONSTRUCTED 2006

CONNECTOR
TO
CHURCH

GYM

ENTRANCE

KITCHEN

LIBRARY

CLASSROOM

CLASS ROOMS

STATE RT 33

SERVICE LINES - GREEN
COLD WATER - BLUE
HOT WATER - RED

PRESSURE TANK
GREEN SAND
HOT WATER TANK
COPPER PIPE FROM HERE

MAINTENANCE ROOM

MENS R.R.

WOMENS R.R.

POLY PIPE
UNDERGROUND

WELL 2006

N
W
E
S

STATE RT 33

10 CARRULL, OH.

PLUM RD.

4925 PLUM RD.
CARROLL OH 43112
OH 2348012


740-756-4855

SHALOM UNITED METHODIST CHURCH
WAS CONSTRUCTED IN 1987

SANCTUARY

BUILT
1987

N
↑
E
S

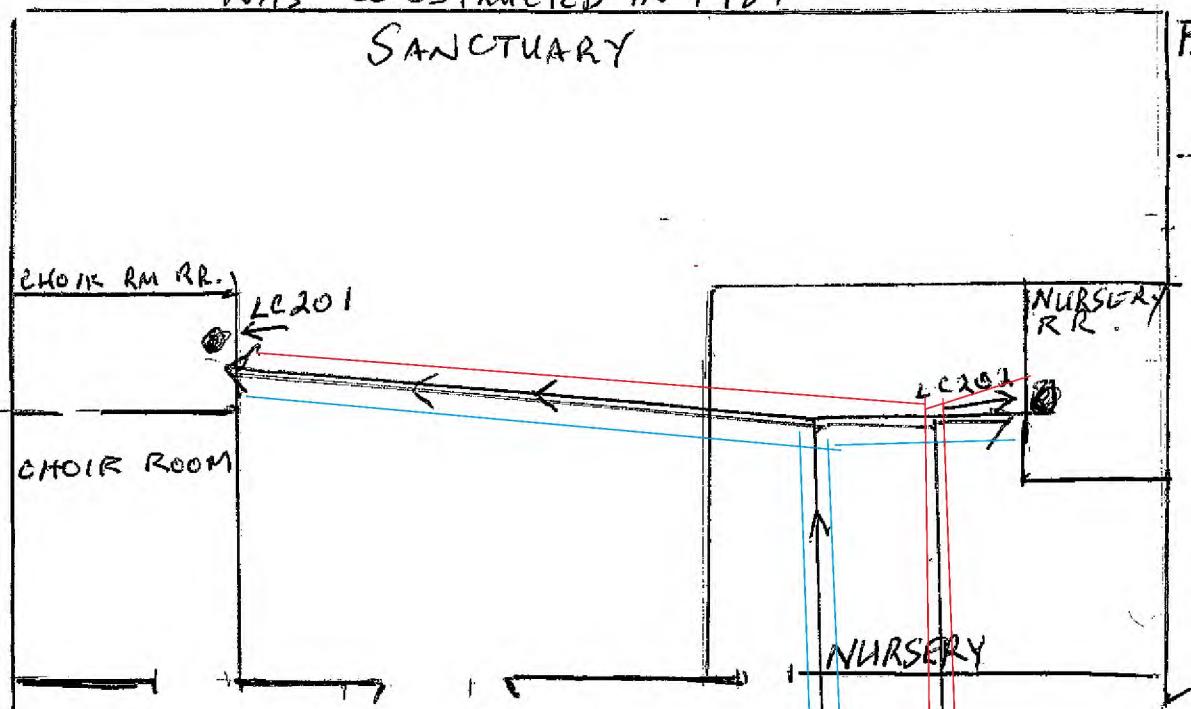

CLASS ROOMS & OFFICES


SERVICE LINE - POLY
INTERIOR LINES - ALL
1986-2014 COPPER

SERVICE Lines - GREEN
COLD WATER - BLUE
HOT WATER - RED

SAMPLE SITES -

- LC 201 CHOIR ROOM
- LC 202 NURSERY
- LC 203 KITCHEN HAND SINK
- LC 204 MENS R.R.
- LC 205 WOMENS R.R.

← TO FAMILY LIFE CTR

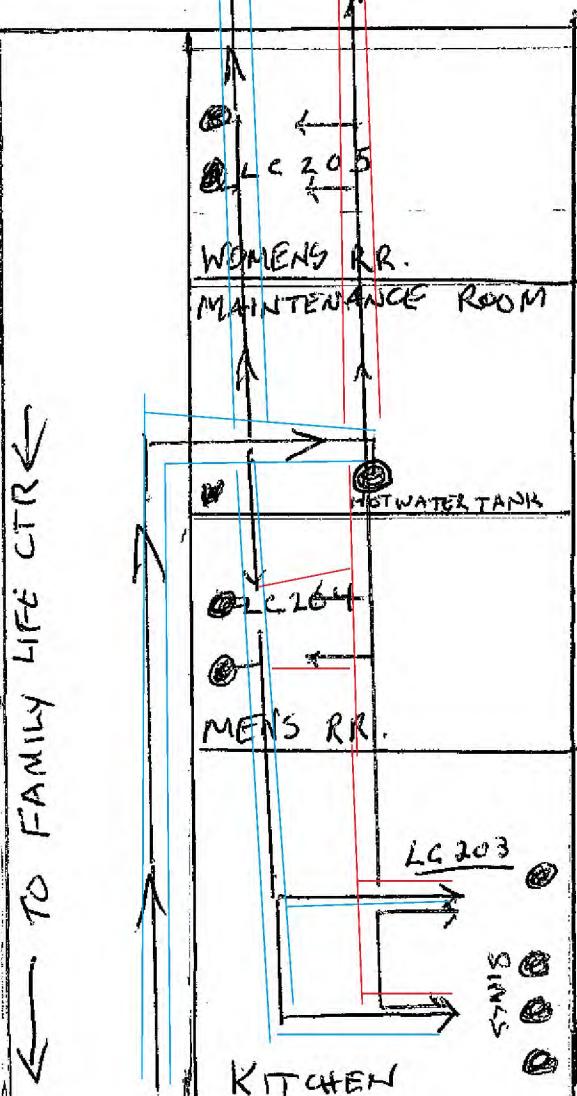

Shalom UMC Lead Mapping

ShalomUMC, 4925 Plum Rd., Carroll, Ohio, 43112, 740-756-4855

PWS ID OH2348012

- A) Water Well (approved by EPA 28 August 2006)**
- B) Service line to point of entry (polyethelene pipe)**
- C) Copper pipe throughout from this point.**
- D) Water travels through pressure tank, four greensand filter tanks
then through hot water tank and is distributed throughout the
Family Life Center (constructed 2006).**
- E) Through connecting hallway to church maintenance room hot water
tank & distributed throughout the church bldg. (constructed 1987).
All pipe & plumbing fixtures are copper with solder (1986-2014)
No lead lines. No lead violations on file.**

Submitted by Gary Collins (WSA-1112015)