

RE: EASTWOOD HIGH SCHOOL
Report
Drinking Water Program
Wood County
PWS ID: OH8742912

Narrative description of Building Characteristics for Eastwood Local School District

These maps were comprised of data based on the construction dates of the buildings. And those buildings built prior to 1998 or that use plumbing material or solder manufactured before 1998 may have materials with greater than 8% lead and are at a higher risk of contributing lead to the drinking water than materials manufactured after 1998. In addition, buildings built and plumbing materials manufactured after 2014 were required to have less than 0.25% lead by weight and have the lowest risk for contributing lead to the drinking water. It should be noted however that, although prohibited, some use of leaded solder or leaded components may have occurred after the prohibitions became effective.

RECEIVED

MAR 08 2017

OHIO E.P.A.
N.W.D.O.

OH 8742912
Eastwood HS

Eastwood Local Schools Main Campus



FANNING-HOWEY
800.635.1911 www.fhai.com

RECEIVED
MAR 02 2017
FANNING-HOWEY ASSOCIATES, INC.



EASTWOOD NEW PK-5
ELEMENTARY SCHOOL
4800 SUGAR RIDGE RD
EASTWOOD LOCAL SCHOOLS

COPYRIGHT BY FANNING-HOWEY ASSOCIATES, INC.

MASTER SITE PLAN	
DRAWN BY: JAF	CHECKED BY: JAF
CREATED BY: JAF	DATE: 2/29/2017
REVISIONS NO.	DATE
A1.0	

EASTWOOD NEW PK-5 ES
215018.00


Sheet 1
Eastwood High School
Id# 8742912
4900 Sugar Ridge Rd Pemberville, OH
419-833-3611

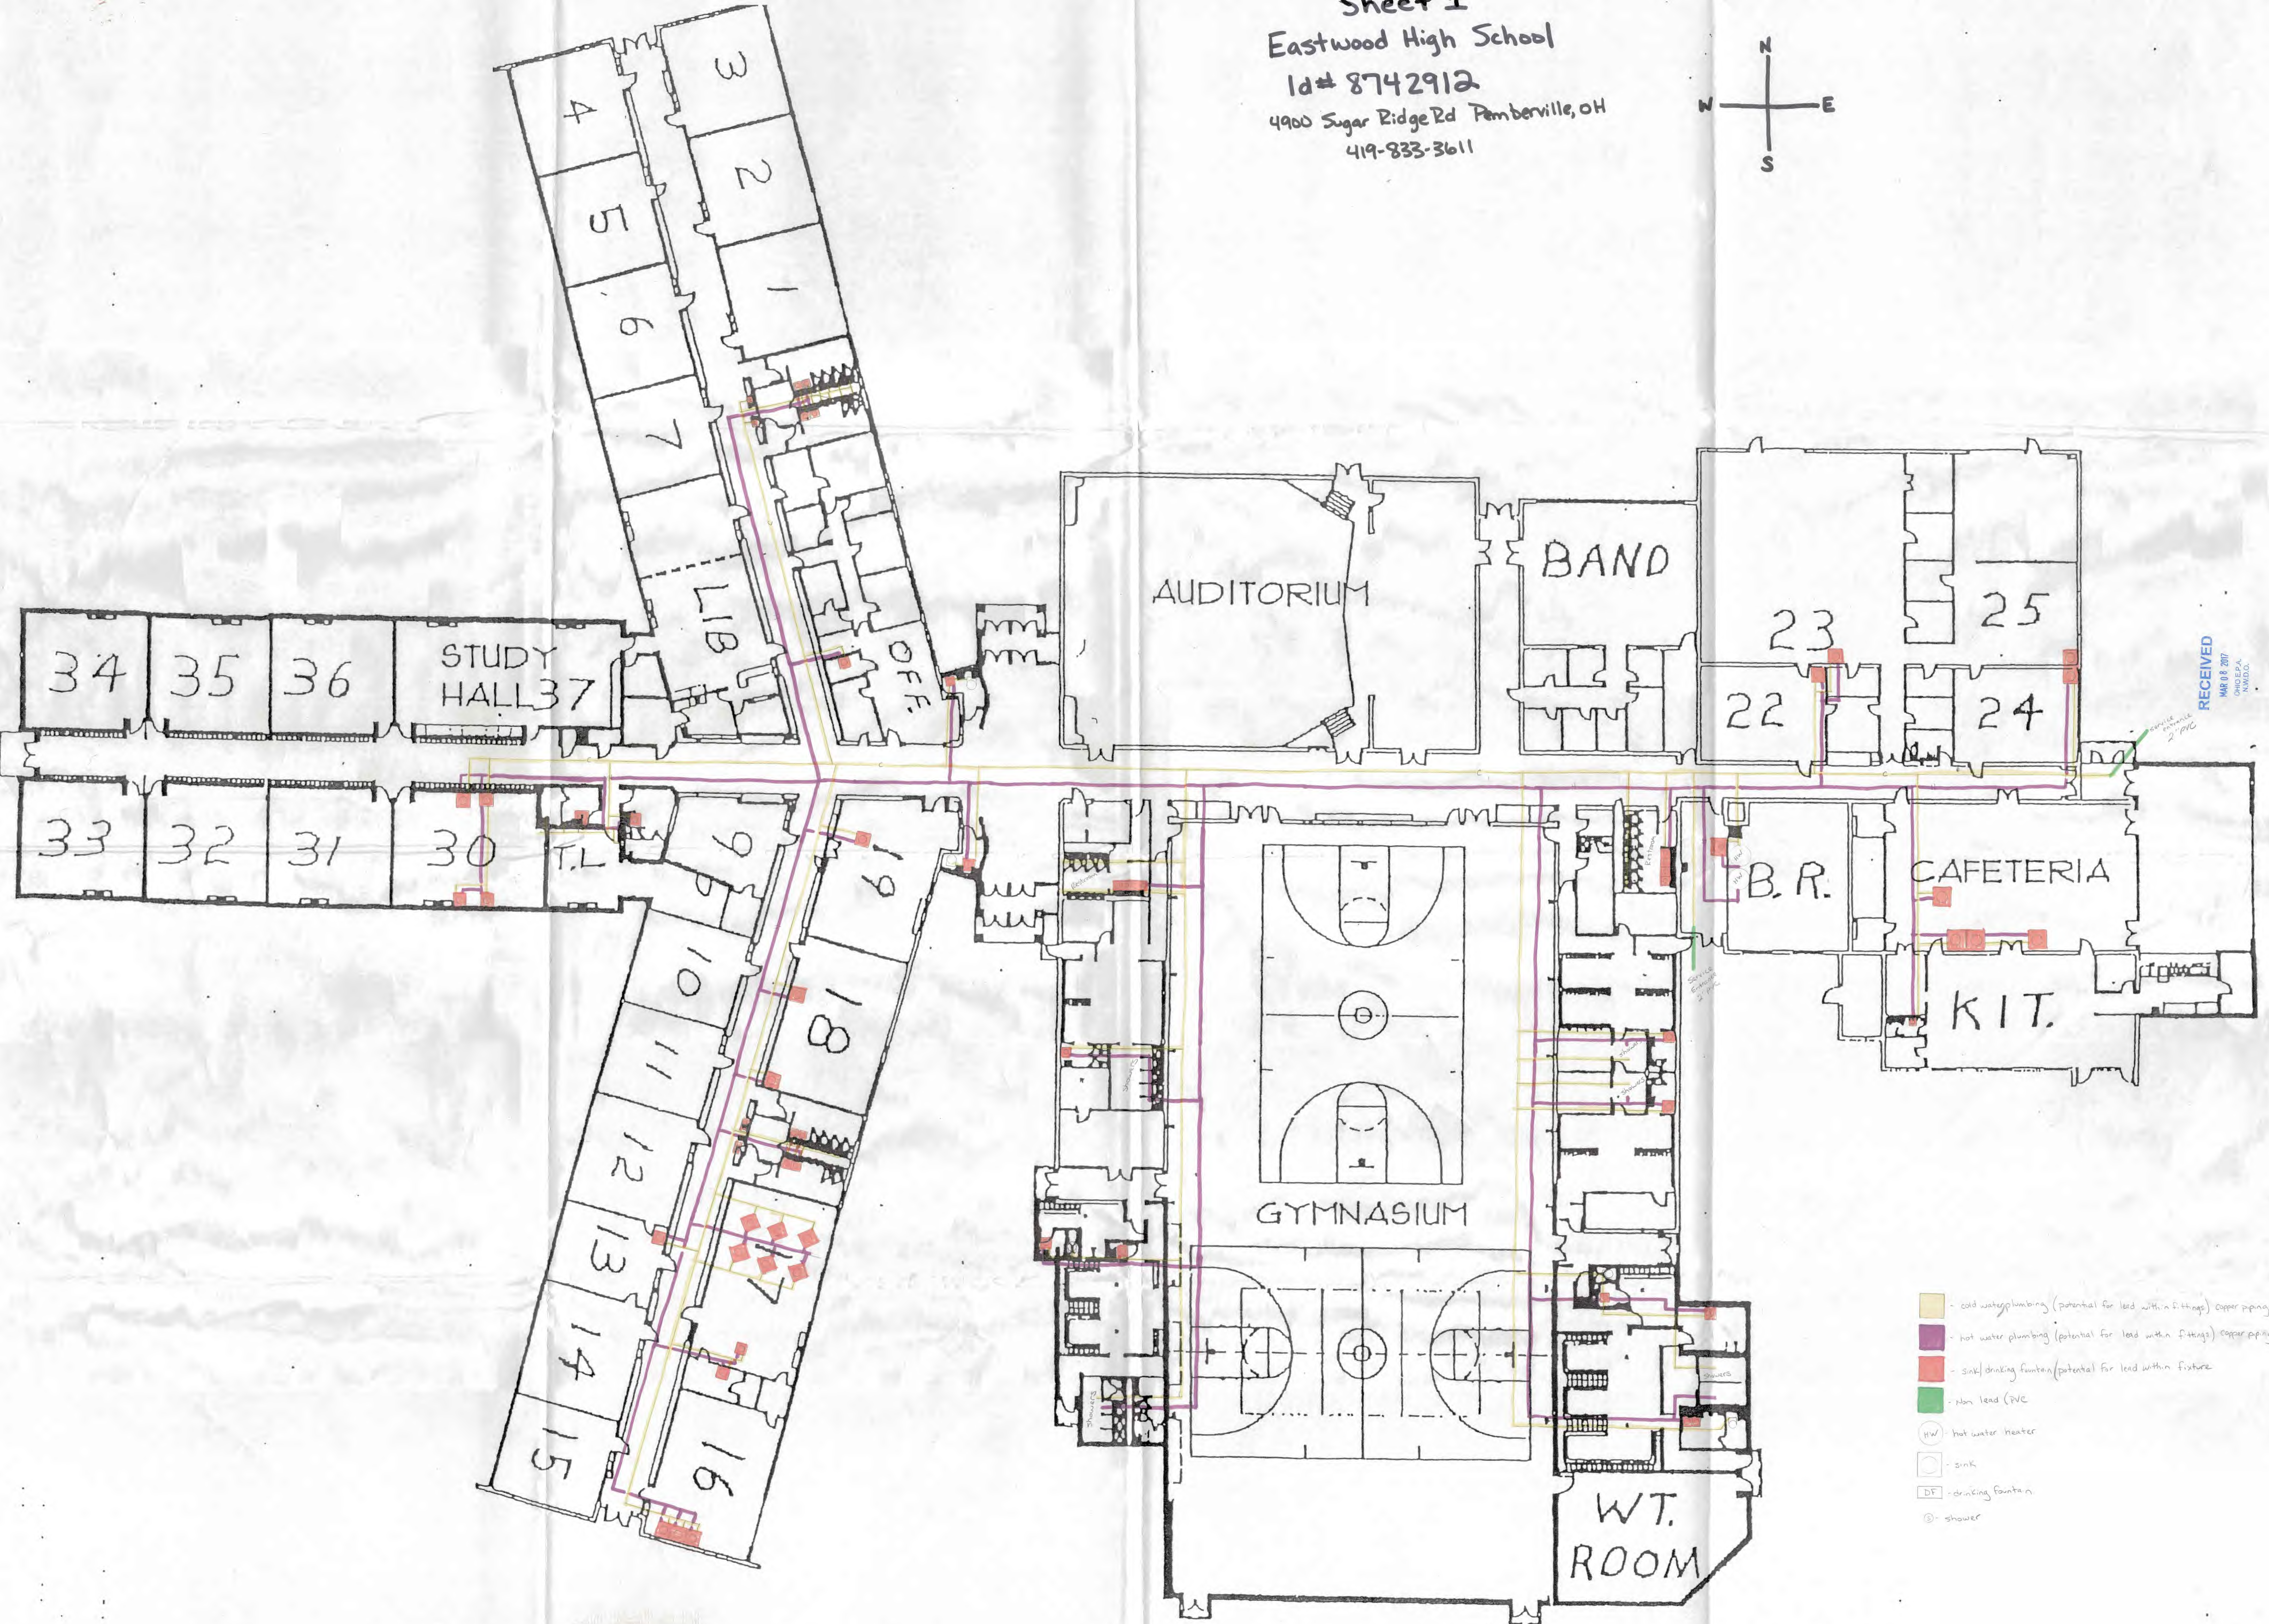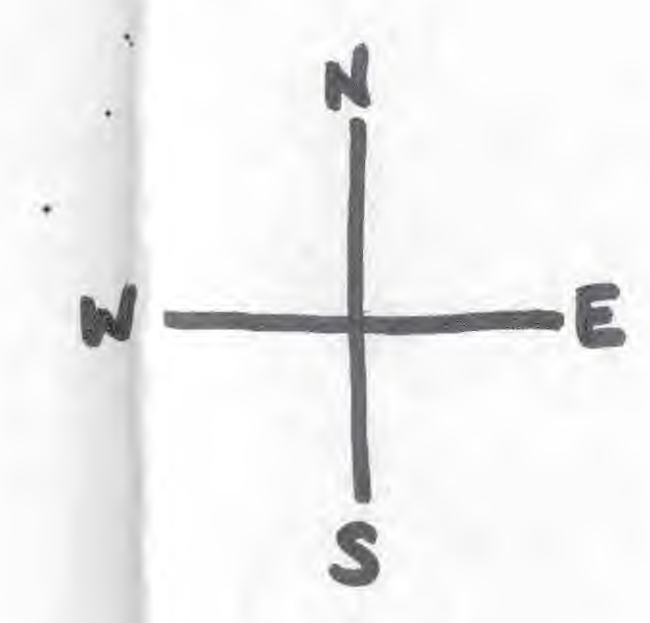

RECEIVED
MAR 08 2017
OHIO EPA
NWD/O

- cold water plumbing (potential for lead within fittings) copper piping
- hot water plumbing (potential for lead within fittings) copper piping
- sink/drinking fountain (potential for lead within fixture)
- non lead (PVC)
- HW - hot water heater
- S - sink
- DF - drinking fountain
- SH - shower

Construction 2014

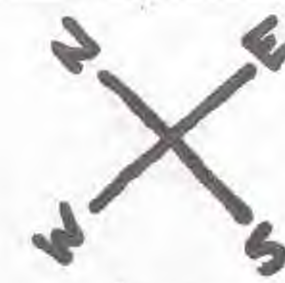

cold plumbing non lead


hot plumbing non lead

sink non lead

Does NOT Latch

Door
114 G

2019-2020

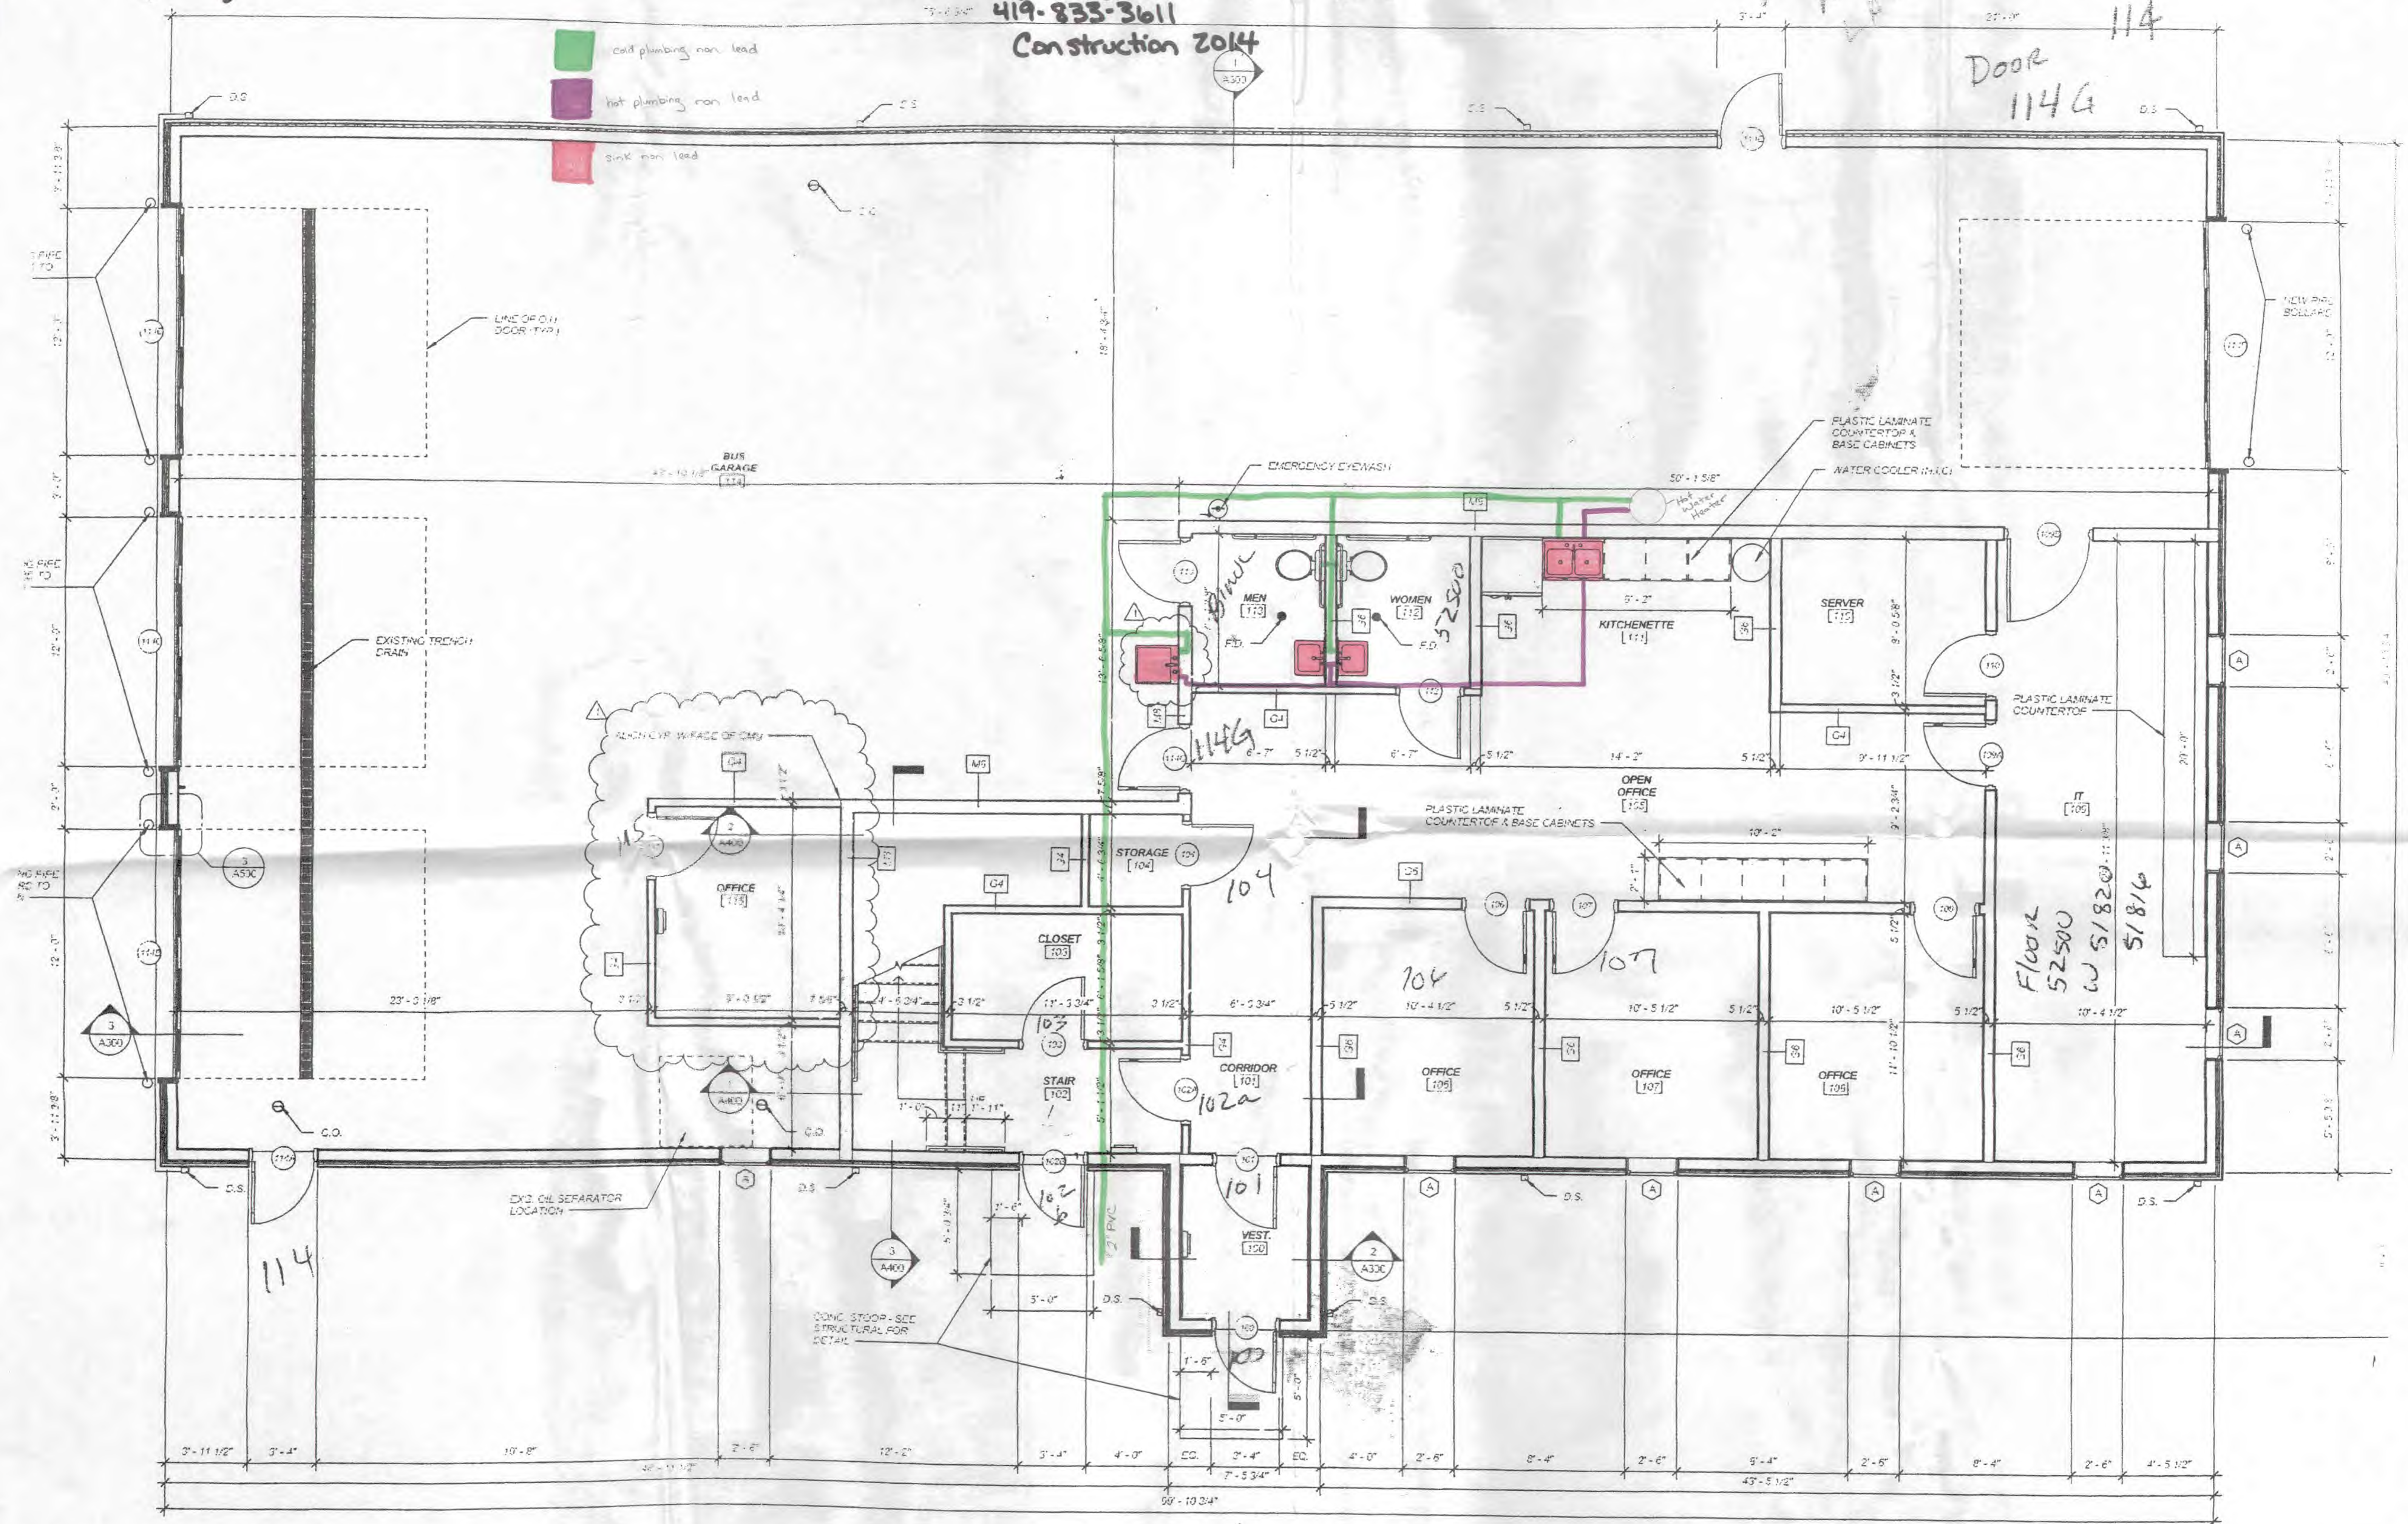

FIRST FLOOR PLAN

$$T_1 A^* = T_1 - Q^*$$

GENERAL NOTES:

1. ALL DIMENSIONS SHOWN ARE TO FACE OF STUD UNLESS NOTED OTHERWISE.
2. CONTRACTOR / SUPPLIER TO MEET WITH OWNER TO CONFIRM DOORS, HARDWARE, FINISHES AND FINISHES PRIOR TO ORDERING.
3. PROVIDE BLOCKING AS REQUIRED TO SECURE WALL MOUNTED COUNTERS, CABINETS, EQUIPMENT, ETC.
4. ALL GYP. BOARD IN AREAS EXPOSED TO MOISTURE TO BE MOISTURE AND MOLD RESISTANT.

Doug

Rudolph | Libbe

Rudolph/Libbe Inc. 6494 Latcha Road Walbridge, Ohio 43485 419/241-5000

	05/07/14	ADDENDUM NO. 1
	07/22/14	PERMIT DOCUMENTS
NO.	DATE	DESCRIPTION
REVISION		