

**OAKHILL MEDICAL CENTER**  
**4879 U.S. 68 SOUTH**  
**WEST LIBERTY, OH 43357**  
**PH: 937-599-5175**

Ohio Department of Health  
Attn: Lead Program, 6<sup>th</sup> Floor  
246 North High Street  
Columbus, OH 43215

1-26-2016


Please find the enclosed mapping for the Medical Office located at the above address. We are a Nontransient Noncommunity PWS. The original office was constructed in 1995 with a major remodel and addition in 1995. The service line coming from the well is labeled "Other" and lines going to the fixtures are copper. I have been completing lead and copper testing every 3 years and to date have had results well below the minimum. If this mapping does not satisfy the requirements please let me know.

Sincerely,



Arlis Gascho  
Oakhill Medical Center

UPPER LEVEL

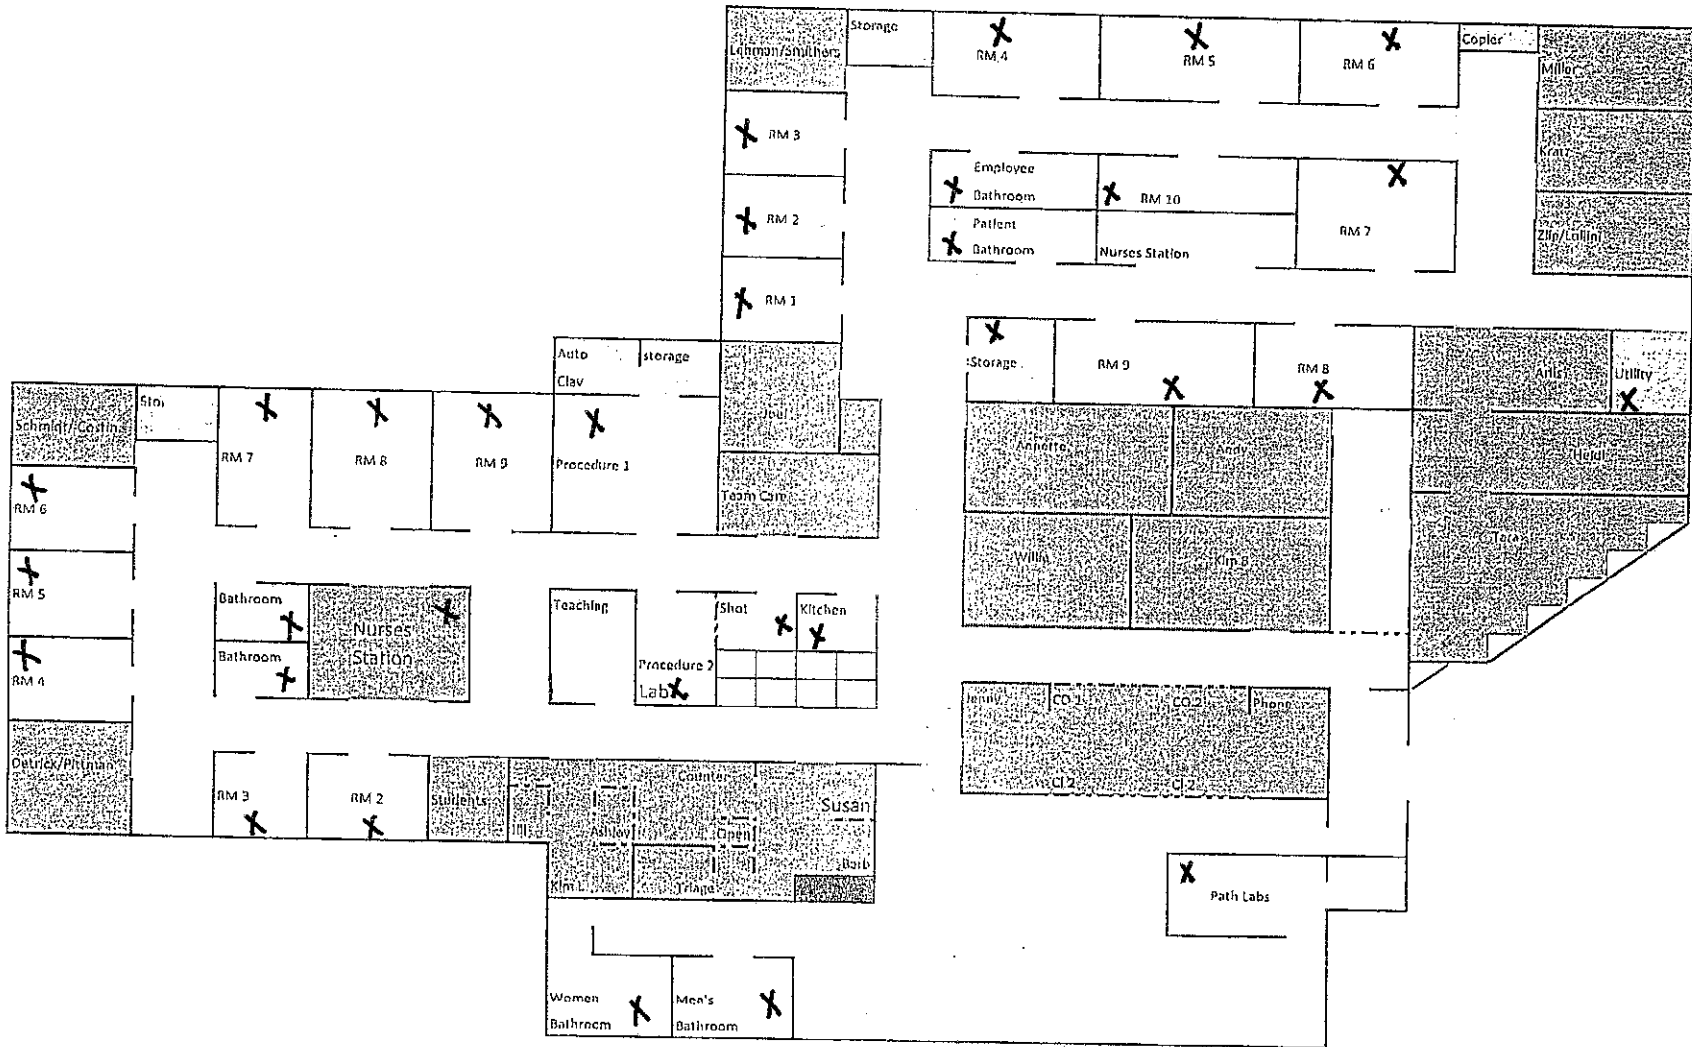

X copper lines to fixtures

**OAKHILL MEDICAL CENTER**  
**4879 U.S. 68 SOUTH**  
**WEST LIBERTY, OH 43357**  
**PH: 937-599-5175**


Ohio Department of Health  
Attn: Lead Program, 6<sup>th</sup> Floor  
246 North High Street  
Columbus, OH 43215

1-26-2016

Please find the enclosed mapping for the Medical Office located at the above address. We are a Nontransient Noncommunity PWS. The original office was constructed in 1965 with a major remodel and addition in 1995. The renovation in 1995 included new plumbing throughout the building. The plumbing materials used in 1995 fit the time period between 1986 and 2014 when lead solder was banned and there was lower content of lead in brass. The service line coming from the well is labeled "Other" and lines going to the fixtures are copper. I have been completing lead and copper testing every 3 years and to date have had results well below the minimum. If this mapping does not satisfy the requirements please let me know.

Sincerely,

Arlis Gascho  
Oakhill Medical Center

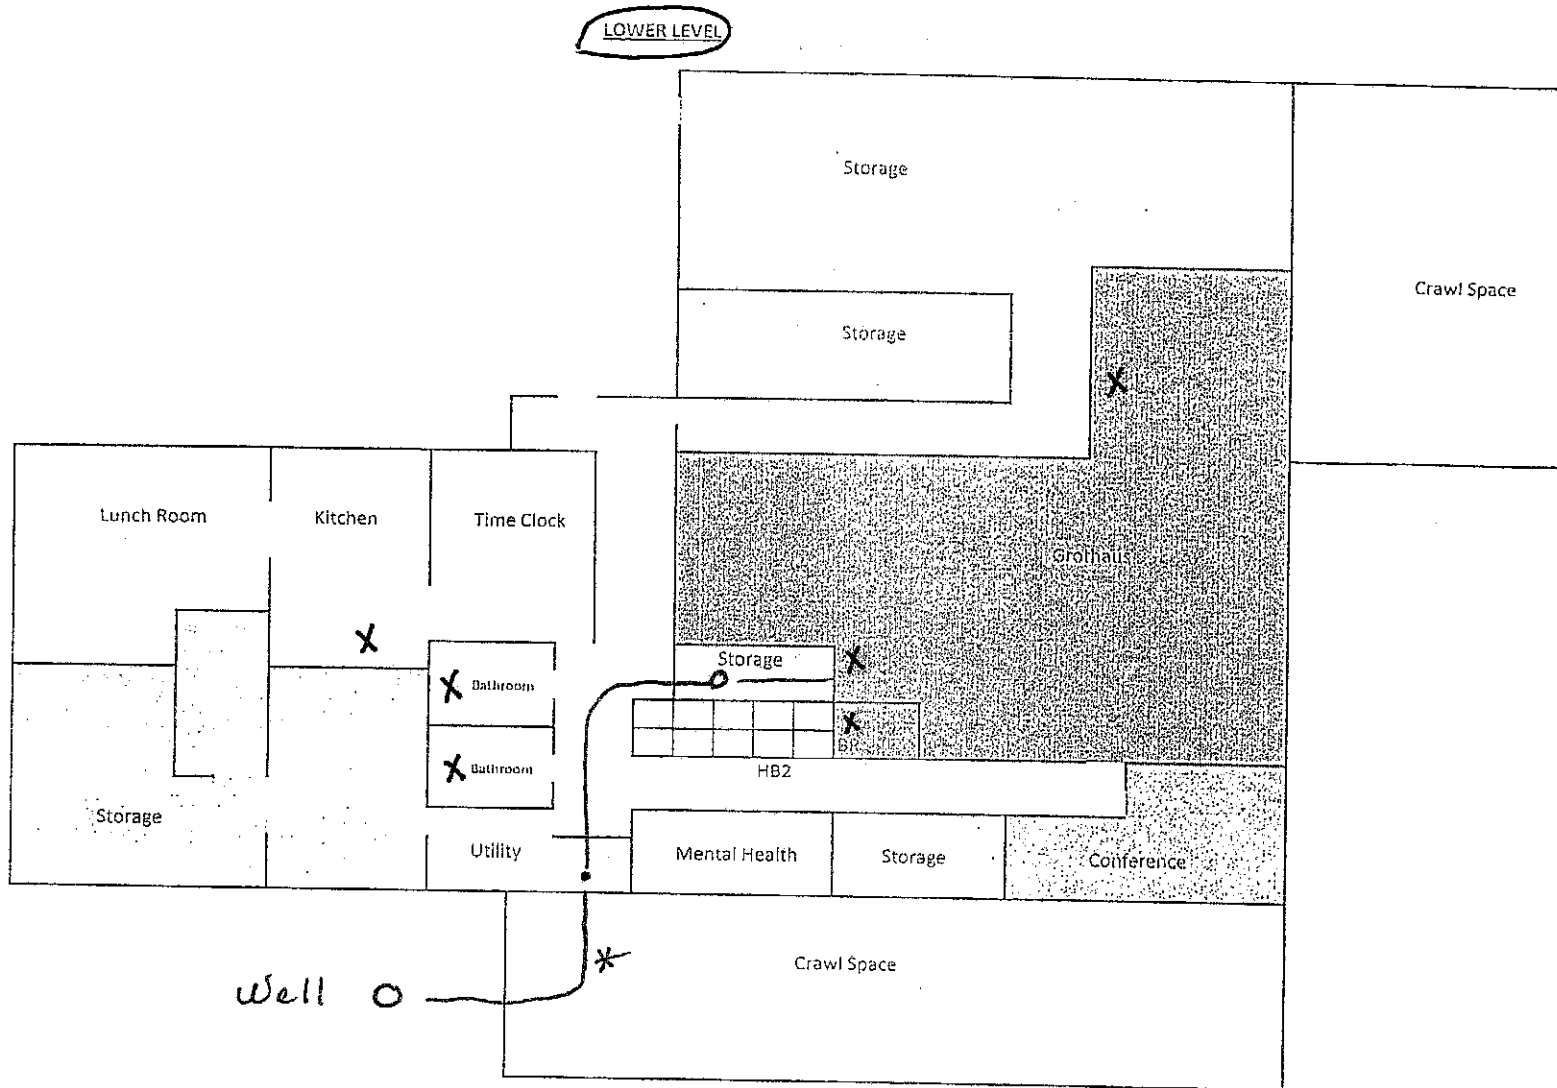

\* service line from well "Other"  
X copper lines to fixtures