


2017

C

N

Benjamin Logan High School
 6609 ST RT 47 East
 Bellefontaine Ohio 43311
 Permit # 4643912
 PH # (937) 592-1666
 Building built in 1989

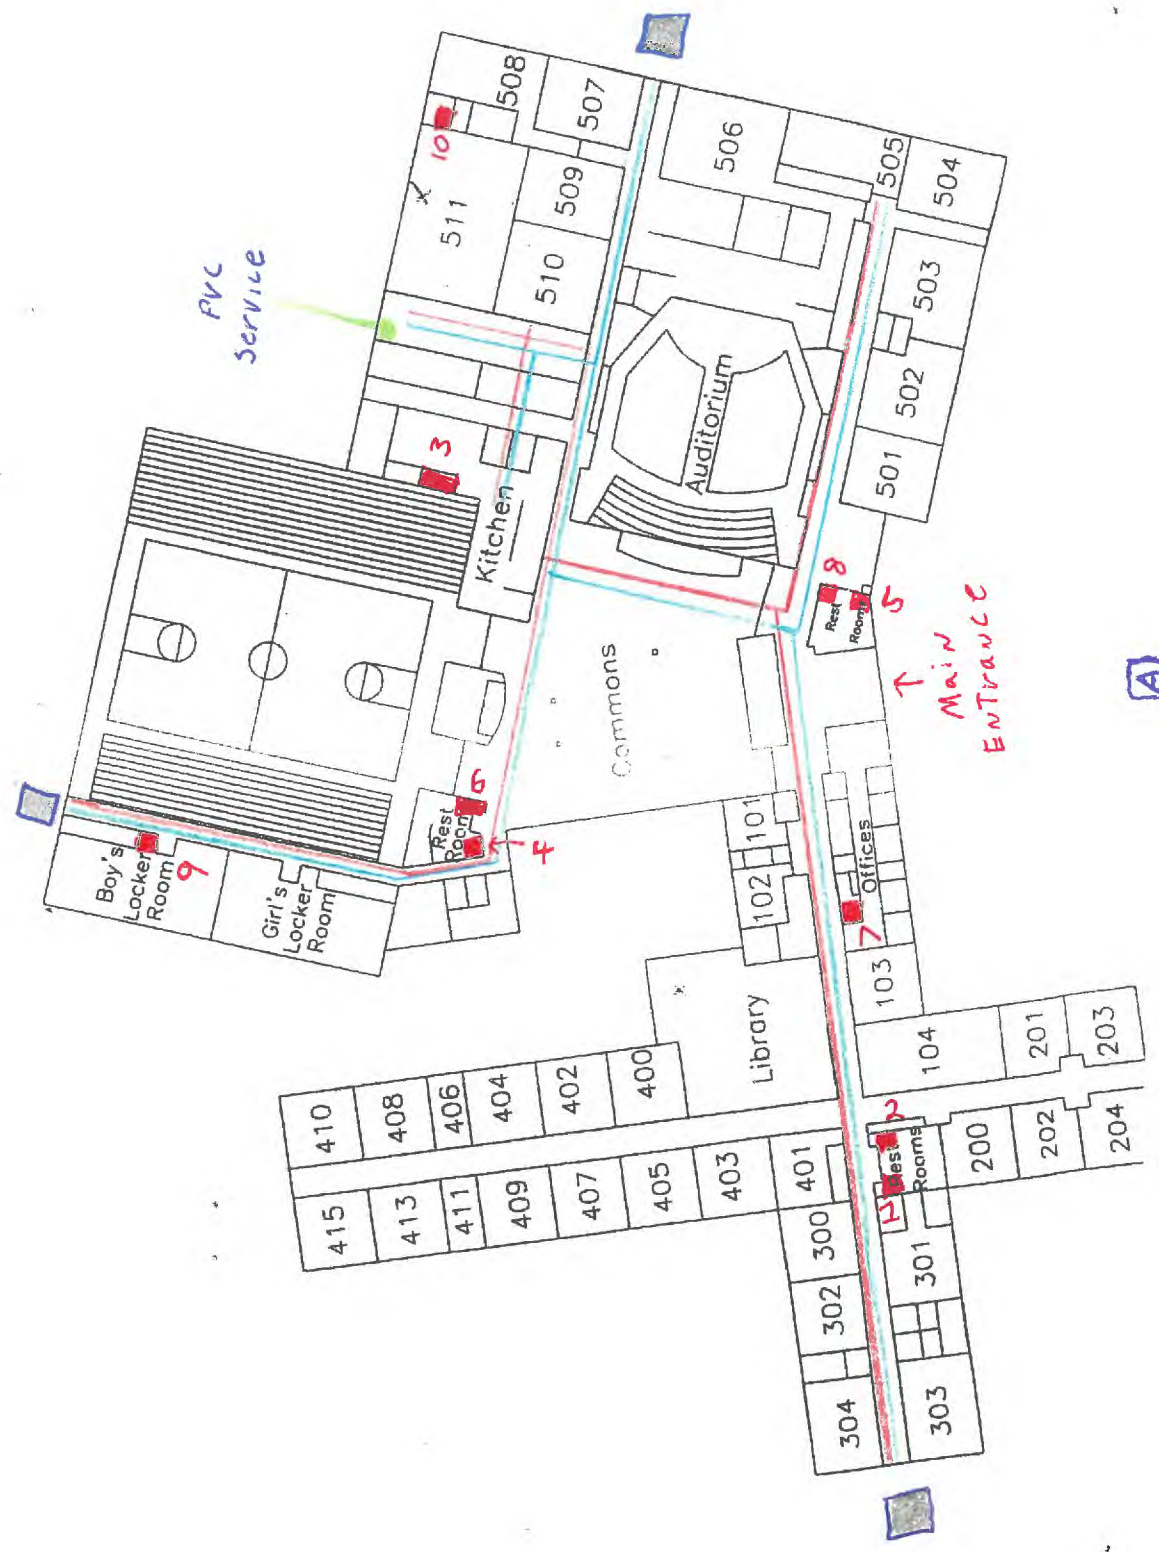

B

A

BENJAMIN LOGAN HIGH SCHOOL LEAD & COPPER 2017

1. PERMIT # 4643912 BUILDING WAS BUILT IN 1989
2. ALL INSIDE POTABLE WATER LINES ARE COPPER WITH SOLDERED JOINTS
3. ALL FIXTURES ARE STAINLESS & BRASS
4. IN 2010 & 2011 WE REPLACED THE DRINKING FOUNTAINS
5. WE HAVE NO DOCUMENTATION ON THE TYPE OF SOLDER USED IN BUILDING COSTRUCTION AS IT WAS BUILT IN 1989 HOWEVER WE BELIVE ITMAY BE 8% OR HIGHER IN LEAD CONTENT.

TIER 1 SAMPLE SITES

1. BOYS RESTROOM QUAD
2. GIRLS RESTROOM QUAD
3. KITCHEN RESTROOM
4. GIRLES RESTROOM COMMONS
5. GIRLES RESTROOM AUDITORIUM
6. BOYS RESTROOM COMMONS
7. SICK ROOM
8. BOYS RESTROOM AUDITORIUM
9. BOYS RESTROOM SHOWER ROOM
10. AG SHOP RESTROOM