
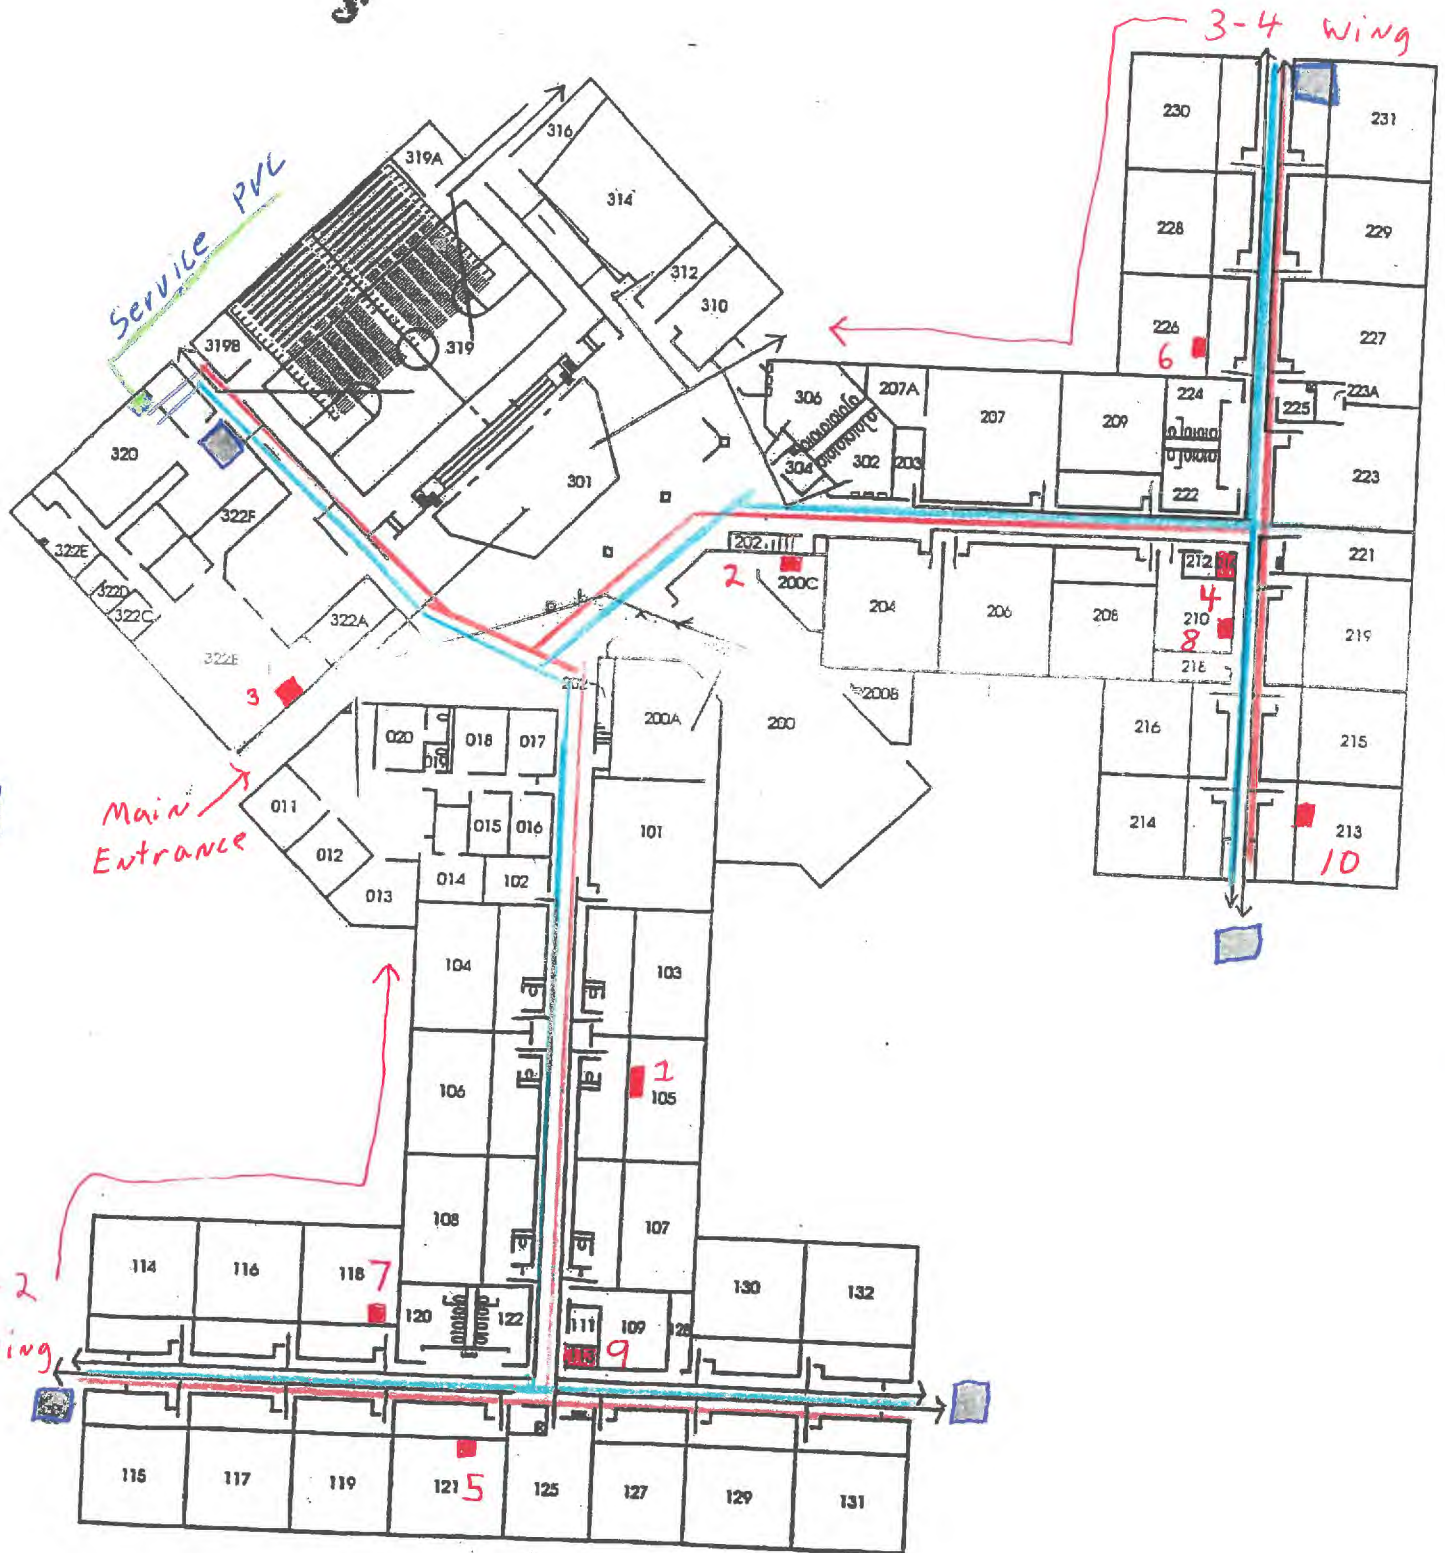


2017

[B]

Benjamin Logan Elementary School
4560 CR 26 Bellefontaine Ohio 433
Permit # 4645912
PH# (437) 592-4838
Building Built in 1994

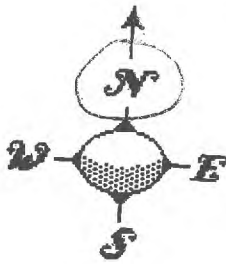

[A]

[C]

[D]

BENJAMIN LOGAN ELEMENTARY SCHOOL LEAD & COPPER 2017

1. PERMIT # 4645912 BUILDING WAS BUILT IN 1994
2. ALL INSIDE POTABLE WATER LINES ARE COPPER WITH SOLDERED JOINTS
3. ALL FIXTURES ARE STAINLESS & BRASS
4. IN 2012 & 2013 WE REPLACED THE DRINKING FOUNTAINS
5. WE HAVE NO DOCUMENTATION ON THE TYPE OF SOLDER USED IN BUILDING CONSTRUCTION AS IT WAS BUILT IN 1994 HOWEVER WE BELIEVE IT MAY BE 8% OR HIGHER IN LEAD CONTENT.

TIER 1 SAMPLE SITES

1. ROOM 105
2. LIBRARY
3. KITCHEN
4. GIRLES RESTROOM STAFF 3-4 WING
5. ROOM 121
6. ROOM 226
7. ROOM 118
8. ROOM 210
9. GIRLES RESTROOM STAFF 1-2 WING
10. ROOM 213