


RE: OAKWOOD MHP  
Report  
Drinking Water Program  
Williams County  
PWS ID: OH8601212





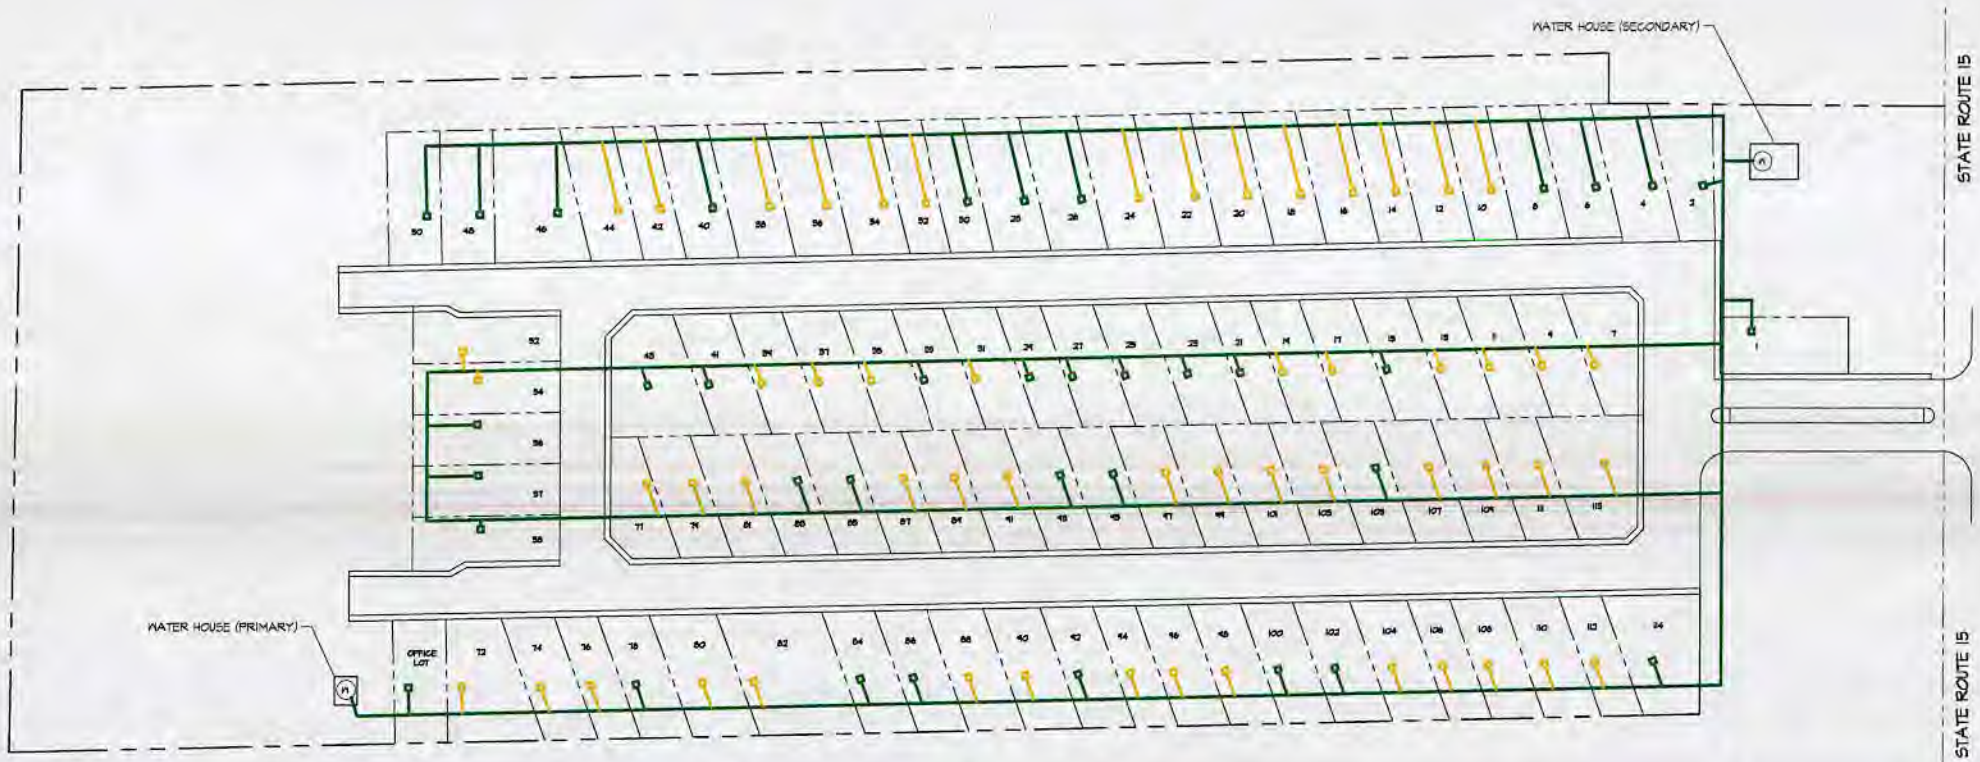

**LEGEND**

DESCRIPTION	SYMBOL	DESCRIPTION	SYMBOL
WELL	(W)	WATER MAIN (2" P.V.C.)	—
		SERVICE CONNECTION (BLACK P.V.C. PIPE)	—
		SERVICE CONNECTION (COPPER WITH COMPRESSED FITTINGS)	—

NOTE: WATERLINE LAYOUT AND DISTRIBUTION INFORMATION IS BASED OFF OF DISTRIBUTION MAINTENANCE RECORDS (WATERLINE BREAK RECORDS)



**NARRATIVE**

- 1) MOBILE HOME COMMUNITY WITH AN OFFICE (1), AND WATER HOUSING FACILITIES (2).
- 2) WATER DISTRIBUTION SYSTEM CONSISTS OF P.V.C PIPE.
- 4) OF UNKNOWN AGES AND INSTALLATION DATES.
- 5) SERVICE CONNECTIONS ARE A MIX OF BLACK P.V.C AND COPPER WITH COMPRESSION FITTINGS.

**RECEIVED**  
 MAR 08 2017  
 DDAGW - NWDO

**Oakwood Mobile Home Park**  
 06-695 State Route 15, Bryan, OH 43506  
 Tel: (419) 636-2714

March 6, 2017  
 E.P.A. Lead Pipe Infrastructure Mapping

