

Loading
Dock



PVC Line
into Building

Water Meter
Utility Sink

Water
Fountain

Storage

Office

Storage

Container
Labs

Office

Office

Office

Shop

NORTH
↓

Map scale $1/8" = 2 FT.$
February 6, 2017


STUDEBAKER NURSERY EMPLOYEES BUILDING
PLS OH1245012
11140 MILTON CORCISLE RD.
937-339-185-9


Building Address: 11125 MILTON CORCISLE RD

CONSTRUCTED IN 1975
WATER SERVICE ENTRANCE LINE IS PVC
BUILDING SERVICES LINES ARE COPPER WITH
SOLWISA JOINTS

FITTING MATERIAL AND LEAD CONTENT UNKNOWN

— HOT WATER
— COLD WATER

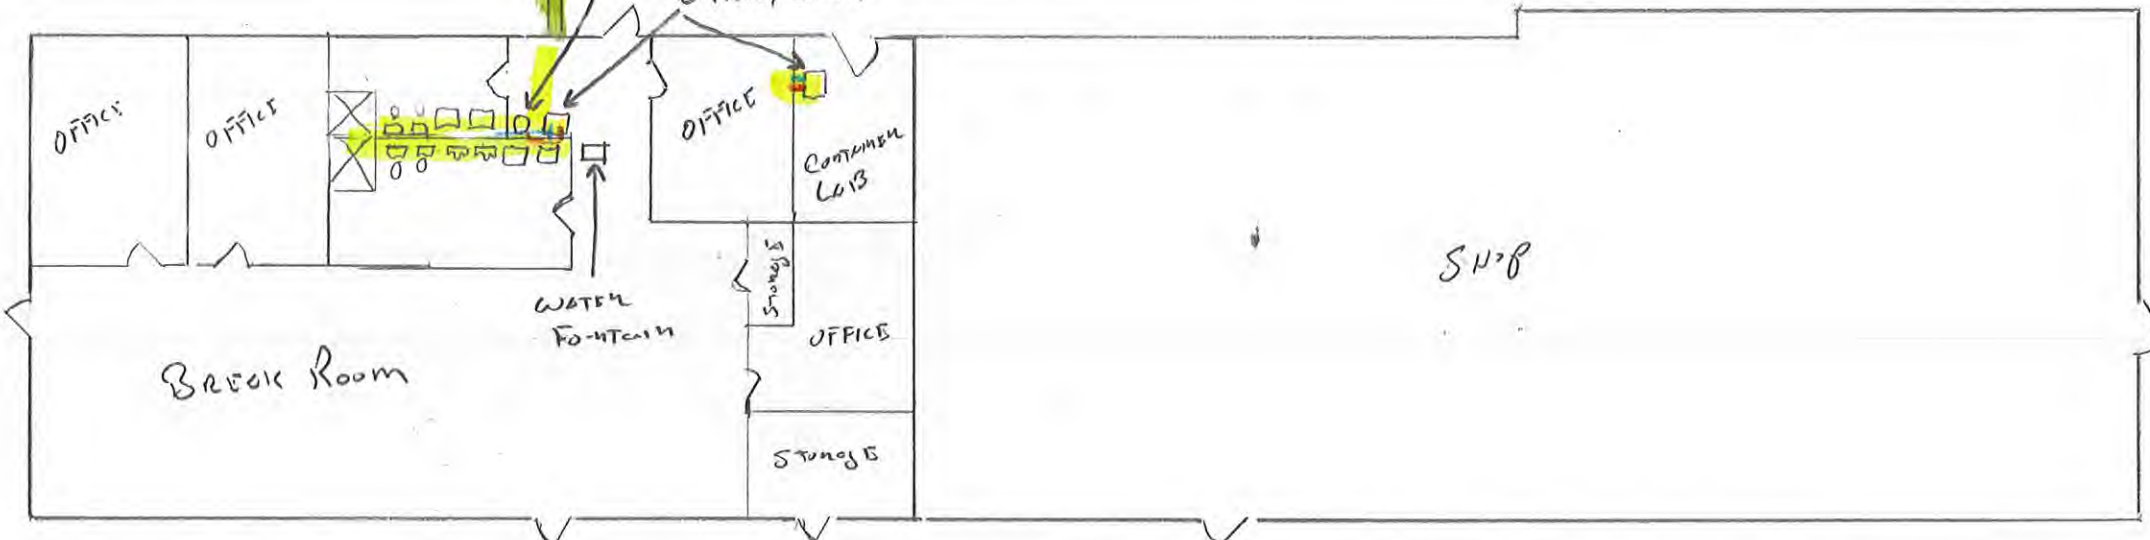

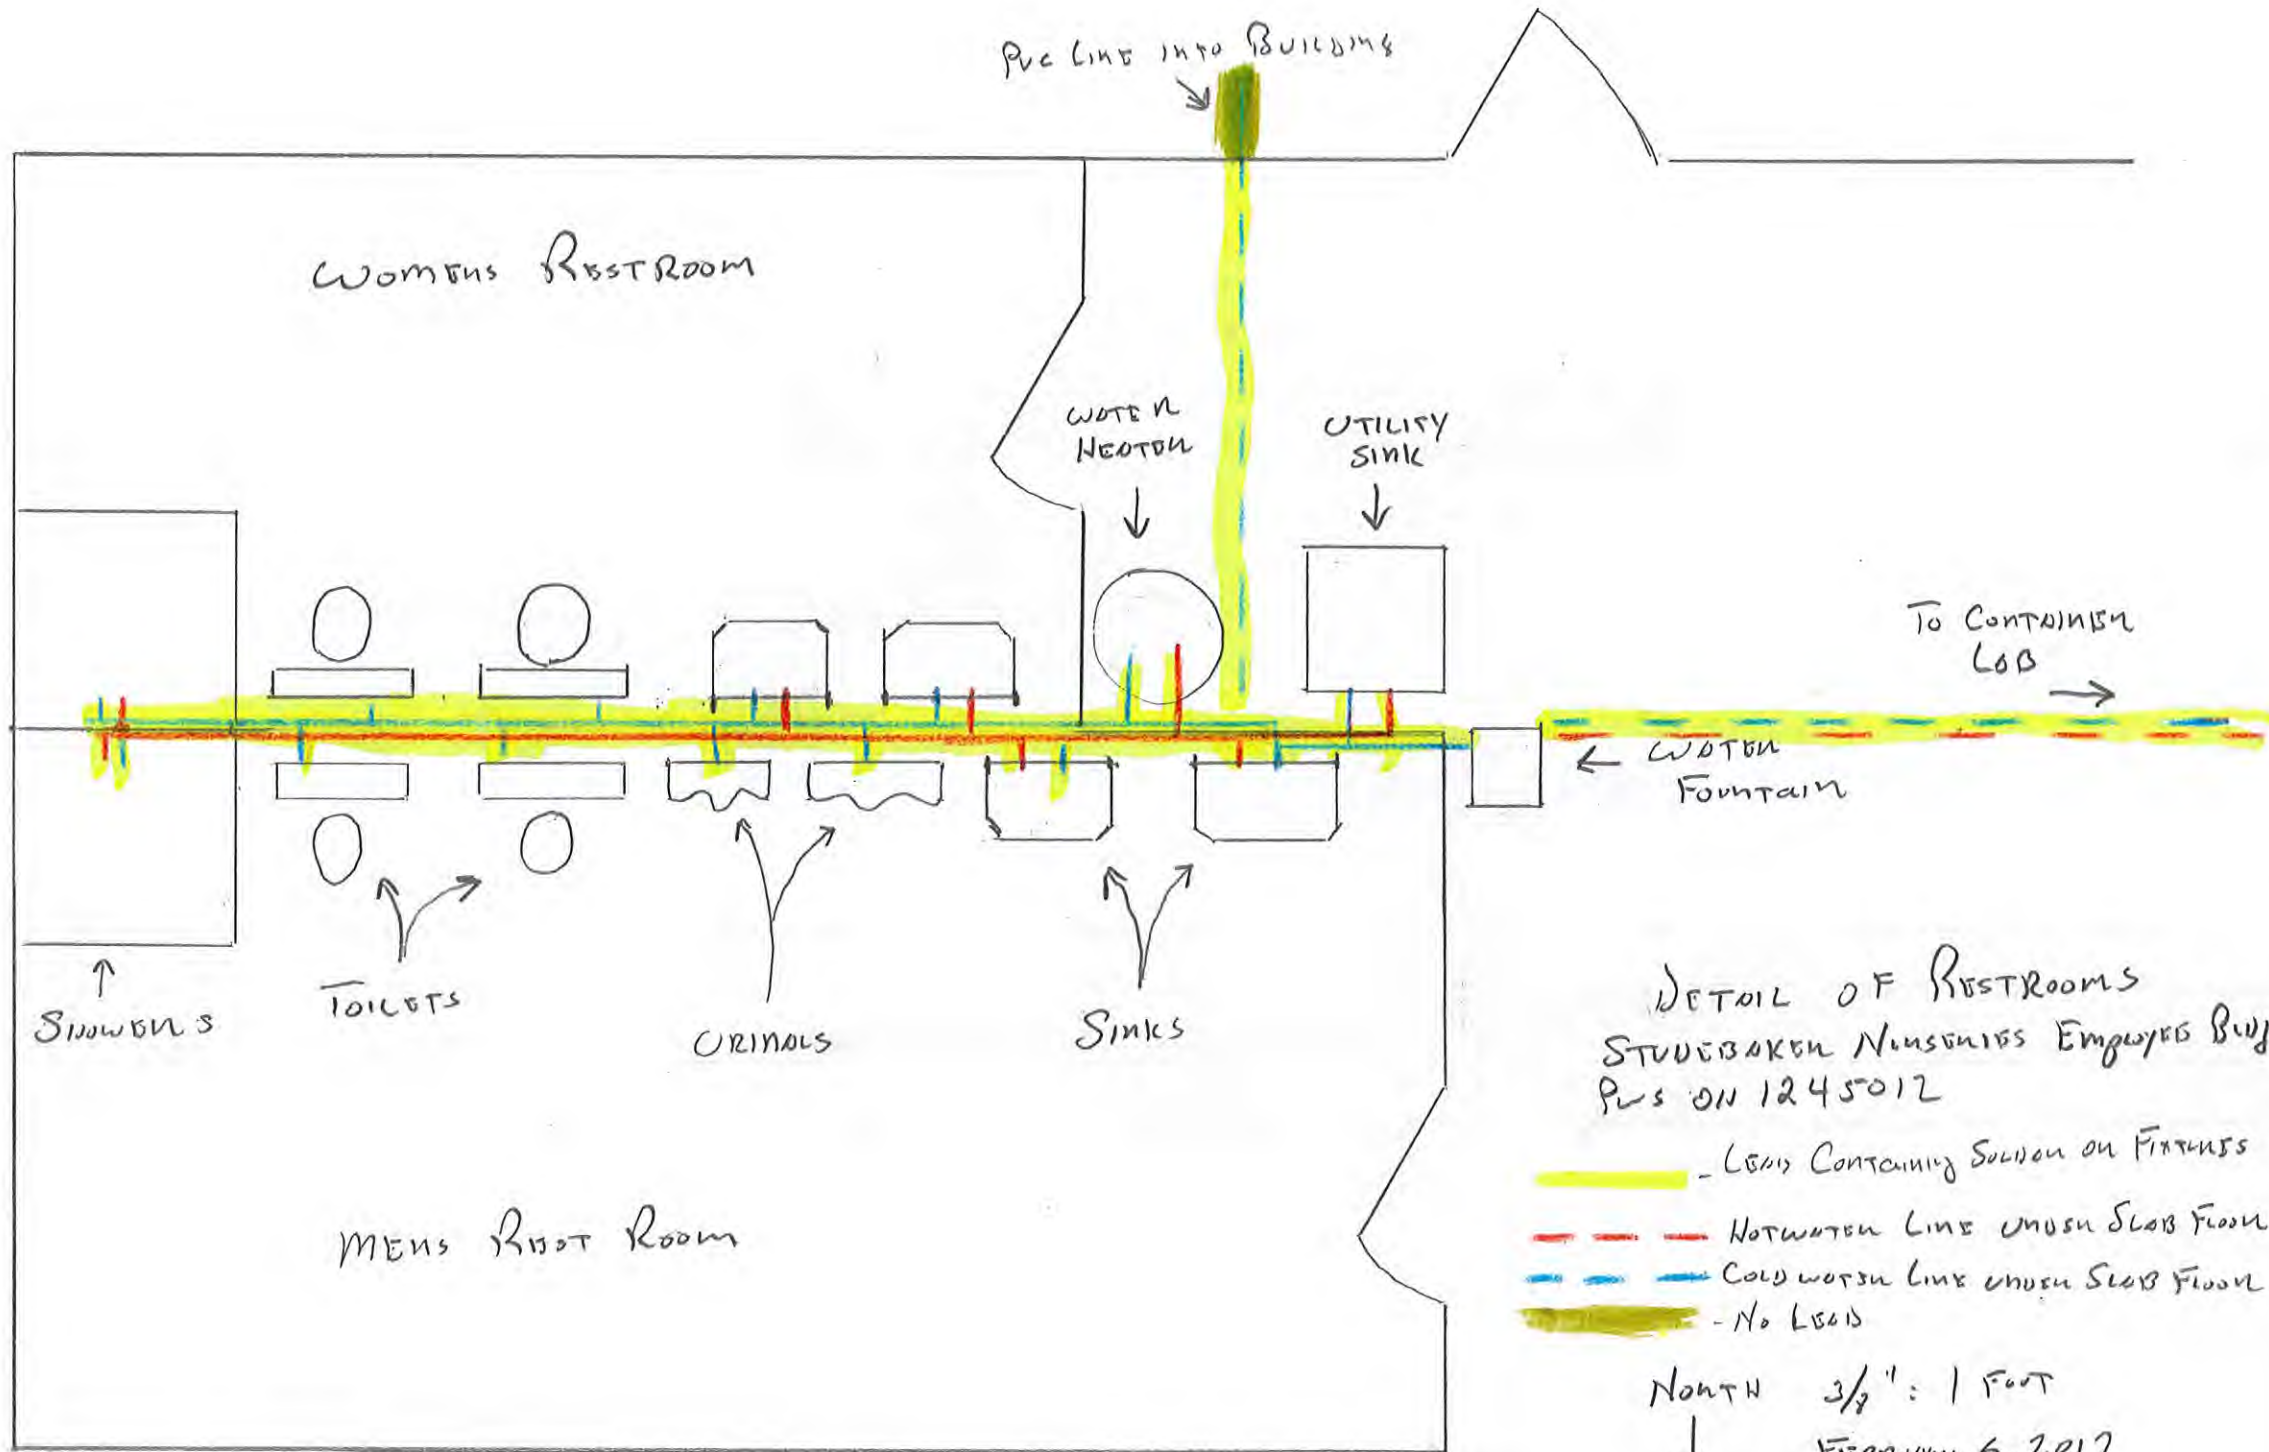

DETAIL OF RESTROOMS
 STUDEBAKER NEWSMITH EMPLOYER BLDG
 PLS ON 1245012

- - LEADS CONTAINING SOLUTION ON FIXTURES
- - - - HOT WATER LINE UNDER SLOBB FLOOR
- - - - COLD WATER LINE UNDER SLOBB FLOOR
- - NO LEADS