

DETAIL OF APARTMENT
 STUBENBOICKEN NURSING CAMP
 PWS 041244812


Copper water line comes out of concrete slab at water heater. Goes back in floor from water heater to wet wall.

- - - HOT WATER
 - - - COLD WATER
 - NO LEAD
 - LEAD CONTAINING SOLDER ON FIXTURES
- } BURIED IN CONCRETE SLAB


NORTH →

3/8 inch = 1 FOOT
 FEBRUARY 6, 2017

WELL HOUSE

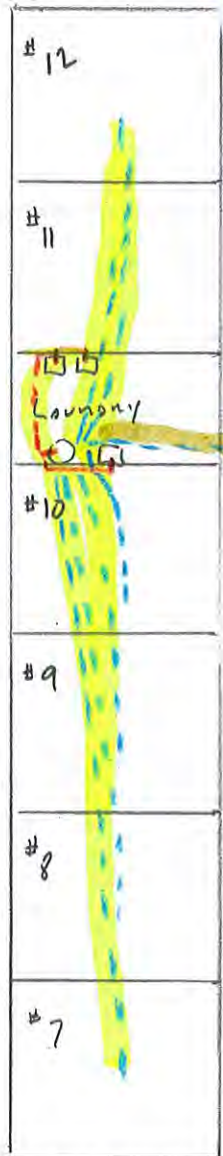

APARTMENT BUILDING # 2

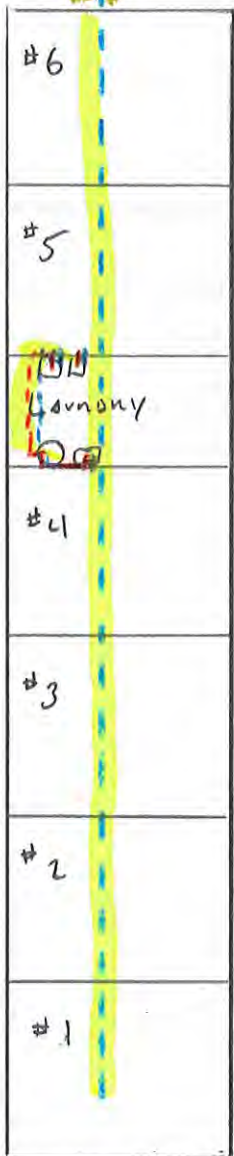

APARTMENT BUILDING # 1

MUSSELMAN ROAD

Parking Lot

APARTMENTS IN BUILDING #1 SERVED BY 1 main LINE.

APARTMENTS IN BUILDING #2 EACH HAVE THEIR OWN LINE SERVED FROM A MANIFOLD IN THE LAUNDRY ROOM.

EACH LAUNDRY ROOM HAS 2 WASHERS, A UTILITY SINK AND WATER HEATER

STUDEBAKER NURSERY Camp
 PWS OH 1244812
 1140 MILTON COLLIS RD
 937-339-185-9

BUILDING ADDRESS 11460 MUSSELMAN RD
 APT. BUILDING #1 CONSTRUCTED 1989
 APT. BUILDING #2 CONSTRUCTED 2001
 SERVICE LINE FROM WELL HOUSE IS BLACK POLY

ALL SERVICE LINES INSIDE APARTMENTS AND UNDER FLOOR ARE COPPER WITH SOLDER JOINTS.

ALL APARTMENTS ARE IDENTICAL IN SIZES AND LAYOUT.

↑
 NORTH
 3/8 INCH = 1 FOOT
 FEBRUARY 6, 2017