


**LEGEND**

- ★ Entry Point
- ⊕ LC Sample Point
- △ Hot Water Heater
- S outside Spigot
- B hot & Cold plumbing
- \*C\* Cold Water plumbing

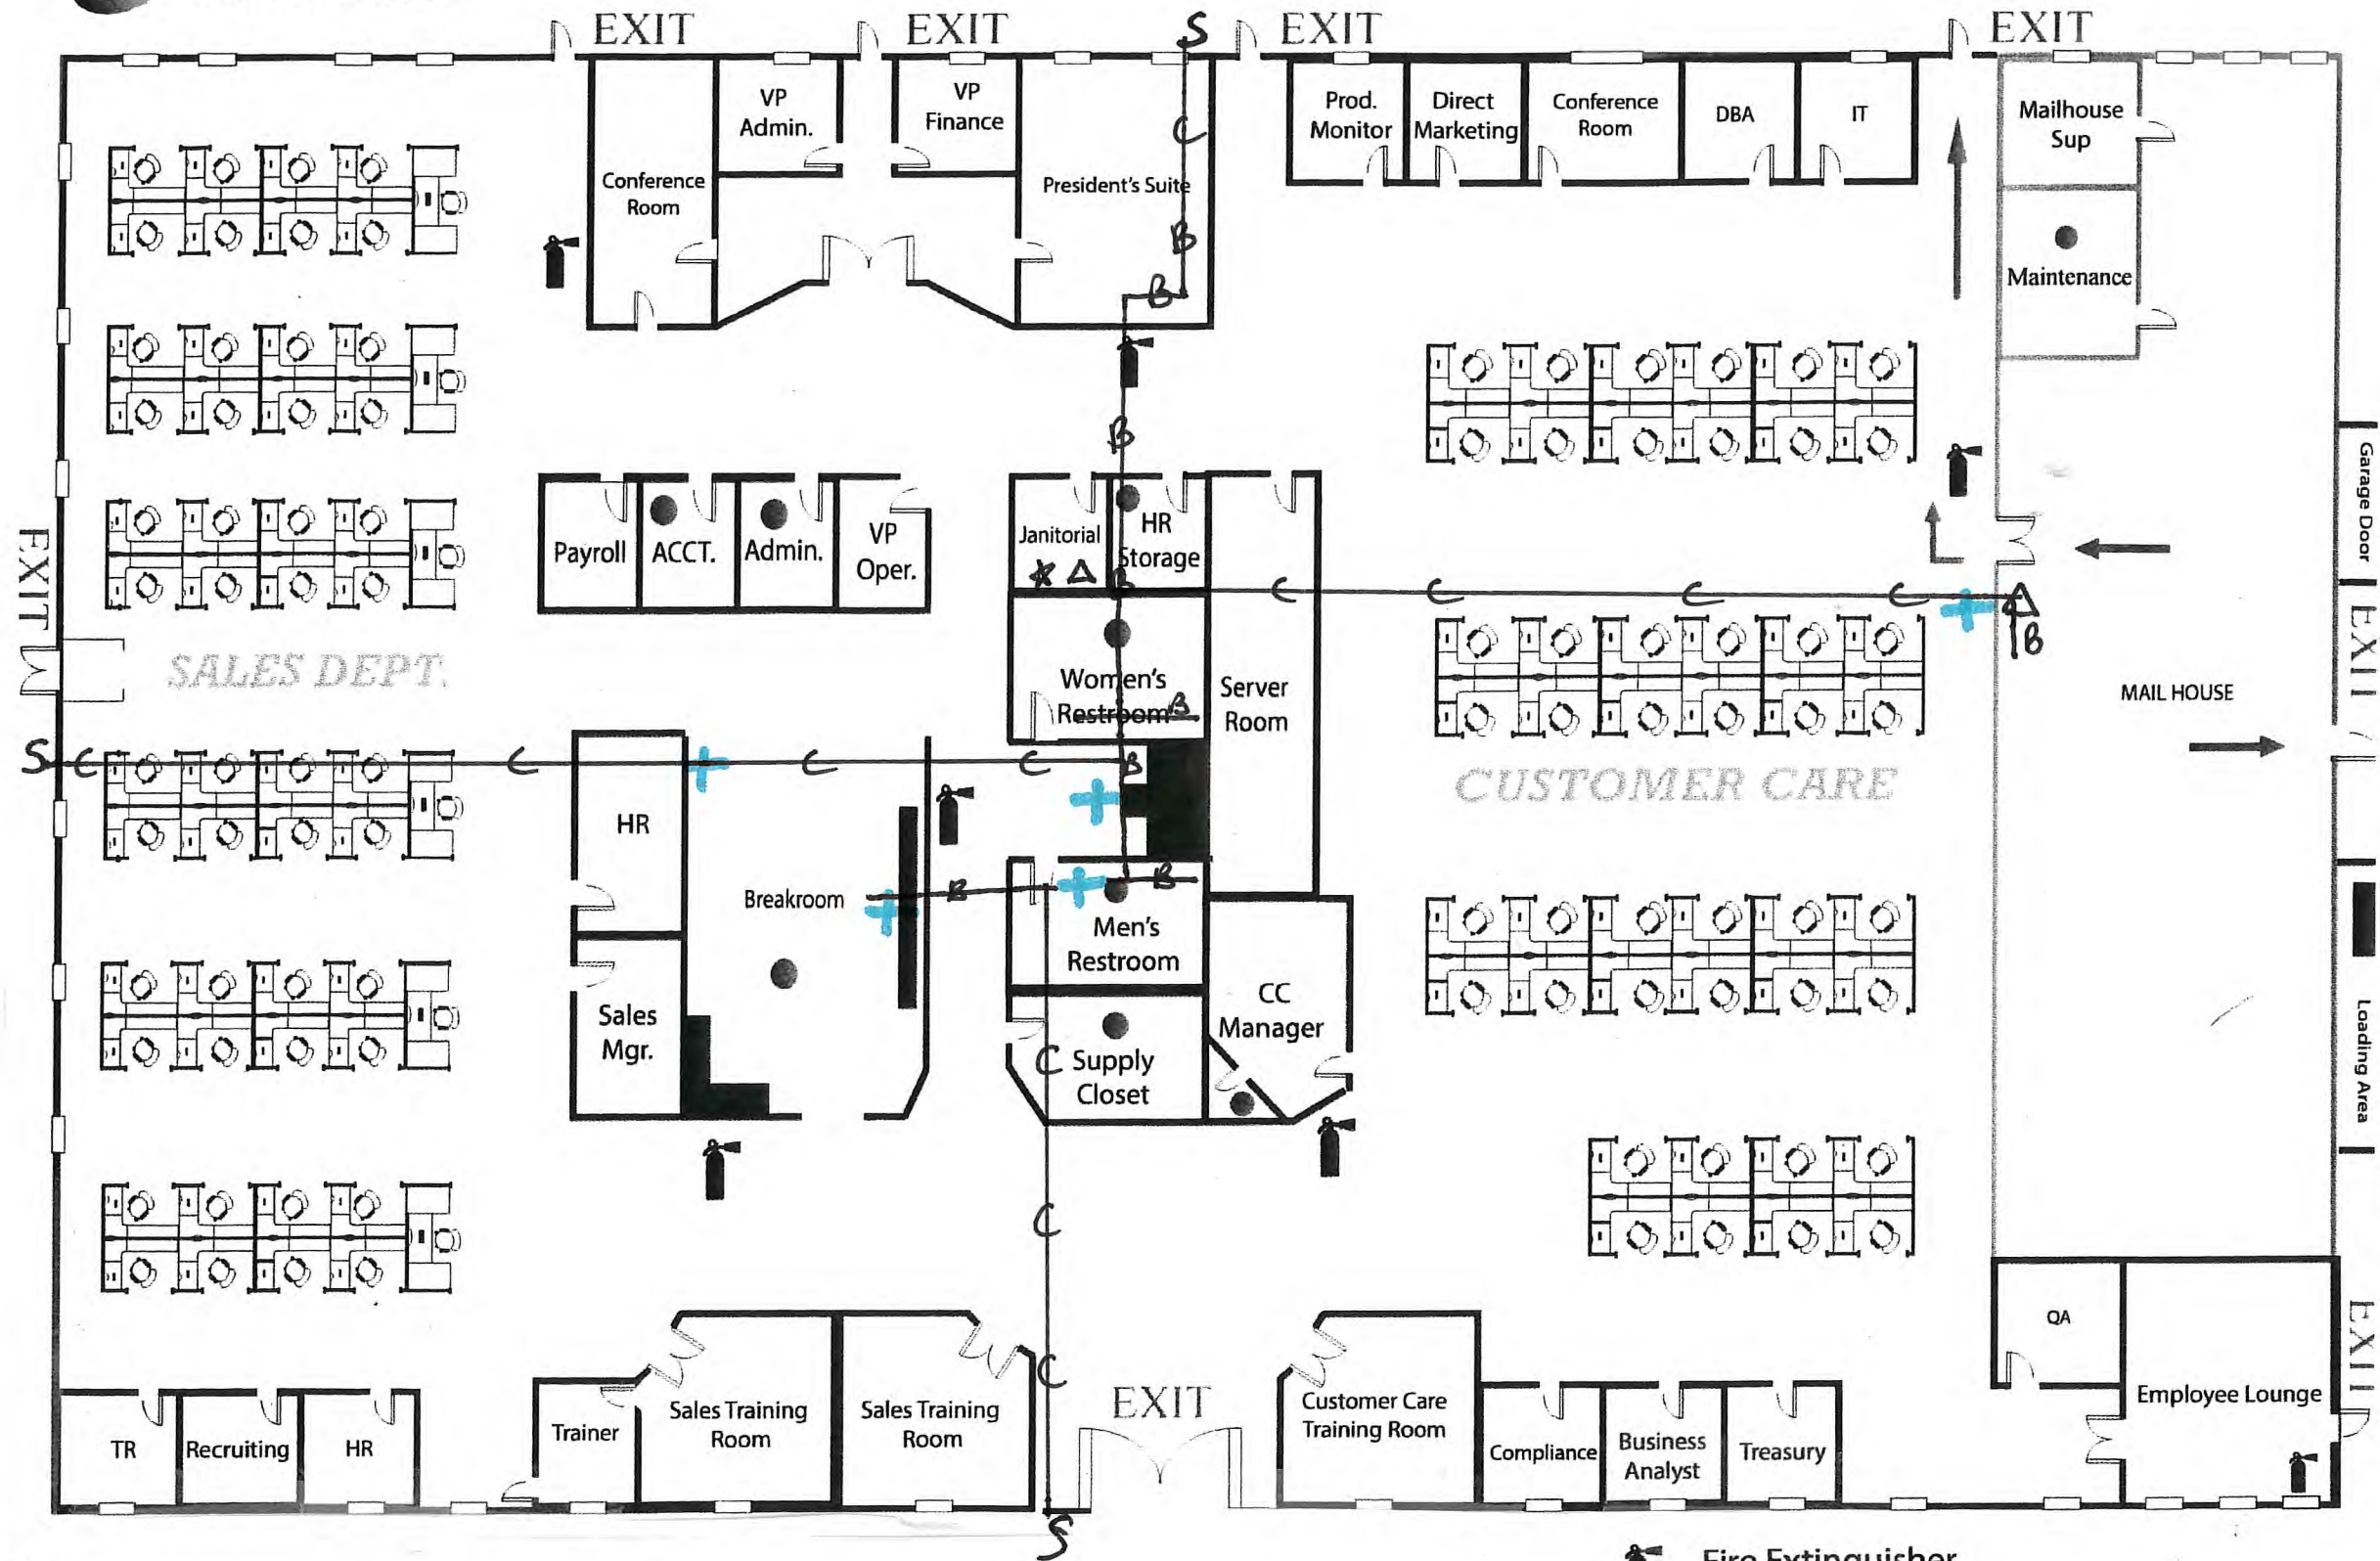

PWS ID*	PWS Name*	SMP ID*	Tier Site*	Street Address*	City*	State*	Zip*
OH2957812	NBA, INC.	LC201	Tier 1	855 Lower Bellbrook Road	Xenia	Ohio	45385

The above PWS system distribution system and plumbing was installed new when the building was built in 2004, pipes do not contain lead (All pipes are copper or PVC). Fixtures or solder may have characteristics that possibly could include a risk to contribute lead to drink water. The water is purchased from Greene County PWS, held in 2 cisterns, and distributed through the facility. Site has hot and cold water and a water softener.

 Fire Extinguisher  
 Fire Route  
 (937) 673-4242