

To reiterate, all service lines in the village of Gettysburg are copper, with compression joints, as installed in 1950.

The majority of customers serviced by the Village are older houses, likely to be plumbed with a mixture of copper (lead solder), galvanized, and plastic. Those houses that are our sample locations are appropriately marked on the map, and listed in this packet.

There are a few larger single buildings in the service area, mapped, as follows:

The Village Council House, 216 High Street, constructed in 1980, has copper plumbing with some joints soldered.

The Cardinal Center, formerly Gettysburg School, was originally built in 1952. The interior plumbing is a mixture of copper with lead solder, and possibly some galvanized and plastic.

The Valentine Building at the Village Park was constructed post-ban in 2006.

Lavy's Corner Mart (Gas Station), 103 West Main, was constructed post-ban in 1999.

Gettysburg Fire House was remodeled and plumbed with PEX plastic in 2005.


Norcold, Inc., 1 Century Drive, is a large building that has been expanded a few times. It has changed ownership as well, and so, presumably, is up to current code.

Wholesale Carpet Warehouse, 301 E. Main, also a business presumably up to current code.

The Village Water Treatment Facility was constructed post-ban in 2003.




# WATER DISTRIBUTION MAP FOR THE VILLAGE OF GETTYSBURG, OHIO 1979

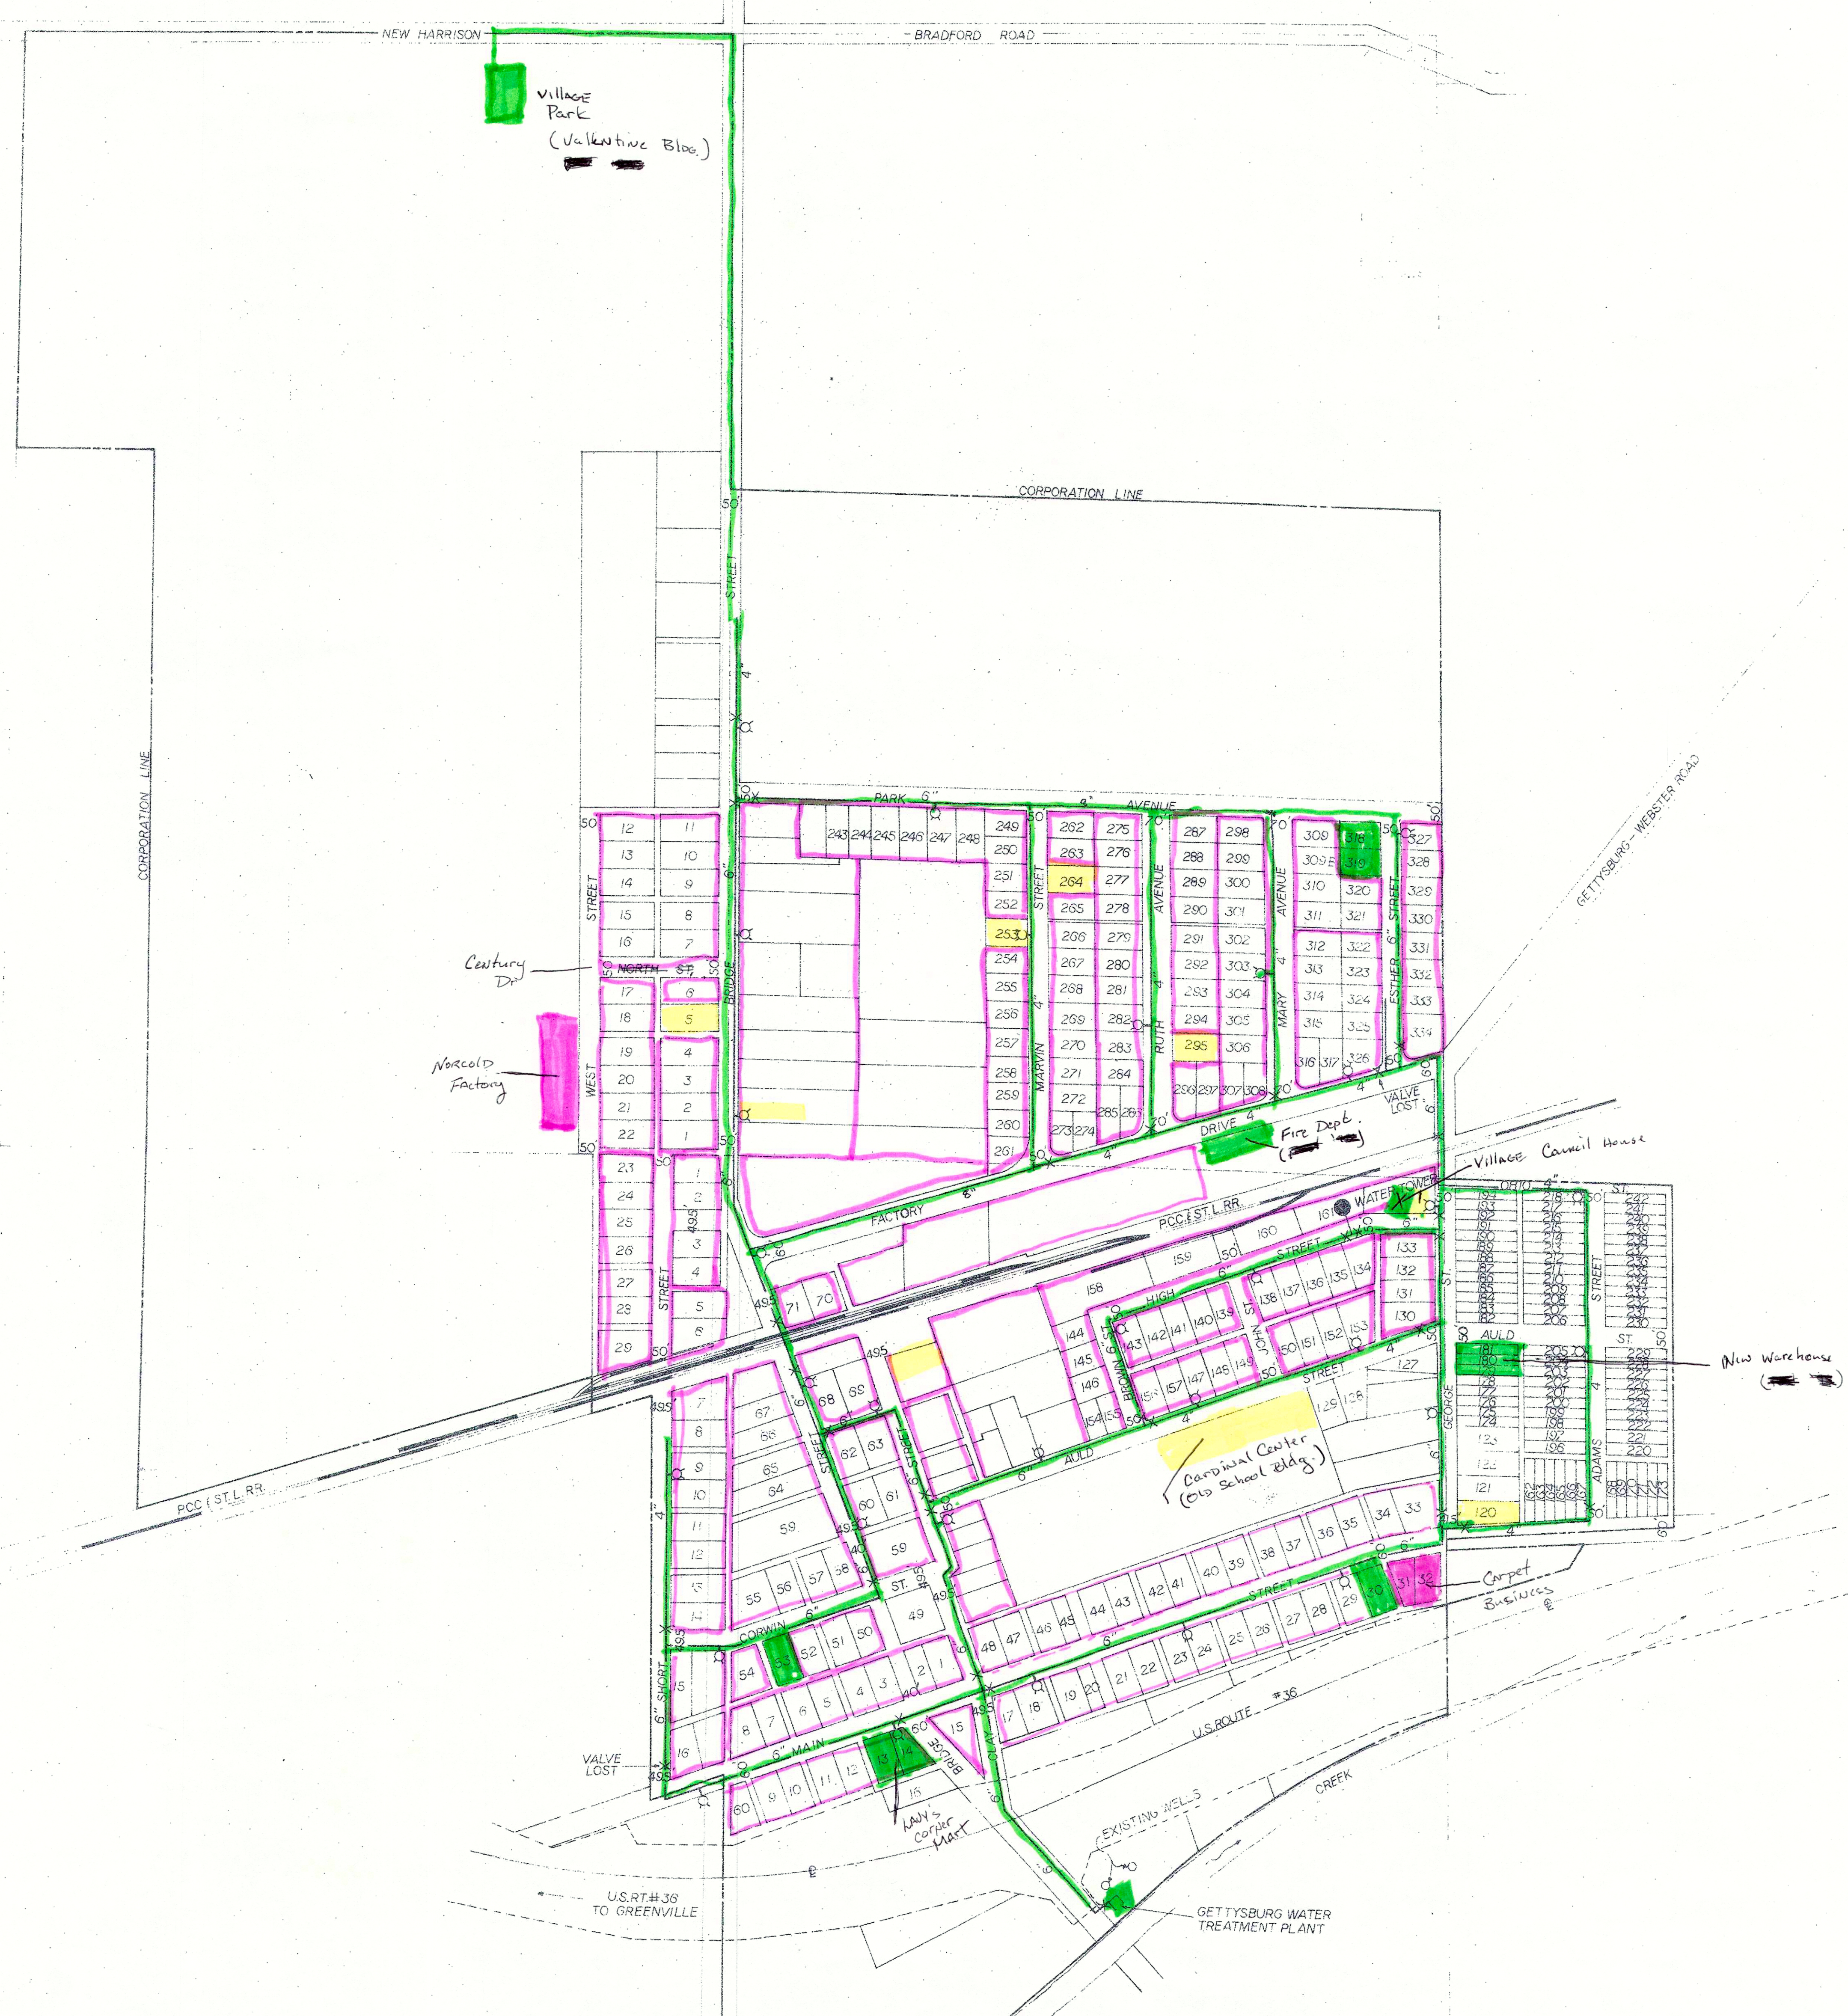

- No Leaks
- Copper w/ Compression Joints or PEX plastic
- Copper w/ Lead Solder or Mixture Copper & galvanized
- No Information; mainly private residences

LEGEND  
WATER VALVE  
FIRE HYDRANT  
WATER LINE

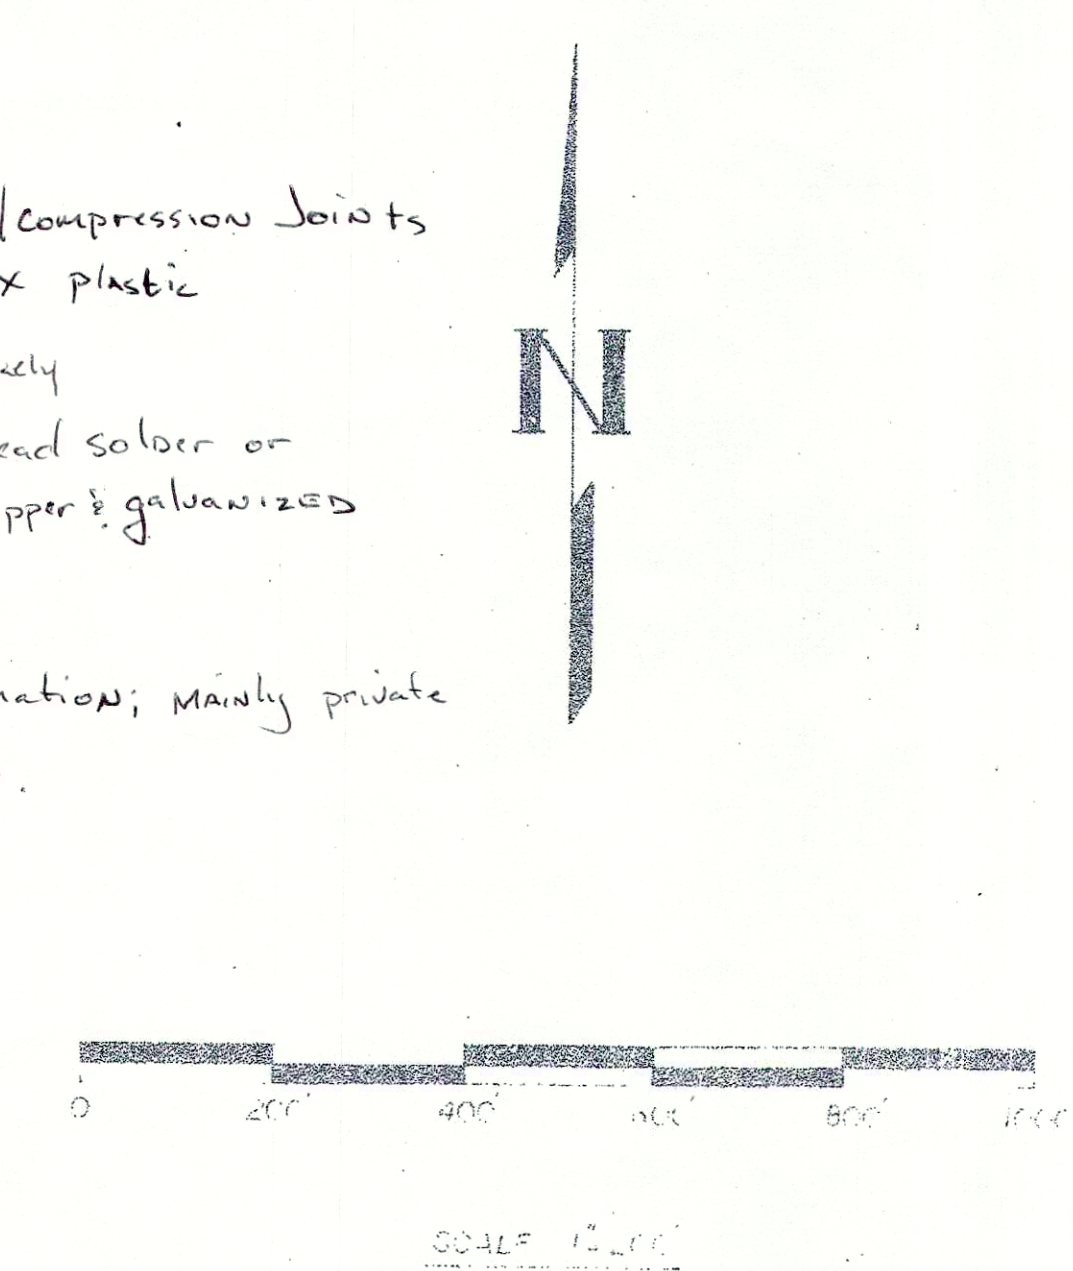

MOTE-GARRISON & ASSOC. INC.  
306 SYCAMORE ST.  
GREENVILLE, OHIO



FEB 15 2017

Environmental District

## SAMPLING LOCATIONS

### Service Line/Plumbing Information

\*ALL SERVICE LINES in the Village of Gettysburg are copper.

#### Interior Plumbing:

|                          |        |                             |
|--------------------------|--------|-----------------------------|
| 1. 400 E. Main Street    | Copper | (Post 1982)                 |
| 2. 221 Corwin Street     | Other  | (Plastic)                   |
| 3. 110 Ruth Street       | Other  | (Copper, pre-1982)          |
| 4. 309 N. Bridge Street  | Other  | (Copper, pre-1982)          |
| 5. 113 Marvin Street     | Other  | (Copper, pre-1982)          |
| 6. 118 Ruth Street       | Other  | (Mixture copper/plastic)    |
| 7. 223 Dorwin St.        | Other  | (Mixture copper/galvanized) |
| 8. 114 Esther Street     | Other  | (Mixture copper/plastic)    |
| 9. 116 Marvin Street     | Copper | (Post 1982)                 |
| 10. 428 N. Bridge Street | Other  | (Mixture copper/galvanized) |

## VERIFICATION FORM FOR COMMUNITY PUBLIC WATER SYSTEMS CLAIMING NO LEAD SERVICE LINES

The owner or operator of all community public water systems must identify and map areas of their distribution system that are known or are likely to contain lead service lines. Systems must submit a copy of the applicable map to the Ohio Department of Health and the Ohio Department of Job and Family Services. Systems must also submit a report to the director containing at least both of the following: (1) The applicable map with narrative, and (2) A list of sampling locations used to collect samples as required by Ohio Revised Code (ORC) Section 6109.121 and any rules adopted thereunder, including contact information for the owner and occupant of each sampling site.

Should a water system determine no lead service lines exist in their distribution system, they must provide information stating they reviewed, at the minimum, historical permit records and local ordinances, distribution maintenance records and information pertaining to installation dates or materials for all services lines. This information must be verified below.

I HEREBY CERTIFY THAT THE FOLLOWING METHOD(S) WERE USED TO DETERMINE NO LEAD SERVICE LINES EXIST IN THIS WATER SYSTEM'S DISTRIBUTION SYSTEM, AS REQUIRED BY ORC 6109.121(F):

| LEAD SERVICE LINE VERIFICATION  |
|---|
| <p><b>This PWS states they have no lead service lines and has reviewed the following information (select one or more of the following):</b></p> <ul style="list-style-type: none"><li><input type="checkbox"/> Historical permit records and/or local ordinances</li><li><input checked="" type="checkbox"/> Distribution maintenance records (i.e. meter replacement, waterline break repairs)</li><li><input type="checkbox"/> Information pertaining to installation dates for all service lines (i.e. after 1986 when lead services lines were banned)</li><li><input checked="" type="checkbox"/> Service line material of all service lines is known (i.e. all service lines are known to be PVC)</li></ul> |

Joseph M. Helfrich 3-1-2017  
Signature of Responsible Person Date  
Joseph M. Helfrich, Village Administrator  
Printed Name and Title of Responsible Person

PWS NAME: Village of Gettysburg  
PWS ID: OH 1900512  
COUNTY: DAKE

|  |
|--|
| For Ohio EPA use only                    |
| Date Verification Rec'd: <u>3/1/2017</u> |