

OH. EPA,

Franklin Monroe Local PWS ID OH1950512 was constructed and occupied in August of 2011. All water supply lines are copper but being built before the 2014 plumbing guide lines . Also all fixtures was new in 2011 but before the 2014 plumbing codes.

Doing our daily, weekly and monthly water testing we are able to reach and keep our lead and copper levels at the required levels.

Please refer to the attached drawings with sampling ports and lines identified .


RECEIVED  
OHIO EPA

MAR 01 2017

Southwest District

Scott,

Full size prints has all sample sights on it.  
Numbers are the same as new sample sites

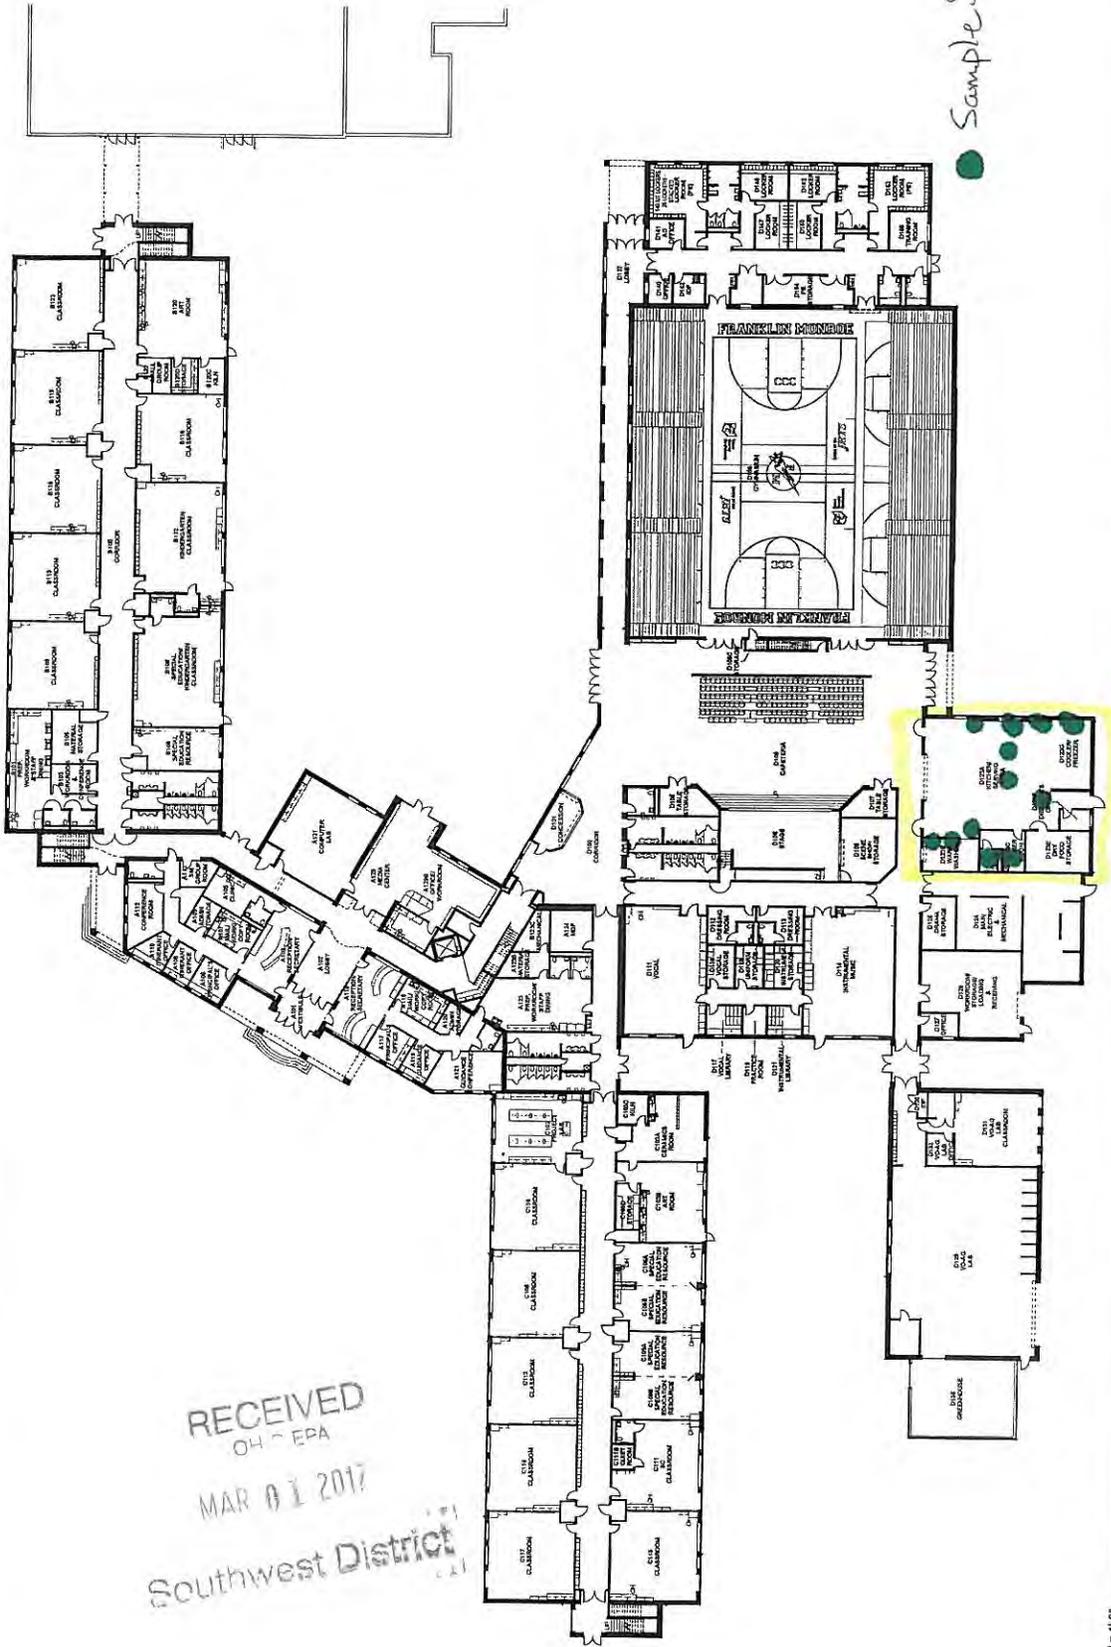

RECEIVED  
OH - EPA  
MAR 01 2017  
Southwest District

SCALE: 1/8" = 1'-0"

**SHP**  
LEADING DESIGN

Shelby County, Ohio  
11111 Main Street  
Cincinnati, Ohio 45228  
954.262.2200  
www.shp.com

Franklin Monroe School District


FRANKLIN MONROE K-12 FIRST FLOOR PLAN

8033 Colman Road, Pleasanton, OH 45068  
DATE: 06.17.08



# EQUIPMENT SCHEDULE

ITEM NO.	NO. REQ'D	DESCRIPTION	WATER	WASTE	FURN. INSTALL. CONN.	RESP.
			HOT COLD	MS	K.E.C.	K.E.C.
1A	1	BLOWER COIL - COOLER		MS	K.E.C.	
1C	1	BLOWER COIL - FREEZER		MS	K.E.C.	
14	1	WORK TABLE W/SINK	1/2" 1/2"	FS	K.E.C.	*
16	1	HOT WATER DISPENSER	1/4"	FD	K.E.C.	*
18	1	ENERGY DISTRIBUTION SYSTEM	3/4"		K.E.C.	*
21	1	FLOOR TROUGH		4"	K.E.C.	P.C.
22	1	KETTLE 40 GAL. - TILTING, LOW PROFILE	1/2" 1/2"	FS	K.E.C.	K.E.C.
23	1	KETTLE 12 GAL. - TILTING	1/2" 1/2"	FS	K.E.C.	K.E.C.
24	1	KETTLE 9 GAL. - TILTING	1/2" 1/2"	FS	K.E.C.	K.E.C.
25	1	CONVECTION STEAMER	2/3/1/2"	FS	K.E.C.	K.E.C.
27	1	WORK TABLE W/SINK	1/2" 1/2"	FS	K.E.C.	K.E.C.
30	1	DISPOSER SINK	1/2" 1/2"	FS	K.E.C.	K.E.C.
31	1	DISPOSER	3/4"	2"	K.E.C.	K.E.C.
32	1	PREP SINK W/OVER SHELF	1/2" 1/2"	FS	K.E.C.	K.E.C.
36	1	ICE MACHINE	1/2" 1/2"	FS	K.E.C.	K.E.C.
37	1	HOSE REEL - 30FT	1/2" 1/2"	FD	K.E.C.	K.E.C.
40	2	HOT FOOD TABLE	1/2" 1/2"	FD	K.E.C.	K.E.C.
51	1	HOSE REEL - 30FT	3/4"	3"	K.E.C.	K.E.C.
52	1	DISPOSER	3/4"	FS	K.E.C.	K.E.C.
54	1	DISHWASHER	1/2"	FS	K.E.C.	K.E.C.
55	1	BOOSTER HEATER	3/4"	FS	K.E.C.	K.E.C.

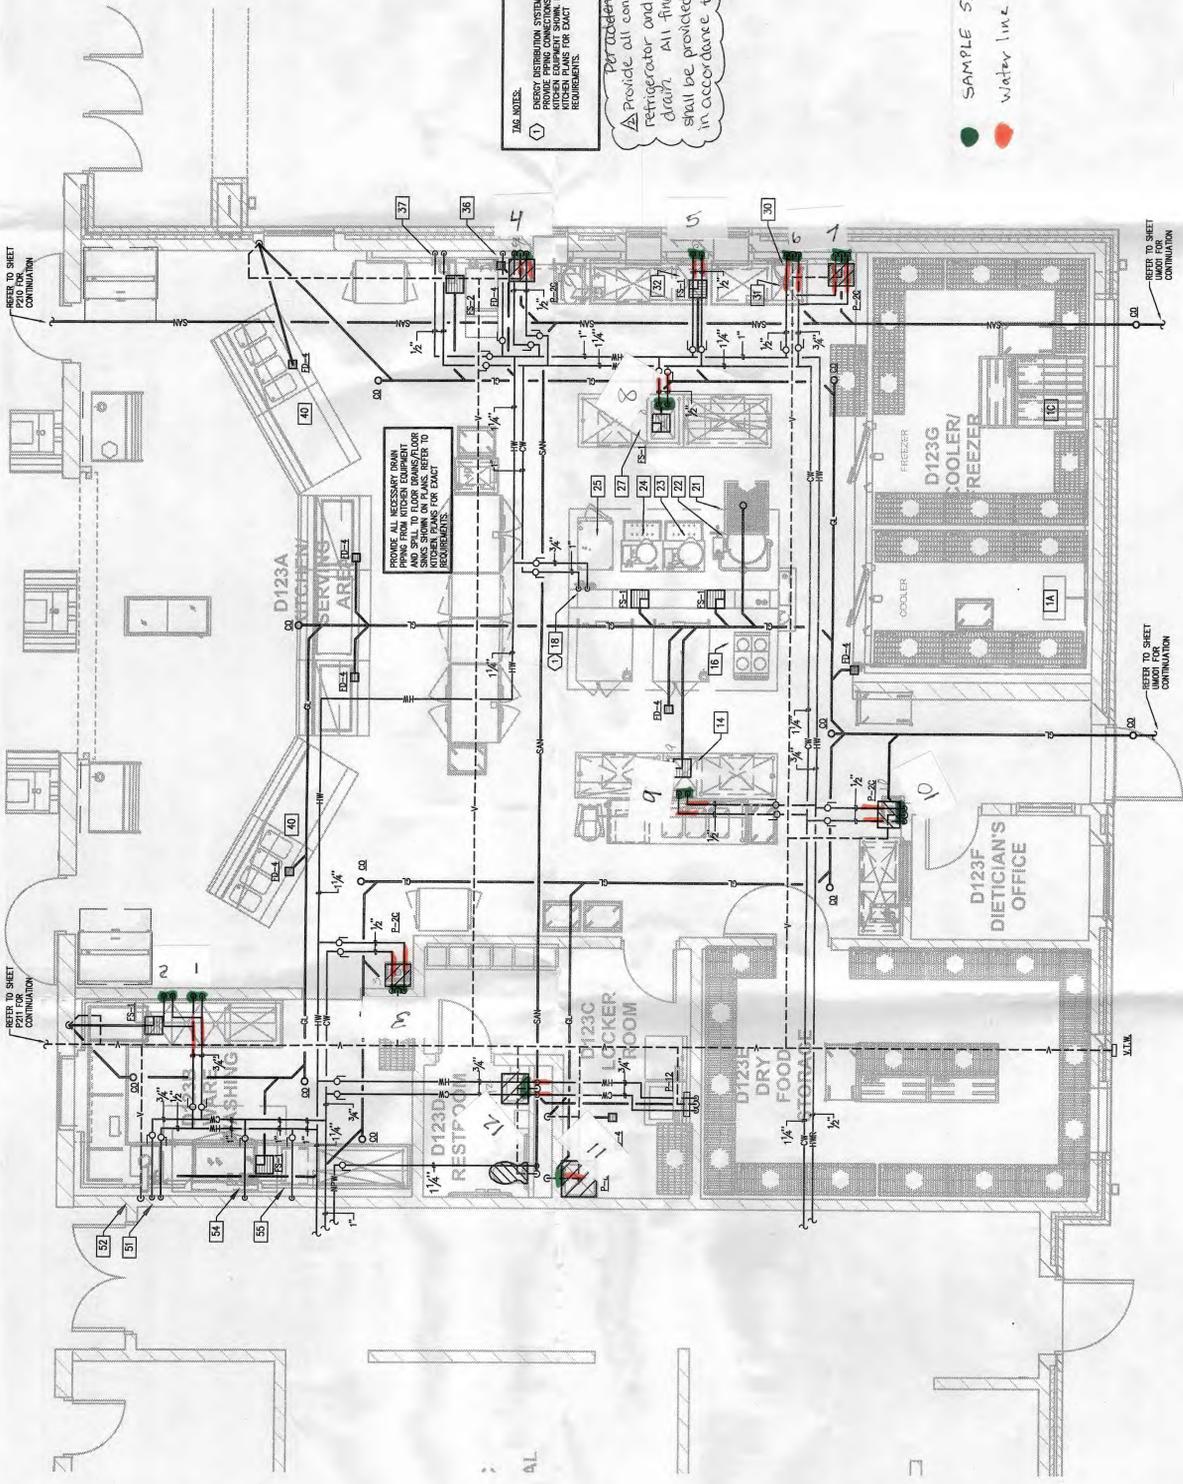

**THE NOTES:**  
 ① ENERGY DISTRIBUTION SYSTEM (ITEM #18) PROVIDE PIPING CONNECTIONS TO REFER TO KITCHEN PLANS FOR EXACT REQUIREMENTS.

**PER UNDERGROUND:**  
 Provide all condensate piping from refrigerator and freezers and floor to floor drain. All final kitchen water connections shall be provided with a backflow device in accordance to Ohio Plumbing Code.

**SAMPLE SITE**  
 water line

1 ENLARGED KITCHEN PLAN - PLUMBING  
 P3005 2" = 1'-0"

RECEIVED  
 City of Columbus  
 March 11, 2010  
 Southwest District

**SHP LEADING DESIGN**  
 4805 Montgomery Road  
 Cincinnati, Ohio 45212  
 513-381-1112  
 Suite 400

250 Civic Center Drive  
 Columbus, Ohio 43215  
 614-223-2124  
 Suite 200

82 Williams Avenue  
 Hamilton, Ohio 45015  
 513-883-5441  
 Suite 200



**Franklin Monroe School District**  
 8639 Oakes Road, Pittsburg, Ohio 45358

**FRANKLIN MONROE K-12 SCHOOL**  
 8639 Oakes Road, Pittsburg, Ohio 45358

**Franklin Monroe School District**  
 8639 Oakes Road, Pittsburg, Ohio 45358

**ISSUANCES**

06.22.09	OSFC SD Submission
08.14.09	OSFC DD Submission
09.17.09	OSFC DD Submission
11.03.09	Final Site Package
11.30.09	Geothermal Well Package
01.11.2010	OSFC CD Submission
02.03.2010	Permit Submission
02.15.2010	Bid Review Set
02.15.2010	BID SET

**ENLARGED KITCHEN PLAN PLUMBING**

CONSTRUCTION DOCUMENTS  
 DATE Feb. 12, 2010  
 COMM NO. 2008072.00  
**P301**









513-881-1112  
513-883-5441  
514-223-2124  
Sue 400  
Sue 200  
Sue 100

**SHP**  
LEADING DESIGN



**Franklin Monroe School District**  
8639 Oakes Road, Pitsburg, Ohio 45358




**ISSUANCES**  
05.22.09  
05.22.09  
06.14.09  
09.17.09  
11.03.09  
11.30.09  
01.17.10  
02.03.10  
02.12.2010  
BID SET


**AREA B - FIRST FLOOR PLAN - PLUMBING**

CONSTRUCTION DOCUMENTS  
DATE: Feb. 12, 2010  
COMM NO. 2008072.00  
**P205**

- PLUMBING FIRST FLOOR TAG NOTES:**
1. 1/2" CW AND HW DOWN TO 3-COMP SINK, PROVIDED BY K.E.C. PLUMBING CONTRACTOR TO PROVIDE ALL FINAL CONNECTIONS.
  2. 1/2" CW DOWN TO ICE MACHINE.
  3. GREASE TRAP, ZURN Z170-600, 3" INLET, 25 GPM, AND 50# GREASE CAPACITY. PROVIDE WITH FLOW CONTROL, WITH VENT PIPING AS REQUIRED BY THE PLUMBING CODE.
  4. PROVIDE SHUT-OFF VALVES FOR NPW, CW, AND HW, MOUNTED ON WALL AT 60" ABOVE FINISHED FLOOR EXPOSED IN JANITOR'S CLOSET.
  5. HOSE BIBB, CONNECT 3/4" POTABLE CW PIPING TO PIPING LOCATED IN JANITOR'S CLOSET.
  6. 2" SANITARY DOWN.
  7. 2" VENT UP.
  8. 4" VENT UP.
  9. 3" VENT UP.
  10. EMERGENCY GAS SHUT-OFF VALVE BOX AT TEACHERS DESK, MOUNT ON WALL BELOW BOARD.
  11. 3/4" CW AND HW TO WHIRLPOOL AND CONNECT. PROVIDE 2" DRAIN CONNECTION.
  12. PROVIDE A BALANCE VALVE SET AT 10 GPM, CHECK VALVE AND BALL VALVE.
  13. VENT PIPE THROUGH WALL TO LOUVER, COORDINATE WITH HVAC FOR LOUVER.
  14. 1/2" CW AND HW DOWN TO DARK ROOM SINK.
  15. PROVIDE 2" OPEN RECEPTACLE IN CASEWORK UNDER SINK.
  16. PROVIDE 2" OPEN RECEPTACLE ABOVE CEILING.
  17. 3" SANITARY DOWN.
  18. NON-POTABLE WATER EXPANSION TANK, CONNECT TO NPW MAIN SERVING TOILET ROOM, DOWNSTREAM OF SHUT-OFF VALVE. INSTALL ON PLATFORM, HOLD HIGH AS POSSIBLE. REFER TO P302 FOR DETAILS.
  19. NON-POTABLE WATER EXPANSION TANK, CONNECT TO NPW MAIN SERVING TOILET ROOM, DOWNSTREAM OF SHUT-OFF VALVE. INSTALL ON GROUND, HOLD HIGH AS POSSIBLE. REFER TO P302 FOR DETAILS.
  20. 2" CW UP.
  21. NON-POTABLE WATER EXPANSION TANK, CONNECT TO NPW MAIN SERVING TOILET ROOM, DOWNSTREAM OF SHUT-OFF VALVE. INSTALL ABOVE CEILING, HOLD HIGH AS POSSIBLE. REFER TO P302 FOR DETAILS.
  22. COORDINATE FPMH LOCATION WITH ARCHITECTURAL ELEVATIONS.
  23. COORDINATE VENT THROUGH WALL (VTW) WITH ARCHITECTURAL ELEVATIONS.

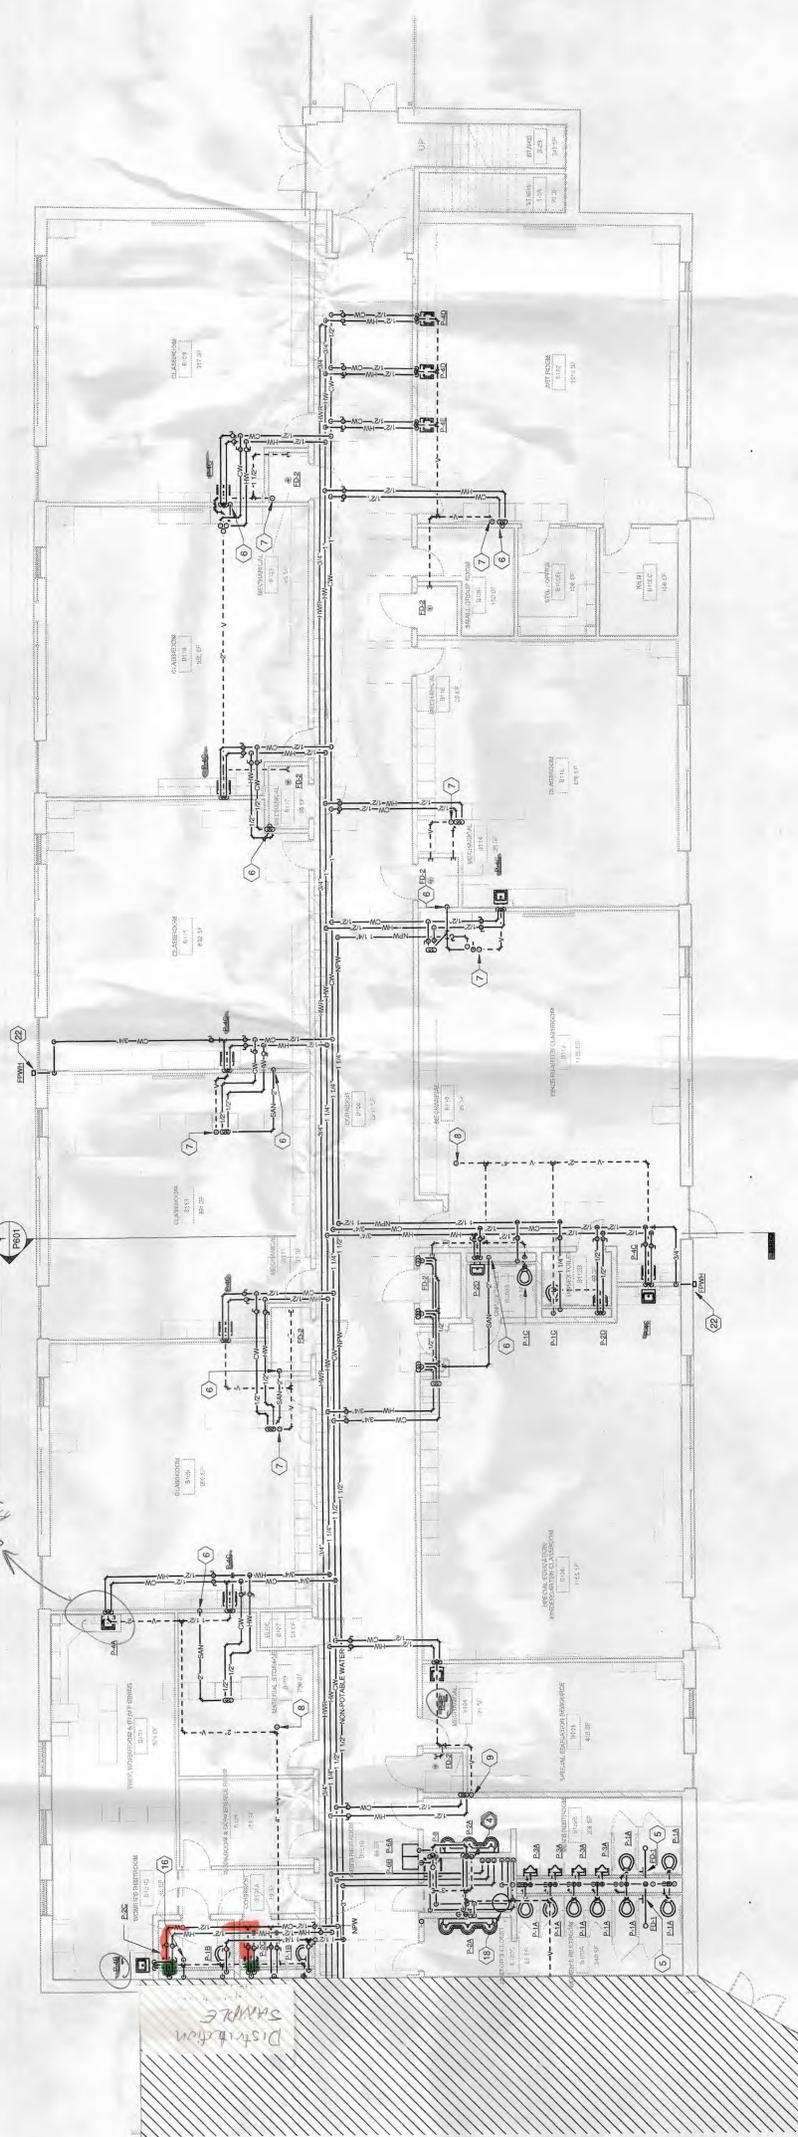

1 AREA B - FIRST FLOOR - PLUMBING  
1/8" = 1'-0"

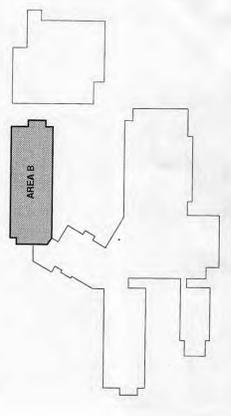

KEY PLAN