



RECEIVED
OHIO EPA

FEB 16 2017

Southwest District

INDEX NEW PARIS

JEFFERSON TOWNSHIP
PREBLE COUNTY
OHIO
1986

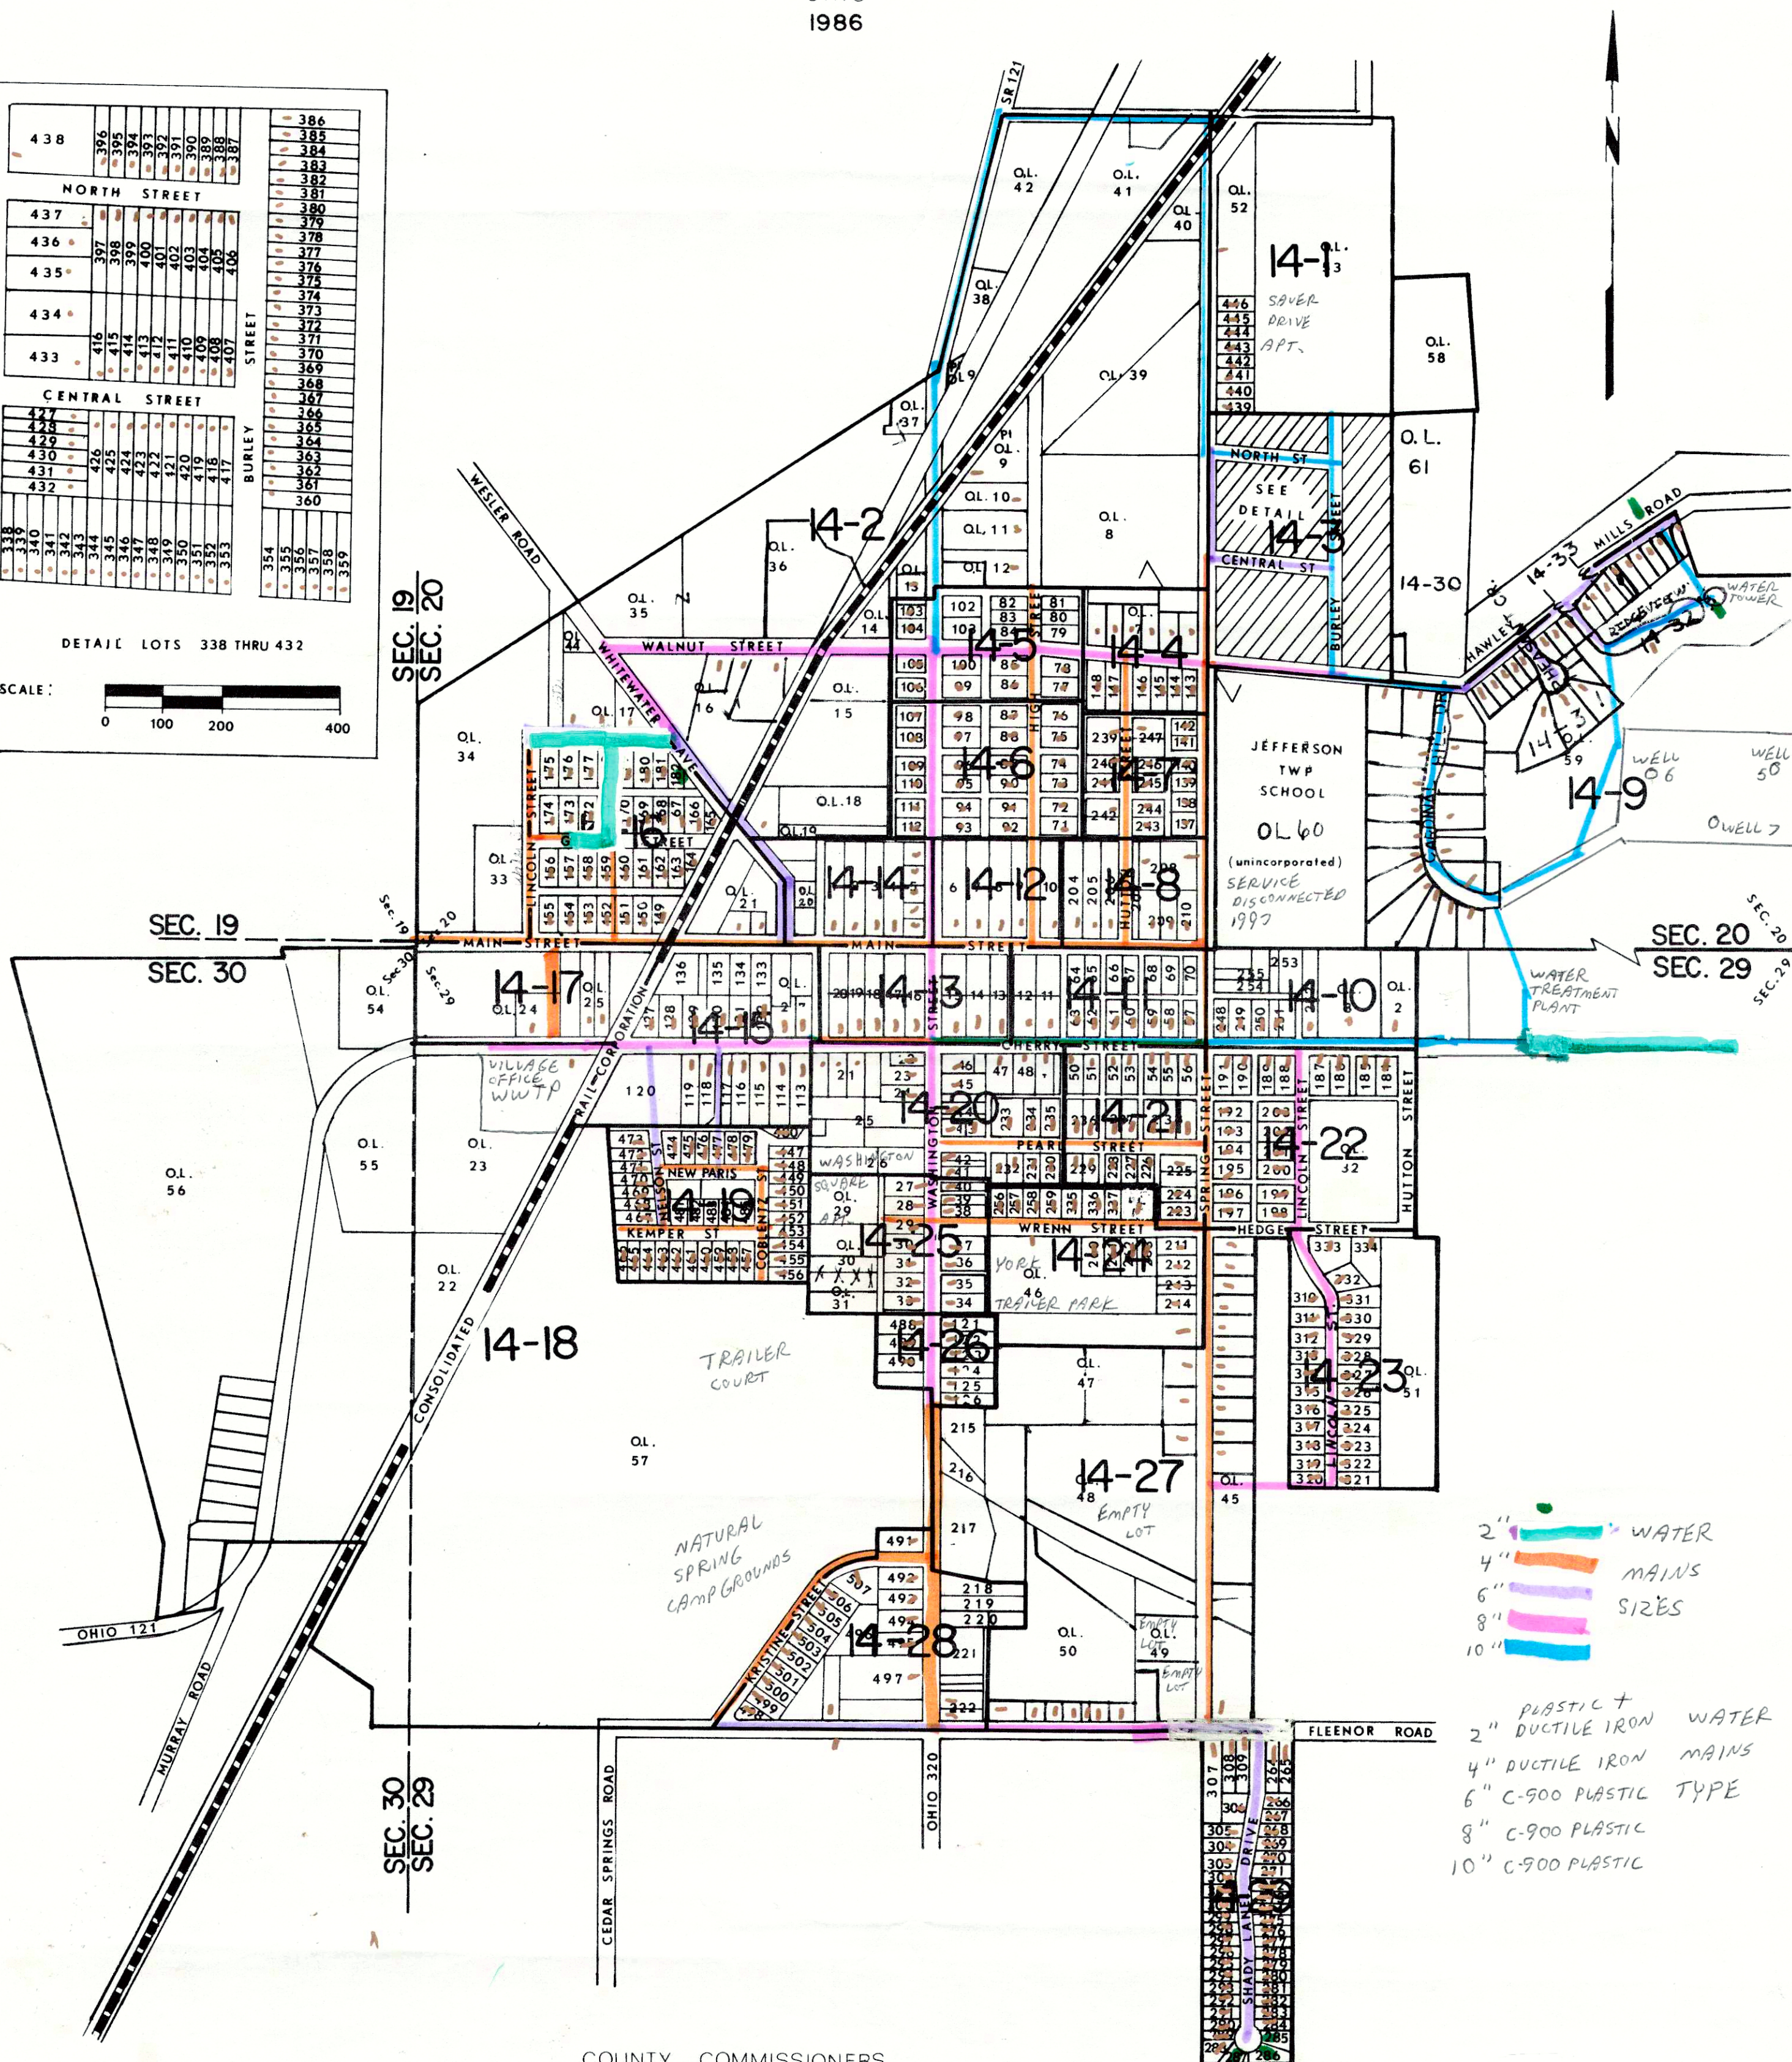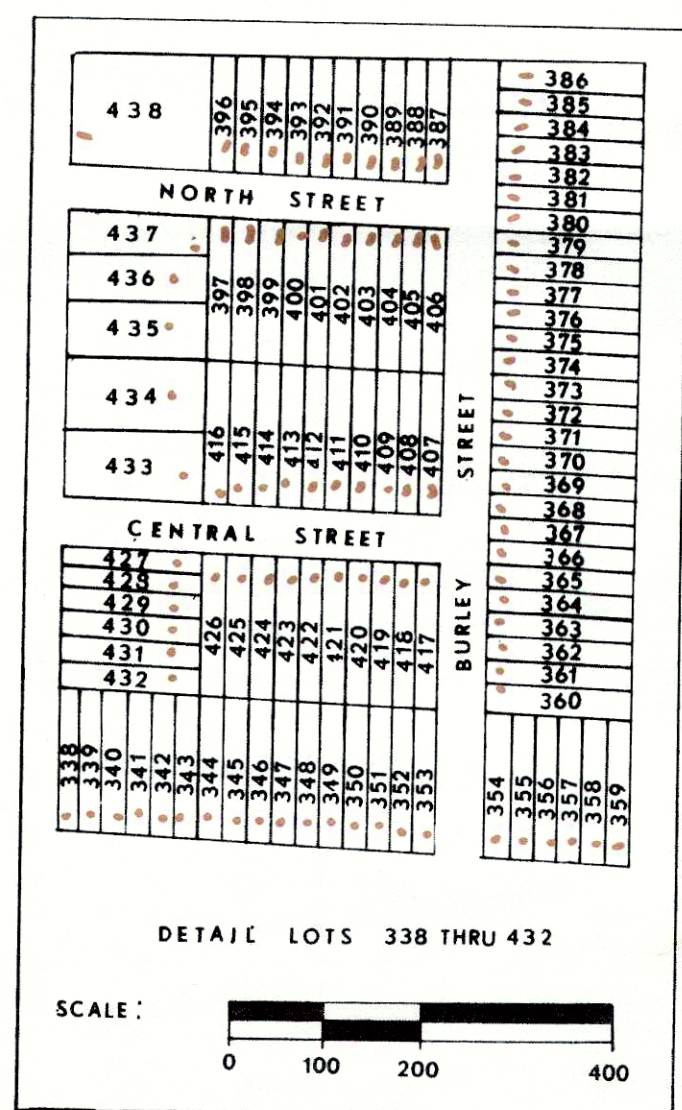

COUNTY COMMISSIONERS
JOAN BRUBAKER
JON JORDAN
PAUL RAY

COUNTY ENGINEER
J. STEPHEN SIMMONS

RECEIVED
02-28-2017

FEB 28 2017

Southwest District

**Village of
New Paris
Department of Service**

**Rick Snyder
Superintendent**

**301 W Cherry St
New Paris, Ohio 45347
Phone (937) 437-4454**

TO WHOM IT MAY CONCERN

February 24, 2017

Following is narrative description of documentation of service lines and water mains;

As far as we know Village of New Paris has 680 service lines total with 6 service lines are known to be non-lead lines. The remaining 674 service lines are prior to 1986, which we believe to have copper service lines and inside copper plumbing that consist of copper tubing with lead solder. Because it is practically impossible to determine the lead content of an installed fixture, fitting or pipe, it should be assumed that the manufacture or installation date is the primary indicator of the lead content. Therefore, the characteristics of buildings and piping solder or fixtures would be buildings in Ohio built prior to 1998 or that use plumbing material or solder manufactured before 1998 may have materials with greater than 8% lead and are at a higher risk of contributing lead to the drinking water than materials manufactured after 1998. In addition, buildings built and plumbing materials manufactured after 2014 were required to have less than 0.25% lead by weight and have the lowest risk for contributing lead to the drinking water. It should be noted however that, although prohibited, some use of leaded solder or leaded components may have occurred after the prohibitions became effective. The following service lines are non-lead lines for the following reasons:

141 Ridgeview St.	3/4 Inch plastic service line and plastic interior plumbing house built in 2016. Village installed services line Sept. 2016.
8253 Hawley Mills Rd.	1 inch service line and unknown interior plumbing house built in 2015. Village installed service line Nov. 2015.
22 Shady Lane	
23 Shady Lane	
24 Shady Lane-	These 3 service lines are 3/4 inch copper service lines. Exposed service line during fire hydrant replacement April 2016
204 Whitewater ave.	installed 3/4 inch plastic service line and property owner ran 3/4 plastic line to building and used pex tubing for inside plumbing

WATER MAIN FINDING

422 S. Washington St.	4 inch ductile water main -repair May 2015
302 Grant St.	2 inch ductile water main -valve replacement-Sept. 2016
8253 Hawley Mills Rd.	6 inch plastic water main-installed 1 inch service line Nov. 2015
204 Whitewater Rd.	2 inch ductile water main-installed 3/4 inch service-May 2016
24 Shady Lane St.	6 inch plastic water main- replace fire hydrant-April 2016
207 E. Walnut St.	8 inch ductile water main-repair water main-June 2015
141 Ridgeview St.	10 inch plastic water main-installed 3/4 inch service line

Village of
New Paris
Department of Service


Rick Snyder
Superintendent

301 W Cherry St
New Paris, Ohio 45347
Phone (937) 437-4454

Homes within Village of New Paris was built prior to 2000, except 2 homes that where built in 2015 and 2016 per as built maps.

No information was found prior to April 2015. Past personal left no service record that we could find. As of February 13, 2017 We believe that we don't have any lead service lines that I have seen, all service lines where replaced during water plant/water tower/water mains up grades (2003as built plans)

Reporting

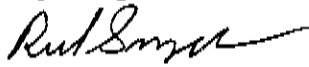

Rick Snyder
Village of New Paris
P.O. Box 147
New Paris, Ohio 45347
937-437-4454 office

MAR 02 2017

**VERIFICATION FORM FOR COMMUNITY PUBLIC WATER SYSTEMS
CLAIMING NO LEAD SERVICE LINES**

Southwest District

The owner or operator of all community public water systems must identify and map areas of their distribution system that are known or are likely to contain lead service lines. Systems must submit a copy of the applicable map to the Ohio Department of Health and the Ohio Department of Job and Family Services. Systems must also submit a report to the director containing at least both of the following: (1) The applicable map with narrative, and (2) A list of sampling locations used to collect samples as required by Ohio Revised Code (ORC) Section 6109.121 and any rules adopted thereunder, including contact information for the owner and occupant of each sampling site.

Should a water system determine no lead service lines exist in their distribution system, they must provide information stating they reviewed, at the minimum, historical permit records and local ordinances, distribution maintenance records and information pertaining to installation dates or materials for all services lines. This information must be verified below.

I HEREBY CERTIFY THAT THE FOLLOWING METHOD(S) WERE USED TO DETERMINE NO LEAD SERVICE LINES EXIST IN THIS WATER SYSTEM'S DISTRIBUTION SYSTEM, AS REQUIRED BY ORC 6109.121(F):

LEAD SERVICE LINE VERIFICATION

This PWS states they have no lead service lines and has reviewed the following information (select one or more of the following):

- ☒ Historical permit records and/or local ordinances
- ☒ Distribution maintenance records (i.e. meter replacement, waterline break repairs)
- ☐ Information pertaining to installation dates for all service lines (i.e. after 1986 when lead services lines were banned)
- ☐ Service line material of all service lines is known (i.e. all service lines are known to be PVC)



2-27-17

Signature of Responsible Person Date

RICK SNYDER OPERATOR OF RECORD

Printed Name and Title of Responsible Person

PWS NAME: NEW PARIS PWS

PWS ID: OH 6800912

COUNTY: PREBLE

For Ohio EPA use only:

Date Verification Rec'd: _____