



SUN COMMUNITIES, INC.

Oakwood Village MHP was established in 2 Phases (1968 & 1998). The Oakwood Village MHP drinking water distribution mains consist of Cast Iron and C900 pipe. The tapping saddles and corp stop are made of Brass or Plastic. The copper setters that were made prior to June 1986 may contain lead solder, all copper setters made after June 1986 may not. No lead service lines have been encountered in the years of distribution maintenance. The Oakwood Village MHP now has a mechanism in place to track/remove any potential lead service lines encountered in the future.

Because it is practically impossible to determine the lead content of an installed fixture, fitting or pipe, it should be assumed that the manufacture or installation date is the primary indicator of the lead content. Therefore, the characteristics of buildings and piping solder or fixtures would be buildings in Ohio built prior to 1998 or that use plumbing material or solder manufactured before 1998 may have materials with greater than 8% lead and are at a higher risk of contributing lead to the drinking water than materials manufactured after 1998. In addition, buildings built and plumbing materials manufactured after 2014 were required to have less than 0.25% lead by weight and have the lowest risk for contributing lead to the drinking water. It should be noted however that, although prohibited, some use of leaded solder or leaded components may have occurred after the prohibitions became effective.

Operator of Record,

A handwritten signature in black ink, appearing to read "M. Mike McLaughlin", written over a horizontal line.

M. Mike McLaughlin

## VERIFICATION FORM FOR COMMUNITY PUBLIC WATER SYSTEMS CLAIMING NO LEAD SERVICE LINES

The owner or operator of all community public water systems must identify and map areas of their distribution system that are known or are likely to contain lead service lines. Systems must submit a copy of the applicable map to the Ohio Department of Health and the Ohio Department of Job and Family Services. Systems must also submit a report to the director containing at least both of the following: (1) The applicable map with narrative, and (2) A list of sampling locations used to collect samples as required by Ohio Revised Code (ORC) Section 6109.121 and any rules adopted thereunder, including contact information for the owner and occupant of each sampling site.

Should a water system determine no lead service lines exist in their distribution system, they must provide information stating they reviewed, at the minimum, historical permit records and local ordinances, distribution maintenance records and information pertaining to installation dates or materials for all services lines. This information must be verified below.

I HEREBY CERTIFY THAT THE FOLLOWING METHOD(S) WERE USED TO DETERMINE NO LEAD SERVICE LINES EXIST IN THIS WATER SYSTEM'S DISTRIBUTION SYSTEM, AS REQUIRED BY ORC 6109.121(F):

### LEAD SERVICE LINE VERIFICATION

This PWS states they have no lead service lines and has reviewed the following information (select one or more of the following):

- ☐ Historical permit records and/or local ordinances
- ☐ Distribution maintenance records (i.e. meter replacement, waterline break repairs)
- ☐ Information pertaining to installation dates for all service lines (i.e. after 1986 when lead services lines were banned)
- ☐ Service line material of all service lines is known (i.e. all service lines are known to be PVC)

M Mike McLaughlin 3-7-17  
Signature of Responsible Person Date


M Mike McLaughlin Operator of Records  
Printed Name and Title of Responsible Person

PWS NAME: Oakwood Village MHP  
PWS ID: OH 5103715  
COUNTY: Montgomery

#### For Ohio EPA use only:

Date Verification Rec'd: \_\_\_\_\_



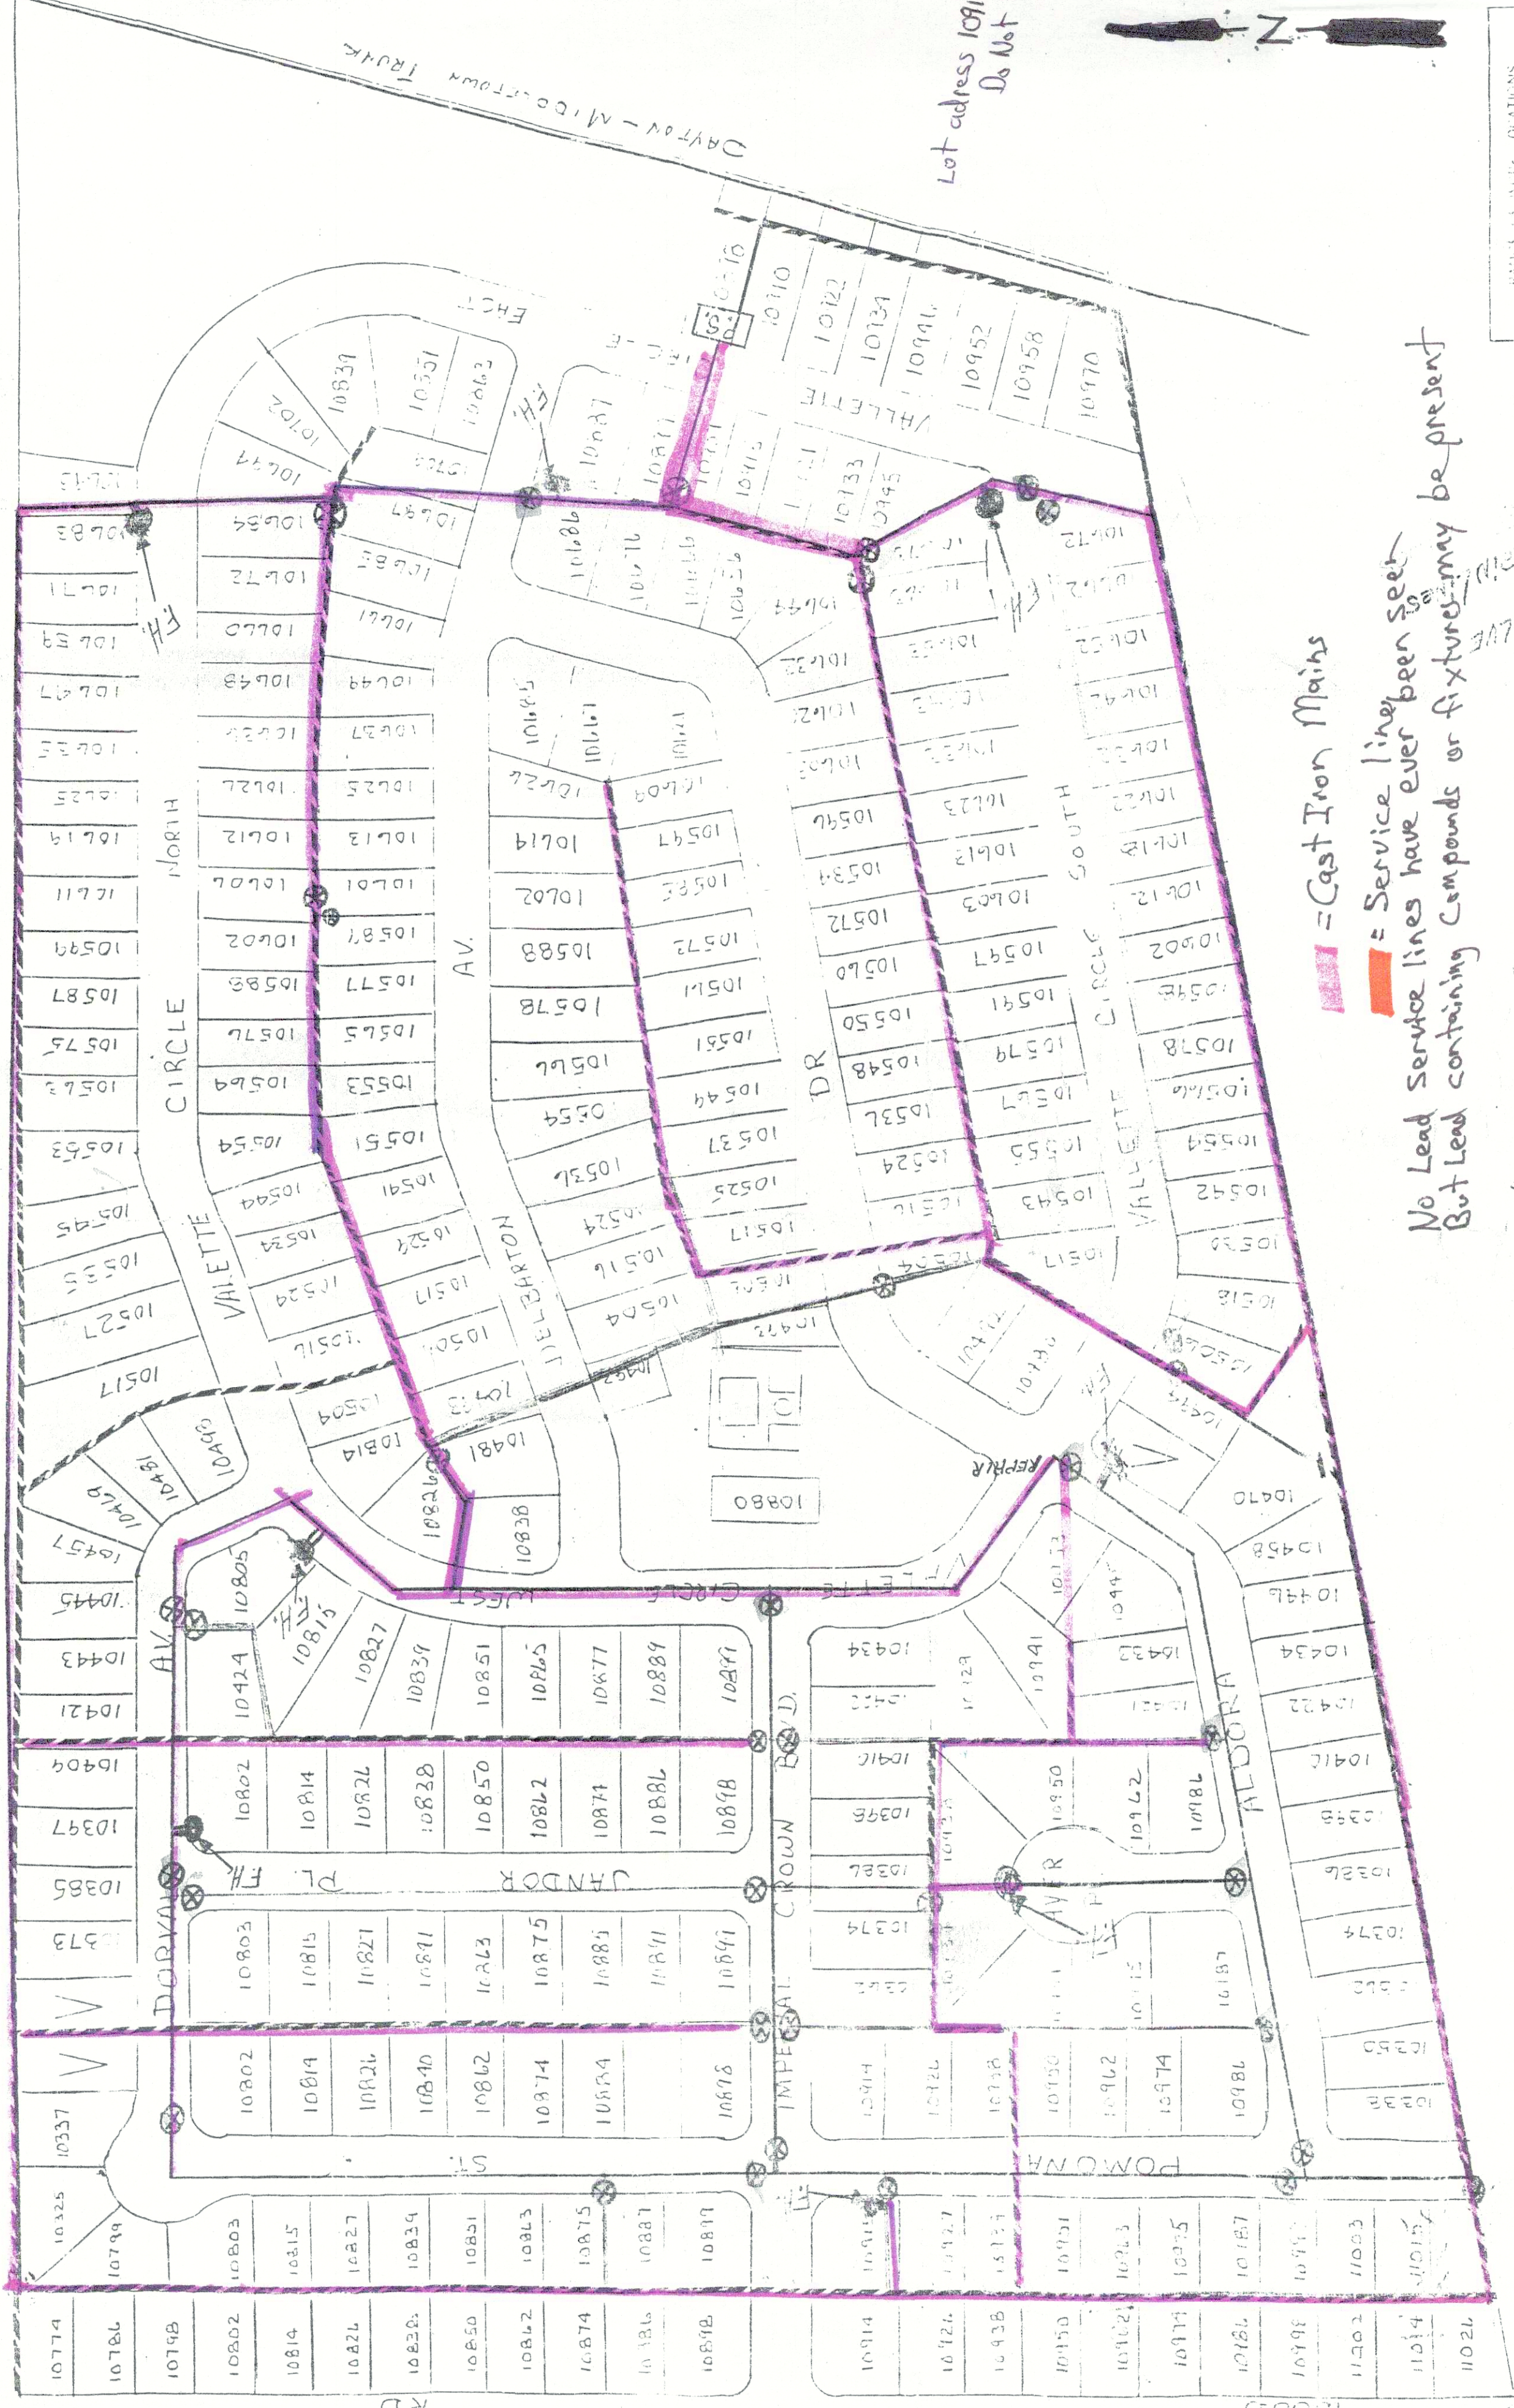


Lot address 10910  
Do Not E

Cast Iron Mains

No Lead service lines have ever been seen  
But Lead containing compounds or fixtures may be present

DATE OF WORK: 04/10/10  
TIME FROM: 10:00  
TIME TO: 12:00  
SPL FROM: 10  
SPL TO: 10  
THE OHIO BELL TELEPHONE CO. 513  
ORDER NO. 513  
DATE: 04/10/10  
SHEET NO. 1

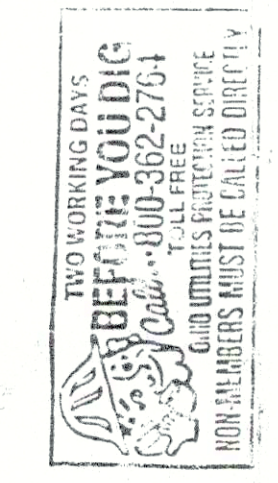

OAKWOOD MOBILE HOME PARK

Phase 4


PWS ID 045703715

Oakwood MHP  
PWS ID



ZONE	REV	DESCRIPTION	DATE	APPROVED

1 2 3 4 5 6 7 8

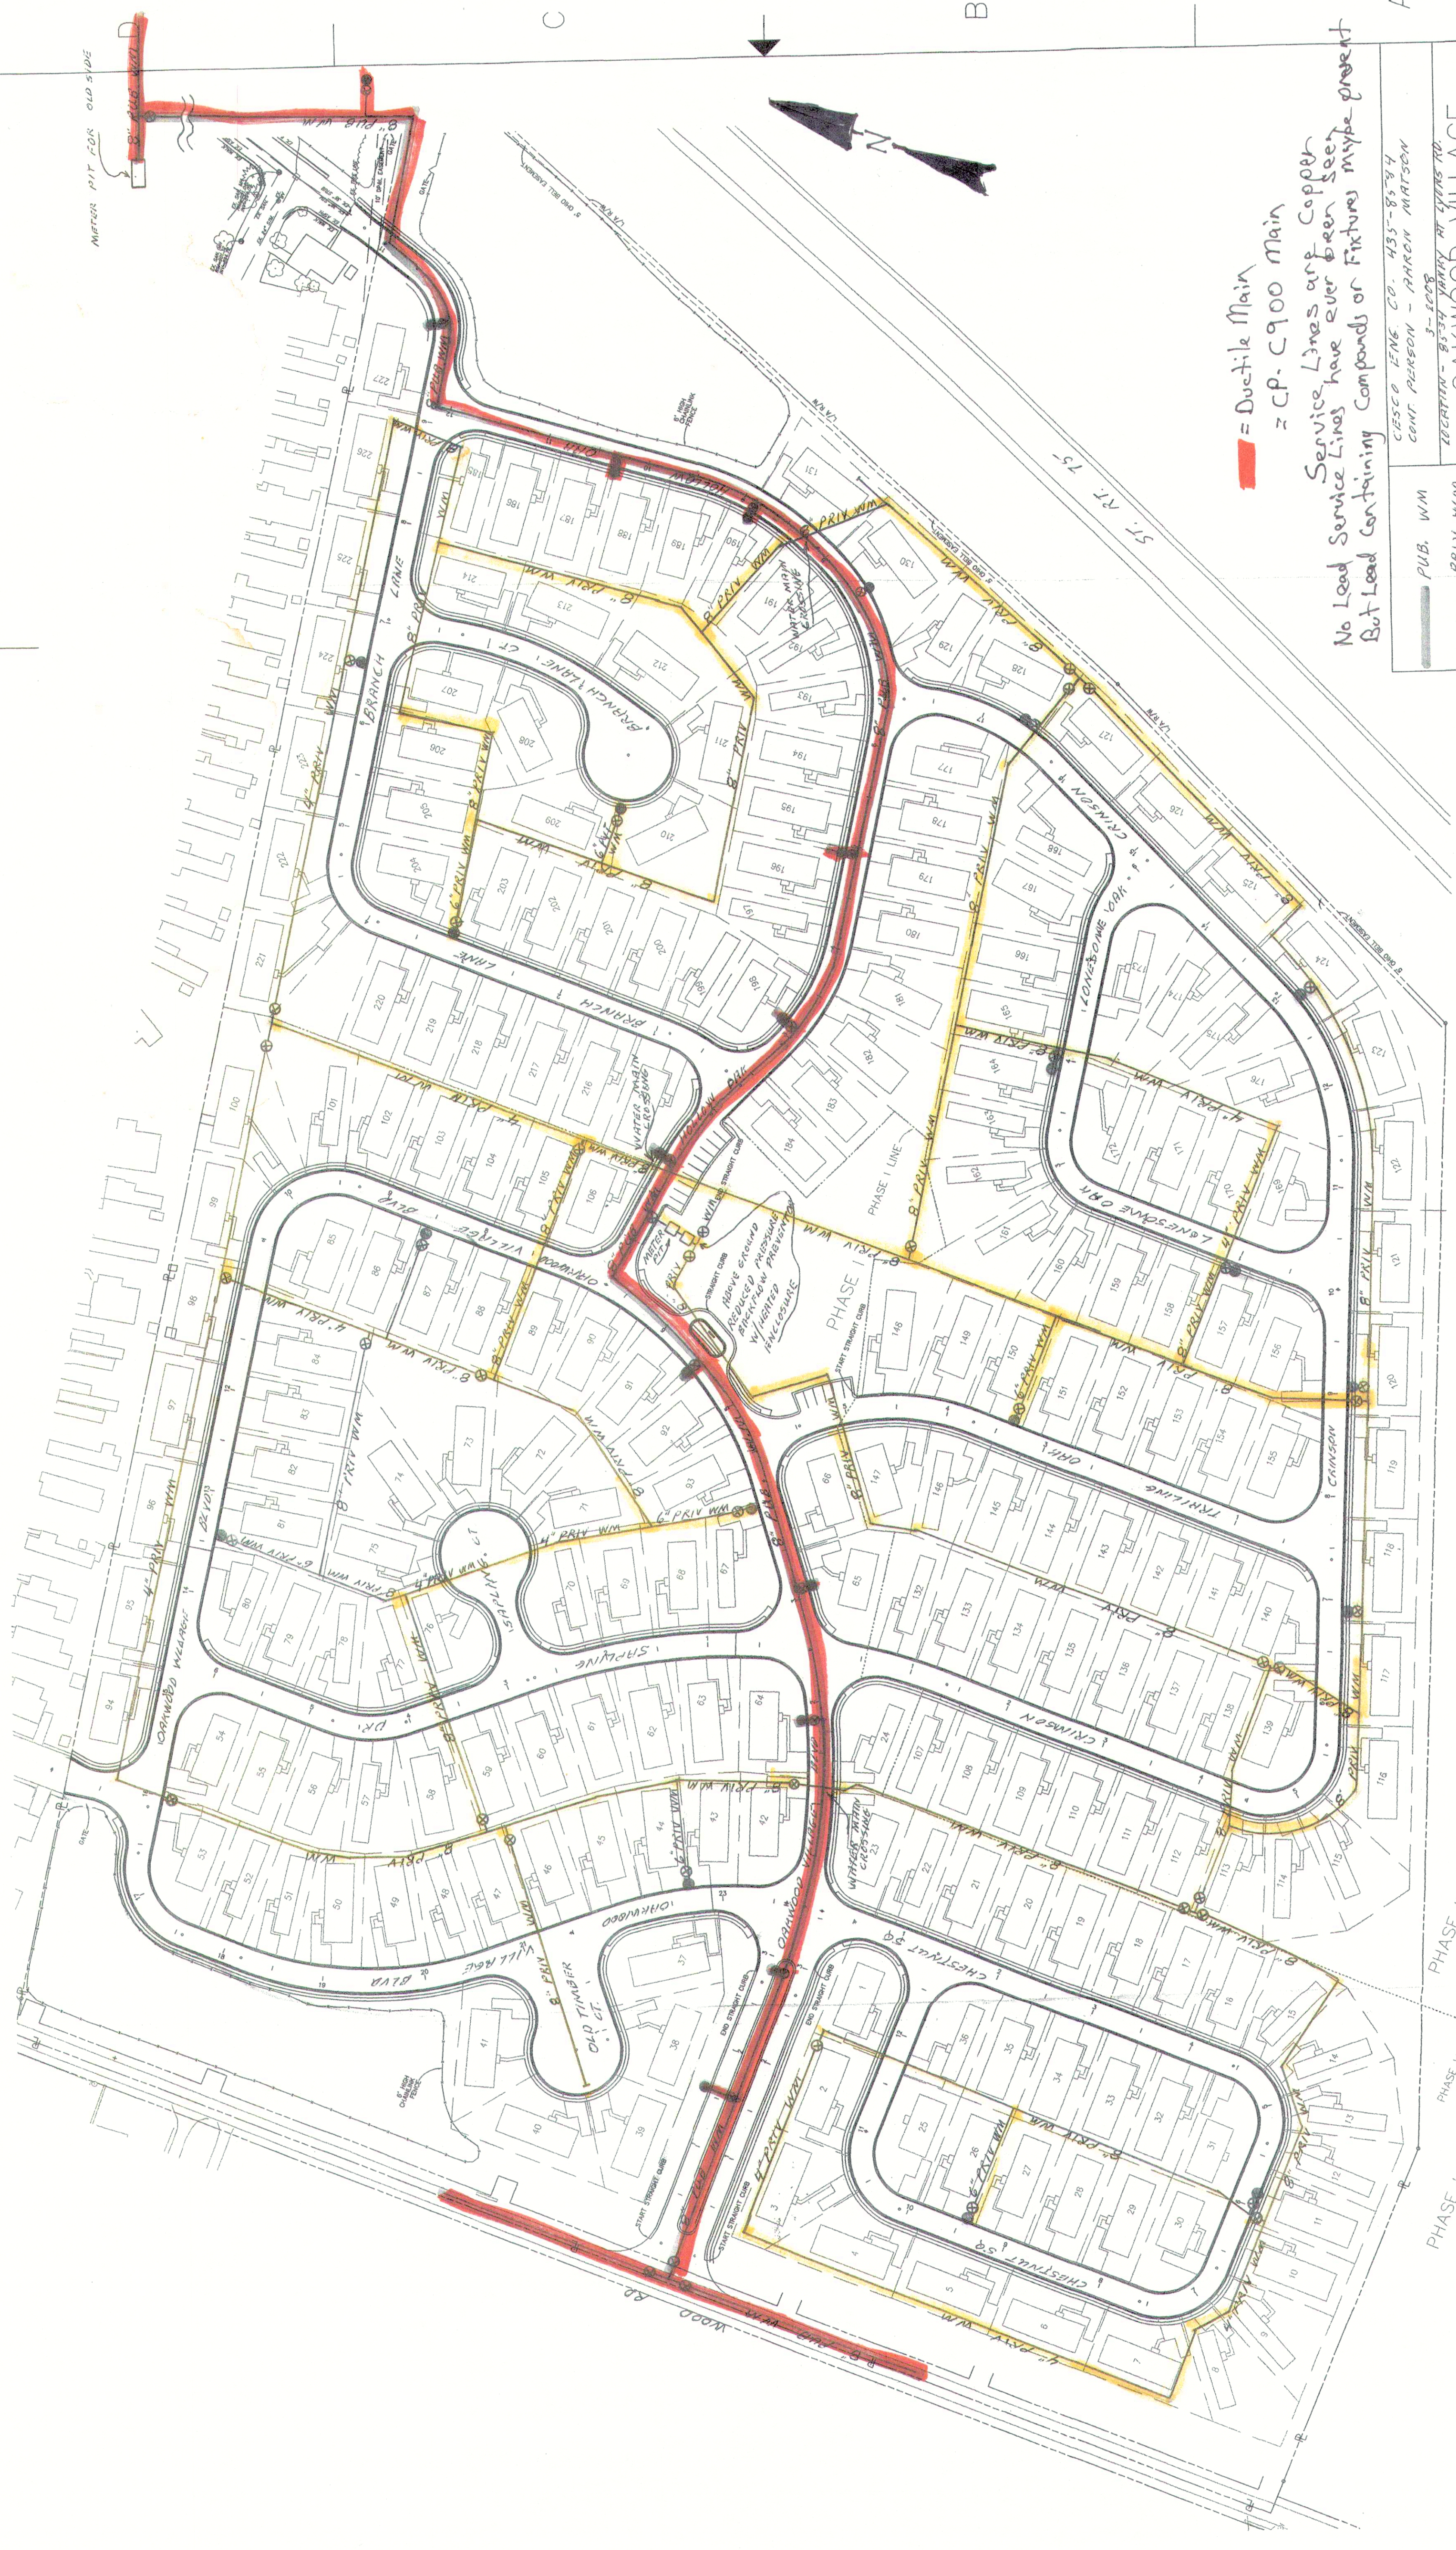

**Red Line** = Ductile Main  
 = CP-C900 Main

No Lead Service Lines are Copper  
 Service Lines have ever been seen  
 But Lead containing compounds or fixtures may be present

PUB. WM	CESCO ENG CO. 435-8594
PRIV. WM	CENT PERSON - HARRON MATSON
	3-1008
	LOCATION - 8534 VANDY AT SPURS RD
	OAKWOOD VILLAGE
	PHASE I & II
	PWS ID - OH 5703715
SIZE	FSM NO.
REV	DWG NO.
SCALE	SHEET

SCALE: 1' = 80'

1 2 3 4 5 6 7 8