


PWS Name: Little Strength C.L.C.
 PWS#: OH1136412

Water system - For Plumbing Study

SITE PLAN / ELEVATIONS

Renewed Strength Church
 Location of
 Little Strength Christian learning Center
 4194 St. Rt. 36 W.
 Westville, Ohio 43083
 Mailing Address: P.O. Box 88
 Westville, Ohio

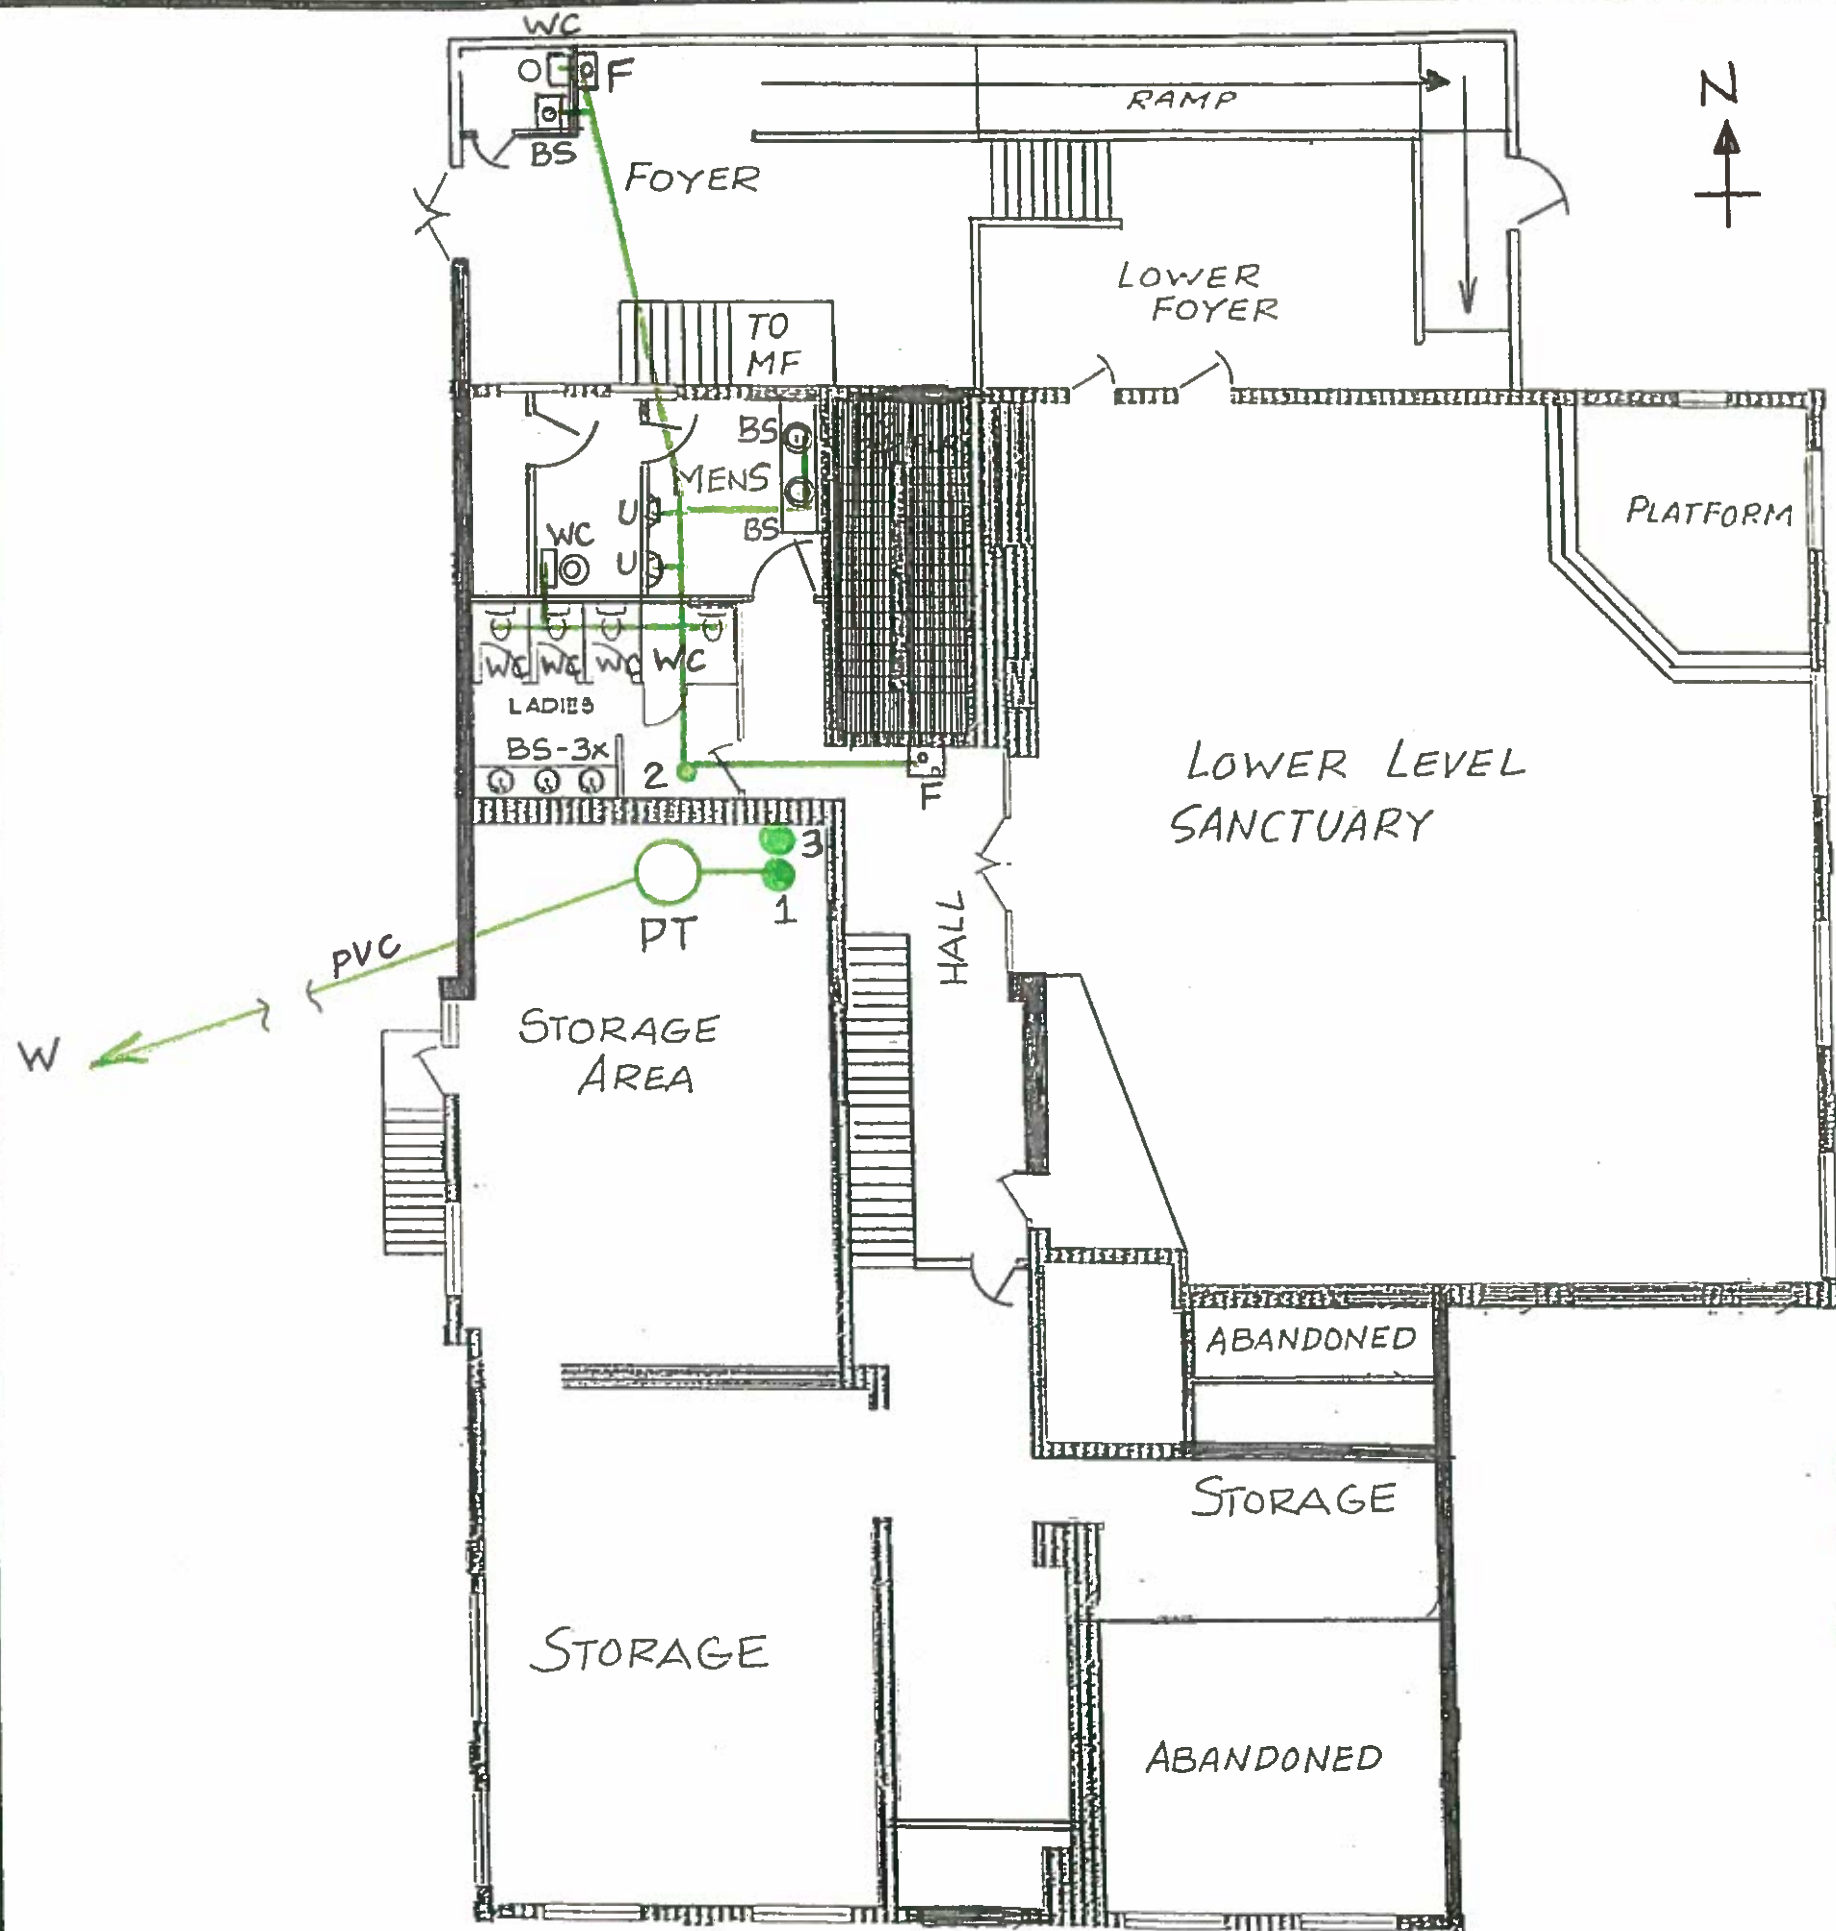

Building Notes:

1. This building was original built in the 1890's. Major additions occurred in the 1920's
2. Westville School met in this building until Graham Schools in Saint Paris, Ohio formed in 1957.
3. Several machine shops and storage were in the building until 1995 when Renewed Strength Church purchased and began a seven year building remodeling project.
4. The building used no old plumbing, HVAC or electrical systems. All was completely installed new.
5. The water well and septic system was installed new and approved by the Ohio EPA.
6. All new usable water piping is lead free copper and lead free solder.
7. Little Strength Christian Learning Center began in June 2002.
8. New well was installed in 2004. Submergible well pump and PVC pipe connects well to building.
9. First Floor remodel completed December 1997.
10. Second Floor remodel completed May 2000.
11. Basement remodel and foyer new construction was completed June 2001.
12. Additional sinks were added in daycare rooms as required after June 2002.

Legend:

W Well Location (cold)	MS Mop Sink (cold and hot)
PT Pressure Tank (cold)	HW Hot Water Tank
BFP Backflow Preventer (cold)	WC Toilet (cold)
F Drinking Fountains (cold)	BS Bathroom Sink
KS Kitchen Sink (cold and hot)	U Urinal (cold)
S Showers (cold and hot)	WS Water Softener
Copper Water Lines	PVC Water Line

- 1 Water piping travels to 1st floor
- 2 Water piping travels to 2nd floor
- 3 Water piping travels to basement

Water system - For Plumbing Study

BASEMENT

Renewed Strength Church

Location of


Little Strength Christian learning Center

4194 St. Rt. 36 W.

Westville, Ohio 43083

Mailing Address: P.O. Box 88

Westville, Ohio

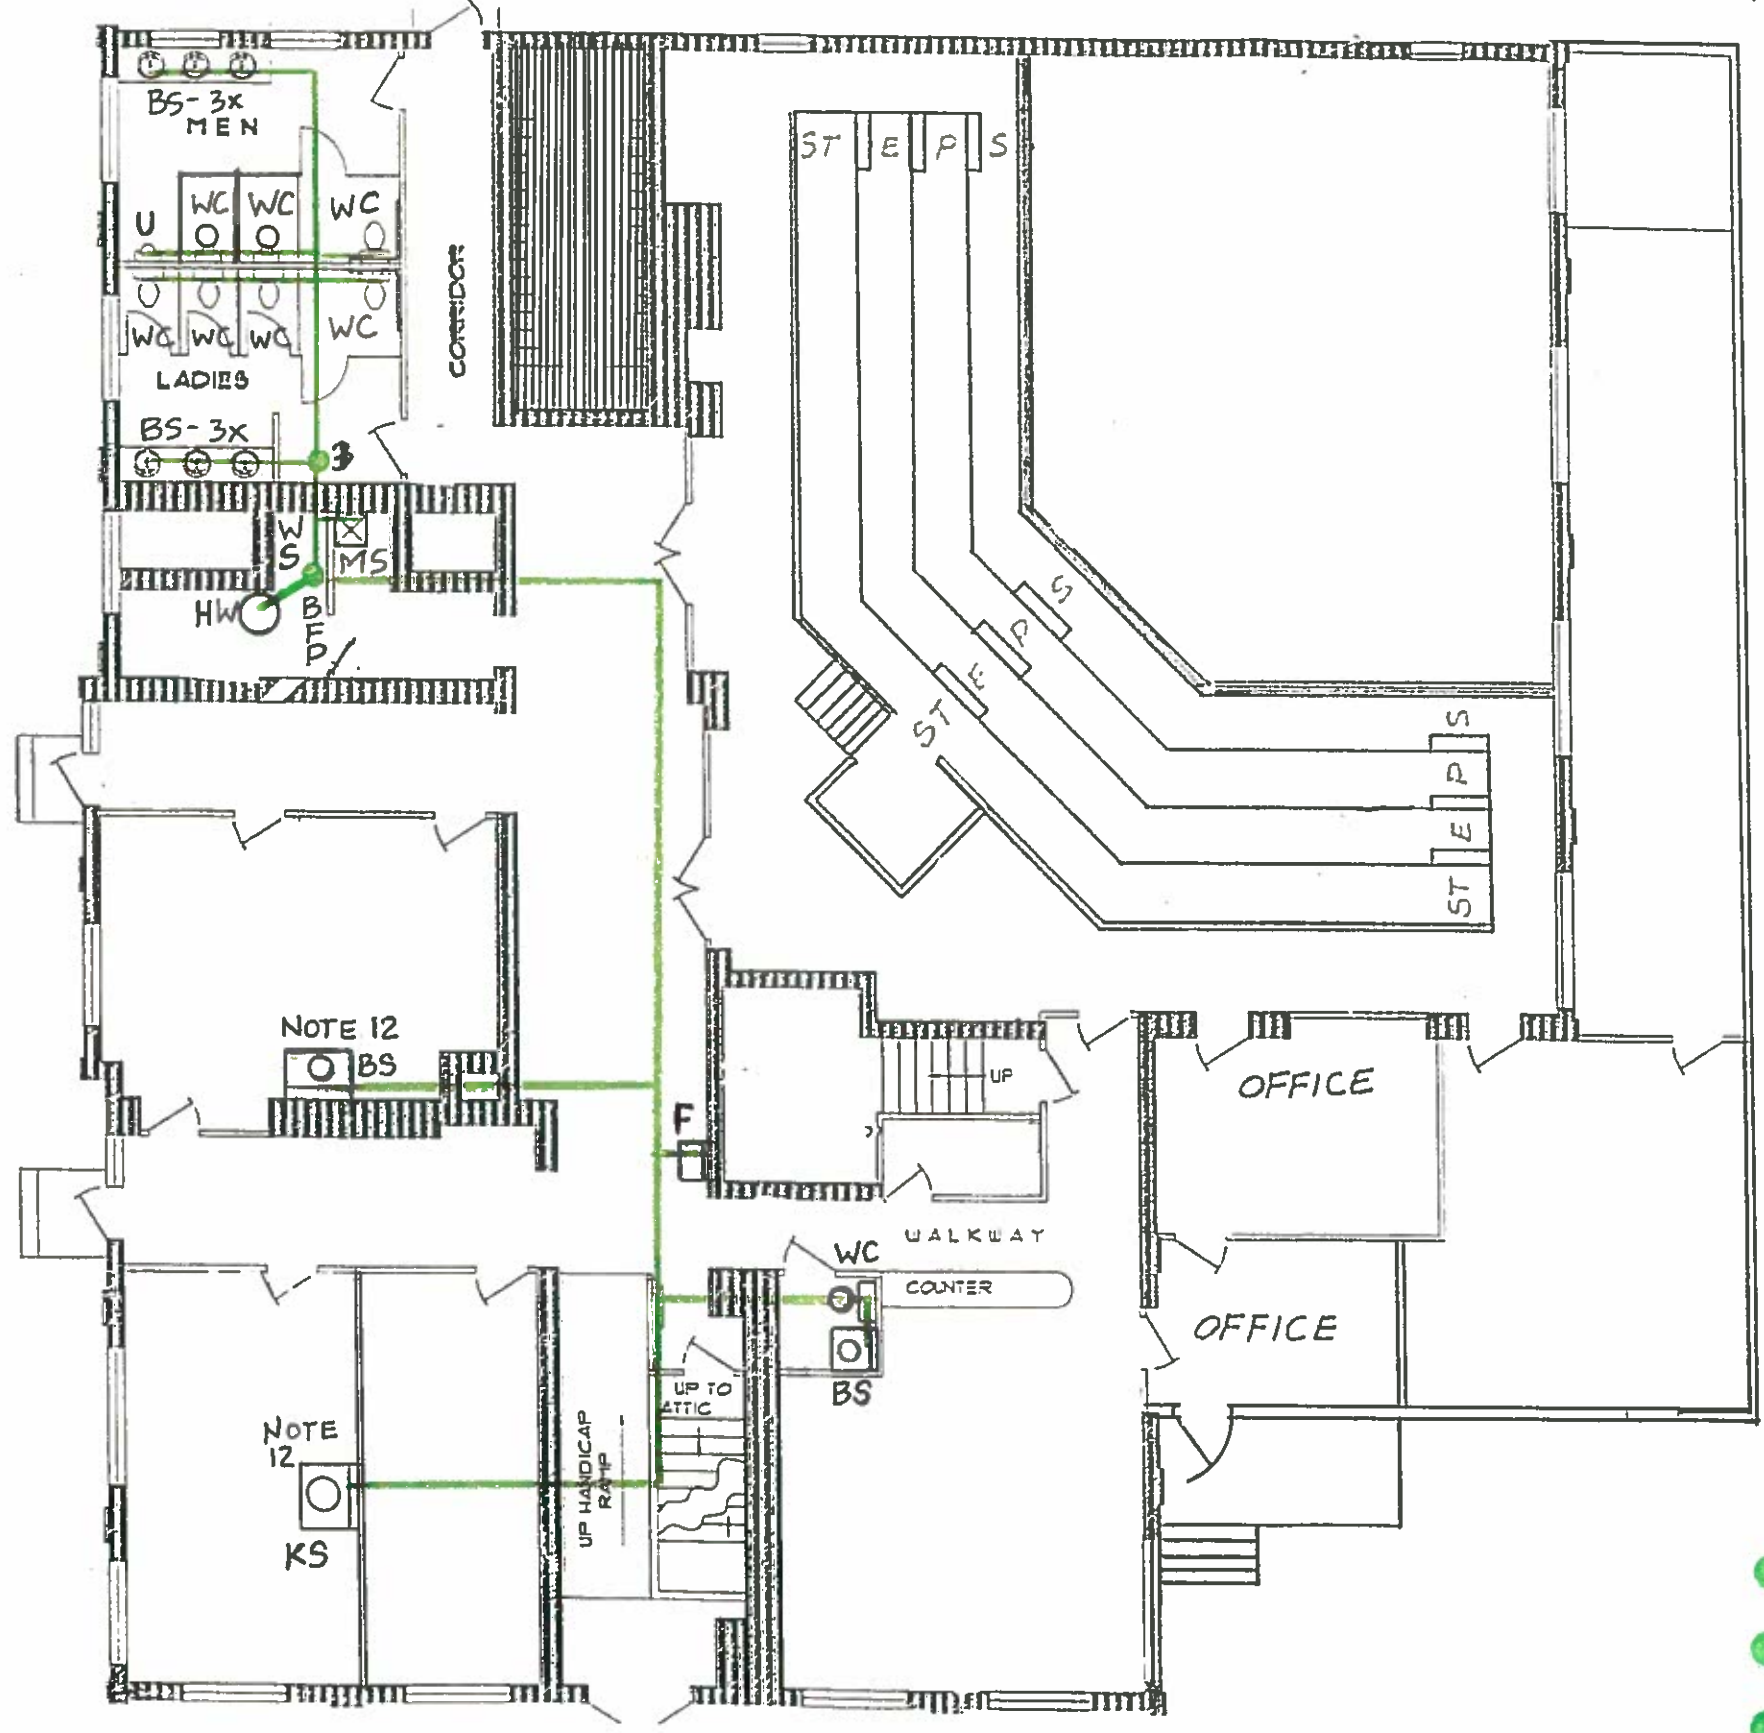

Building Notes:


1. This building was original built in the 1890's. Major additions occurred in the 1920's
2. Westville School met in this building until Graham Schools in Saint Paris, Ohio formed in 1957.
3. Several machine shops and storage were in the building until 1995 when Renewed Strength Church purchased and began a seven year building remodeling project.
4. The building used no old plumbing, HVAC or electrical systems. All was completely installed new.
5. The water well and septic system was installed new and approved by the Ohio EPA.
6. All new usable water piping is lead free copper and lead free solder.
7. Little Strength Christian Learning Center began in June 2002.
8. New well was installed in 2004. Submersible well pump and PVC pipe connects well to building.
9. First Floor remodel completed December 1997.
10. Second Floor remodel completed May 2000.
11. Basement remodel and foyer new construction was completed June 2001.
12. Additional sinks were added in daycare rooms as required after June 2002.

Legend:

W Well Location (cold)	MS Mop Sink (cold and hot)
PT Pressure Tank (cold)	HW Hot Water Tank
BFP Backflow Preventer (cold)	WC Toilet (cold)
F Drinking Fountains (cold)	BS Bathroom Sink (cold)
KS Kitchen Sink (cold and hot)	U Urinal (cold)
S Showers (cold and hot)	WS Water Softener
Copper Water Lines	PVC Water Line

- 1 Water piping travels to 1st floor
- 2 Water piping travels to 2nd floor
- 3 Water piping travels to basement

Water system - For Plumbing Study
FIRST FLOOR
Renewed Strength Church Location of Little Strength Christian learning Center 4194 St. Rt. 36 W. Westville, Ohio 43083 Mailing Address: P.O. Box 88 Westville, Ohio

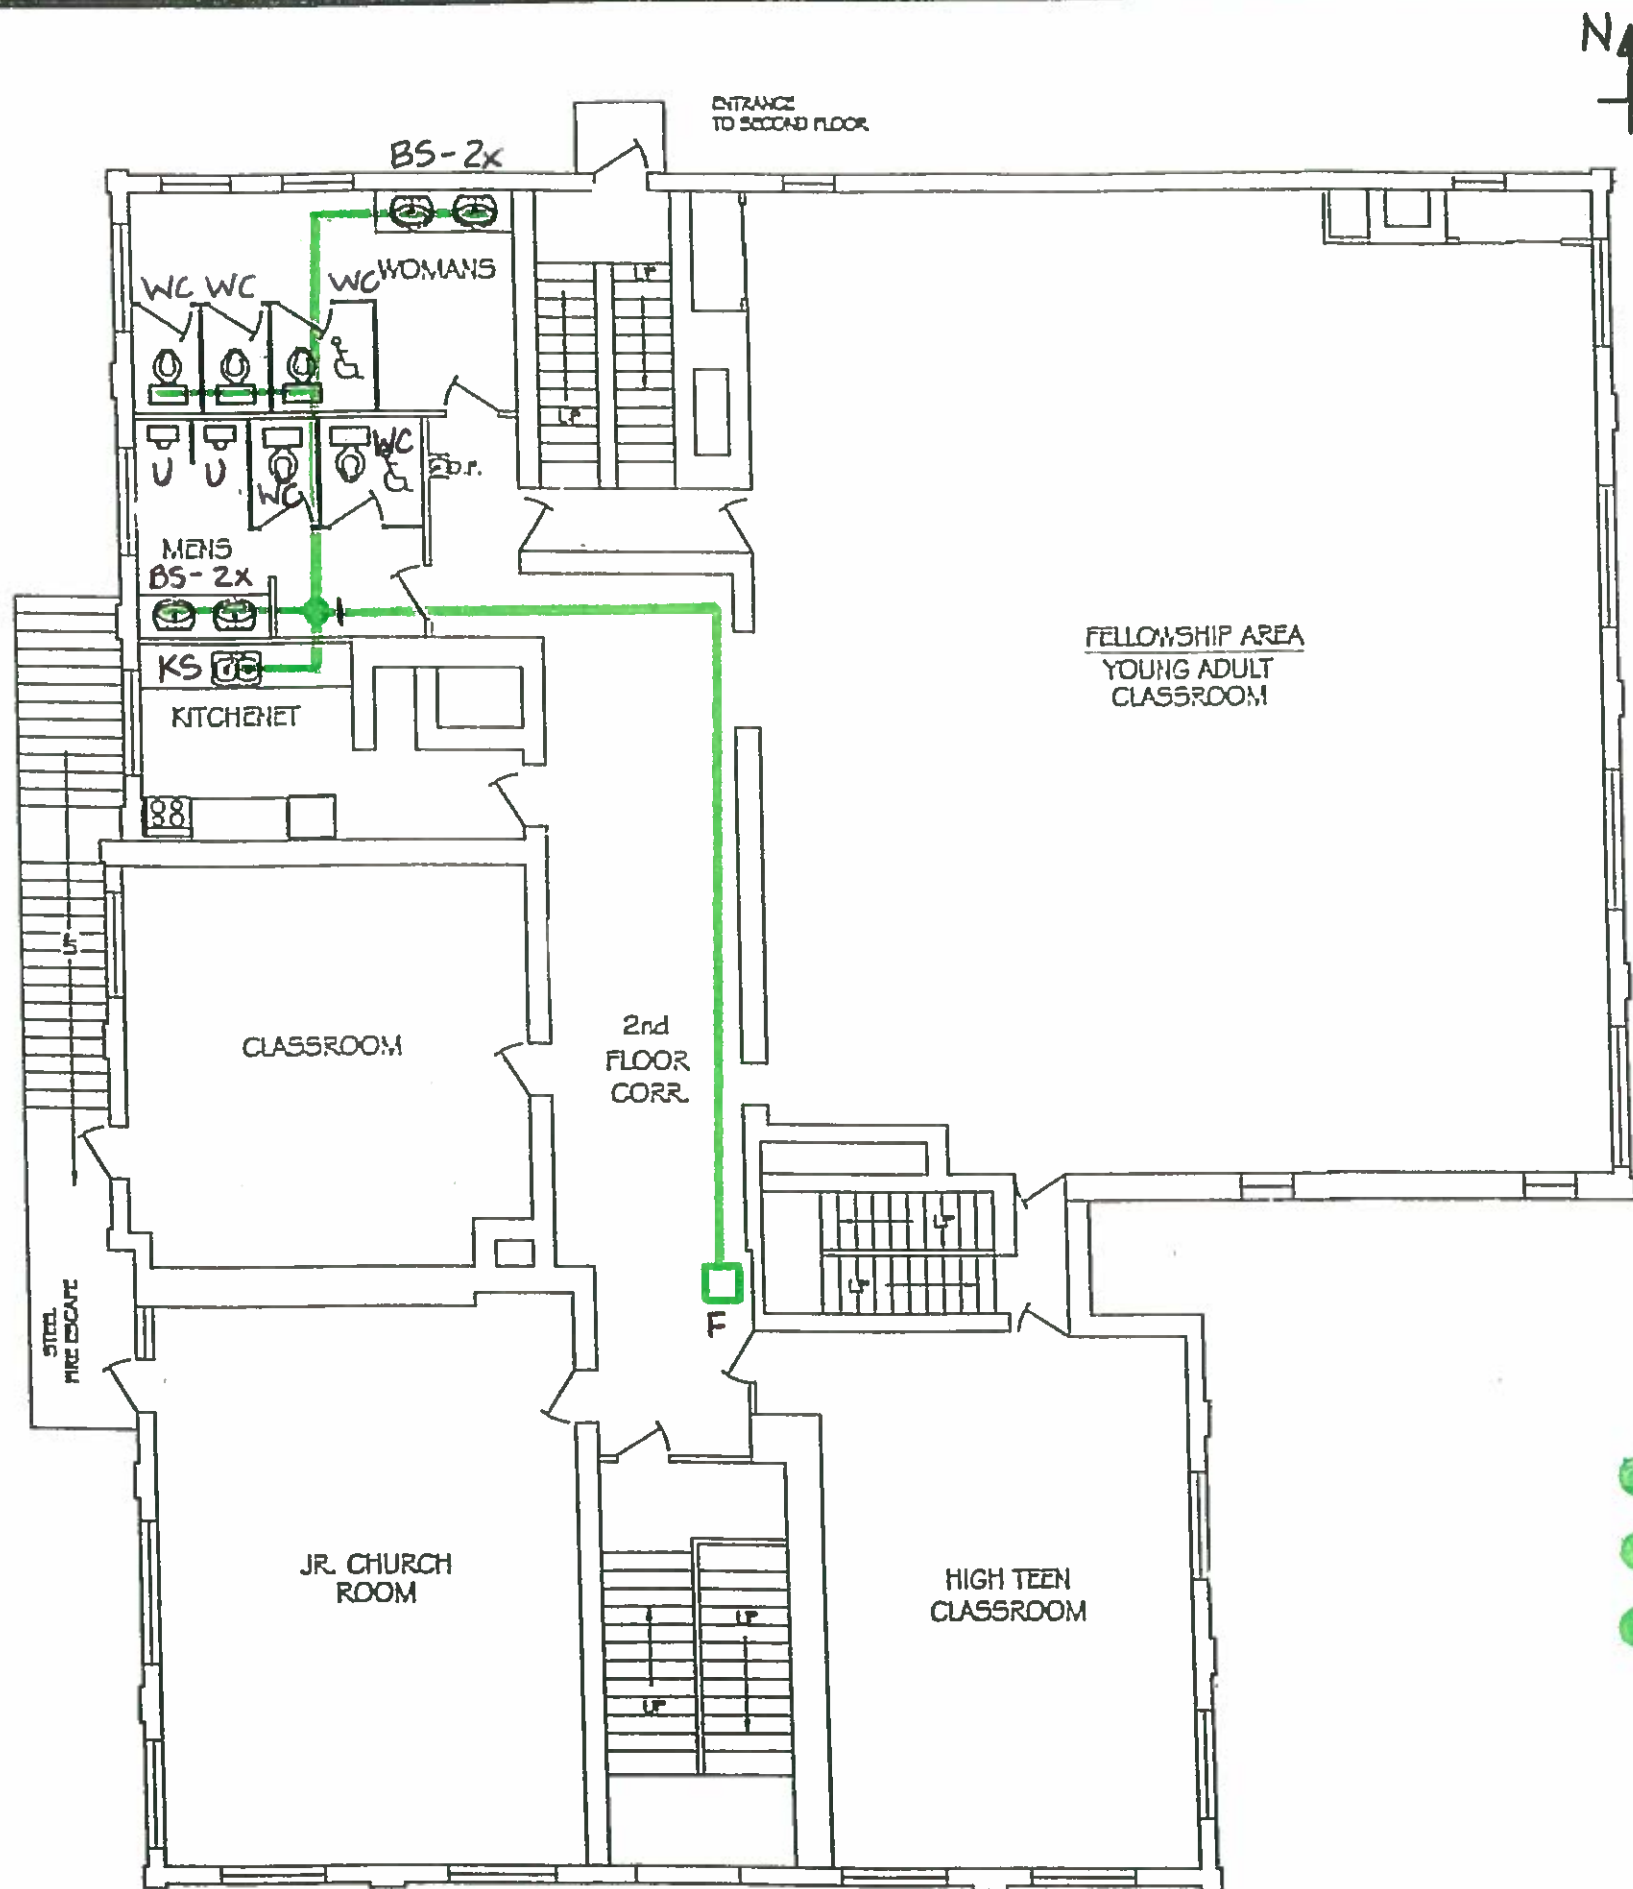

Building Notes:

1. This building was original built in the 1890's. Major additions occurred in the 1920's
2. Westville School met in this building until Graham Schools in Saint Paris, Ohio formed in 1957.
3. Several machine shops and storage were in the building until 1995 when Renewed Strength Church purchased and began a seven year building remodeling project.
4. The building used no old plumbing, HVAC or electrical systems. All was completely installed new.
5. The water well and septic system was installed new and approved by the Ohio EPA.
6. All new usable water piping is lead free copper and lead free solder.
7. Little Strength Christian Learning Center began in June 2002.
8. New well was installed in 2004. Submergible well pump and PVC pipe connects well to building.
9. First Floor remodel completed December 1997.
10. Second Floor remodel completed May 2000.
11. Basement remodel and foyer new construction was completed June 2001.
12. Additional sinks were added in daycare rooms as required after June 2002.

Legend:

W	Well Location (cold)	MS	Mop Sink (cold and hot)
PT	Pressure Tank (cold)	HW	Hot Water Tank
BFP	Backflow Preventer (cold)	WC	Toilet (cold)
F	Drinking Fountains (cold)	BS	Bathroom Sink (cold)
KS	Kitchen Sink (cold and hot)	U	Urinal (cold)
S	Showers (cold and hot)	WS	Water Softener
- - - - - Copper Water Lines		- - - - - PVC Water Line	

- 1 Water piping travels to 1st floor
- 2 Water piping travels to 2nd floor
- 3 Water piping travels to basement

Water system - For Plumbing Study

SECOND FLOOR

Renewed Strength Church

Location of

Little Strength Christian learning Center

4194 St. Rt. 36 W.

Westville, Ohio 43083

Mailing Address: P.O. Box 88

Westville, Ohio 4 OF 4