

To Ohio EPA DDGW  
From WCharlestonChurch of the Brethren  
4817 S State 202, TippCity, Oh 45371

RECEIVED  
OHIO EPA

MAR 01 2017

Southwest District


Lead/Copper Monitoring Points:

- 1 Vestibule Sink
- 2 Kitchen Sink
- 3 Men's Rest Room
- 4 Women's Rest Room
- 5 Youth Rest Room

Description of Plumbing Fixtures:

As to all of the plumbing fixtures installed in this building, we do not have specific information on the lead content of these fixtures. However, this building was newly constructed in 2011 and all fixtures, pipes, fittings and lead-free flux which were incorporated into this building are in compliance with the Safe Drinking Water Act of 1986. In addition, there have been no repairs to the entire plumbing system since construction was completed.


Respectfully submitted,

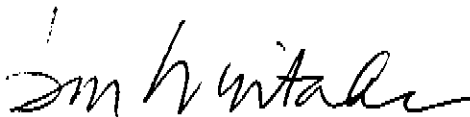

Don Whitaker  
February 28, 2017

RECEIVED  
OHIO EPA  
MAR 01 2017

- LEGEND**
- PEX - Propylene Plumbing
  - (S) - Sink
  - (T) - Toilet
  - (DF) - Drinking Fountain
  - Hot water
  - Cold Water
  - Pb/Cu Monitoring Points

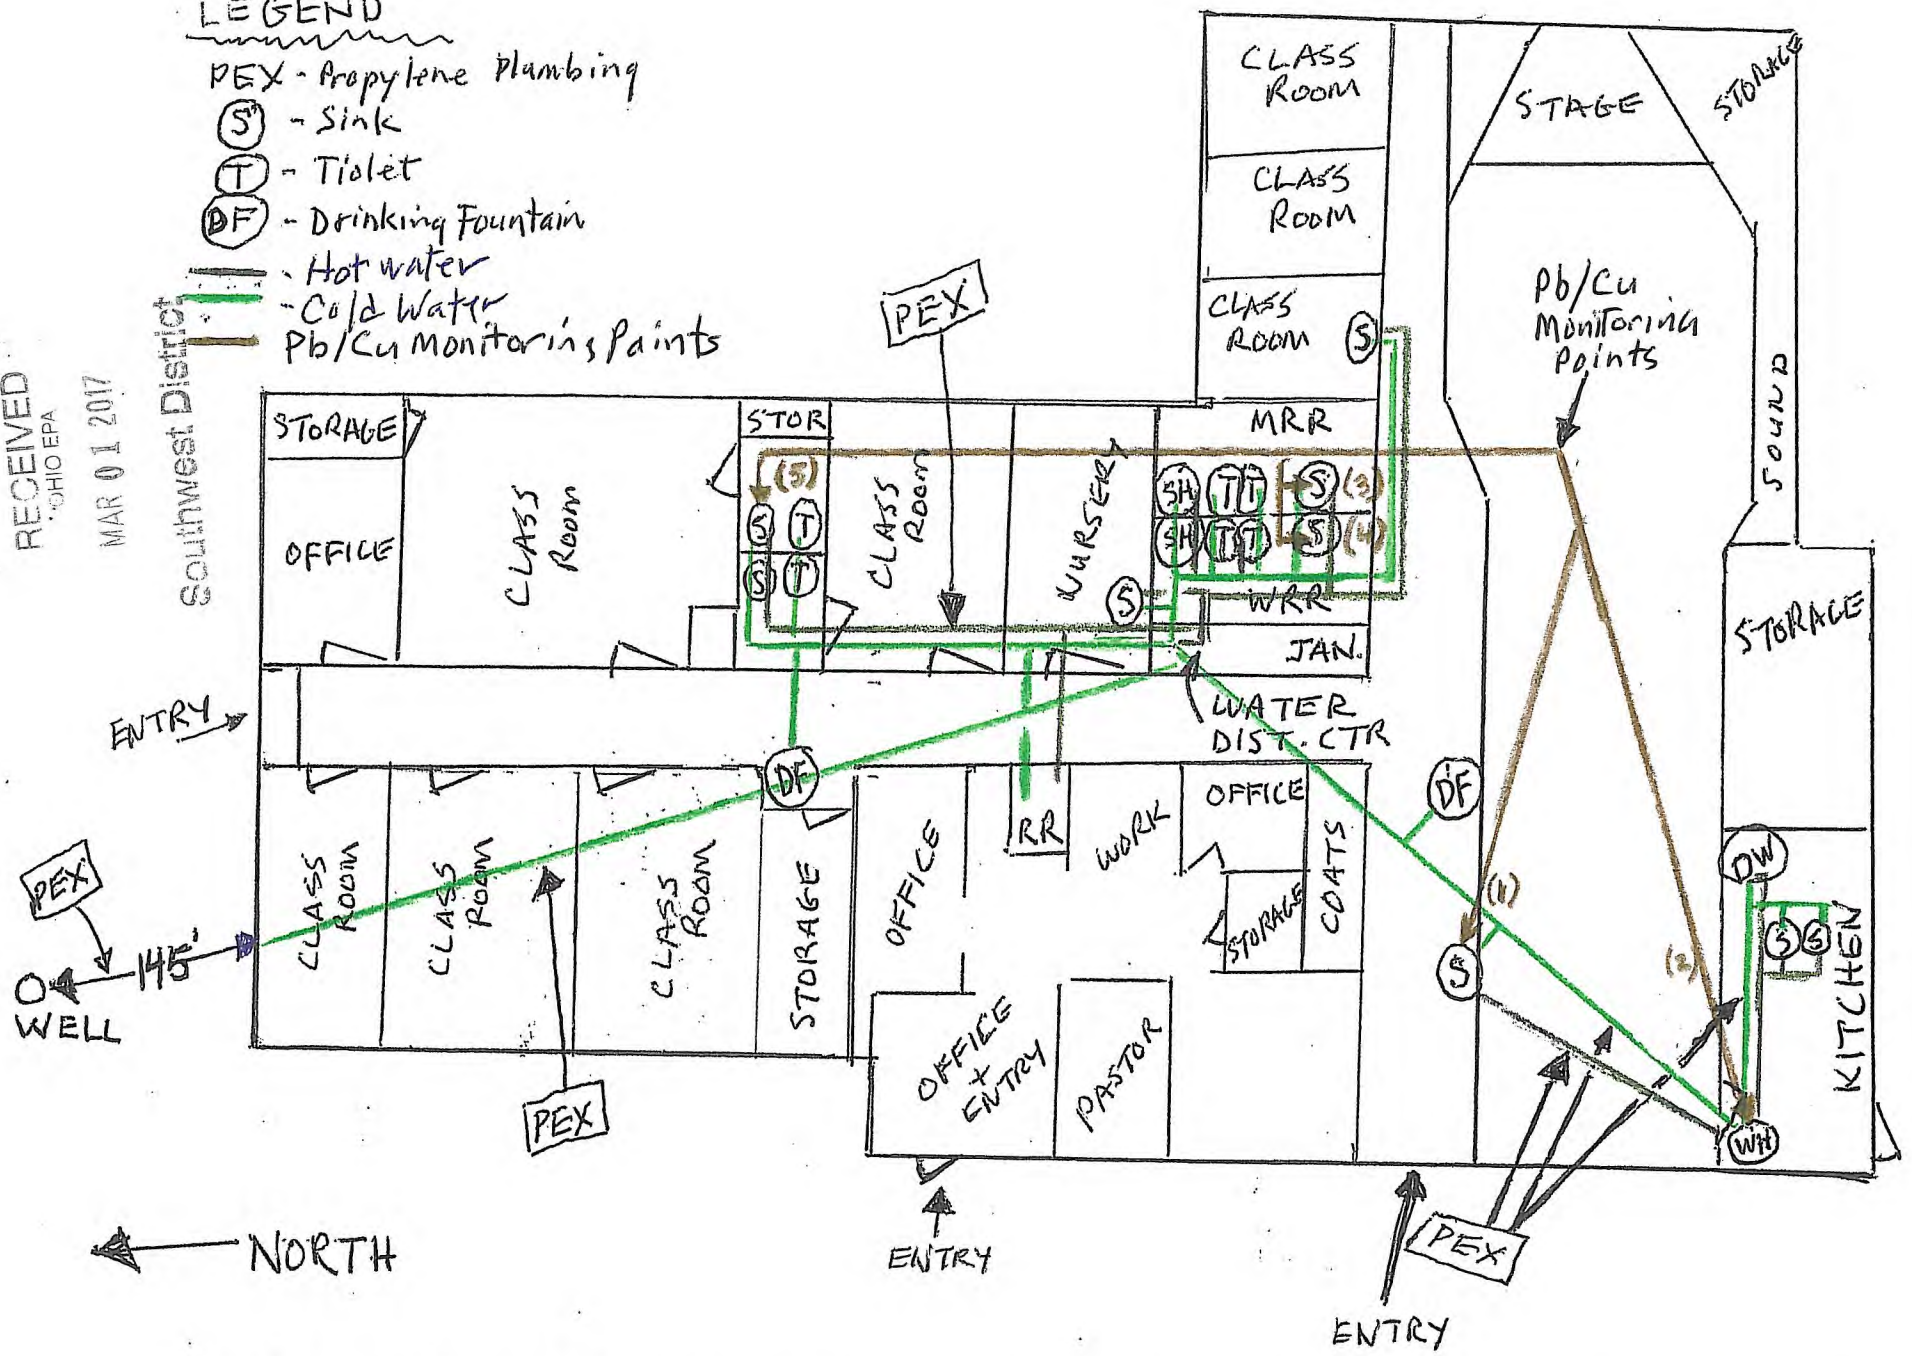

WEST CHARLESTON CHURCH OF THE BRETHREN - CONSTRUCTED 2011  
4817 N. STATE 202, TIPP CITY, OH 45371