



Waterloo Local Schools

March 7, 2017

Ohio Environmental Protection Agency
P.O. Box 1049
Columbus, Ohio 43216



To Whom It May Concern:

Please find enclosed a mapping of Waterloo Local Schools water lines as required to be submitted per the Ohio EPA.

The blue outlined section in the High School, which was constructed in 1968 and renovated in 2003. The water lines are copper with soldered joints. The highlighted green areas are where piping was not replaced during renovations.


The orange outlined section is the K-8 facility which was constructed with new material in 2003. All water lines are copper with solder or compression fittings.

The school building faces to the west toward Industry Rd., State Route 224 is to the North, Waterloo Rd. is to the south, and State Route 183 is to the East.

If you have any questions, please feel free to contact me.

Sincerely,


Shawn Braman
Superintendent
Waterloo Local Schools

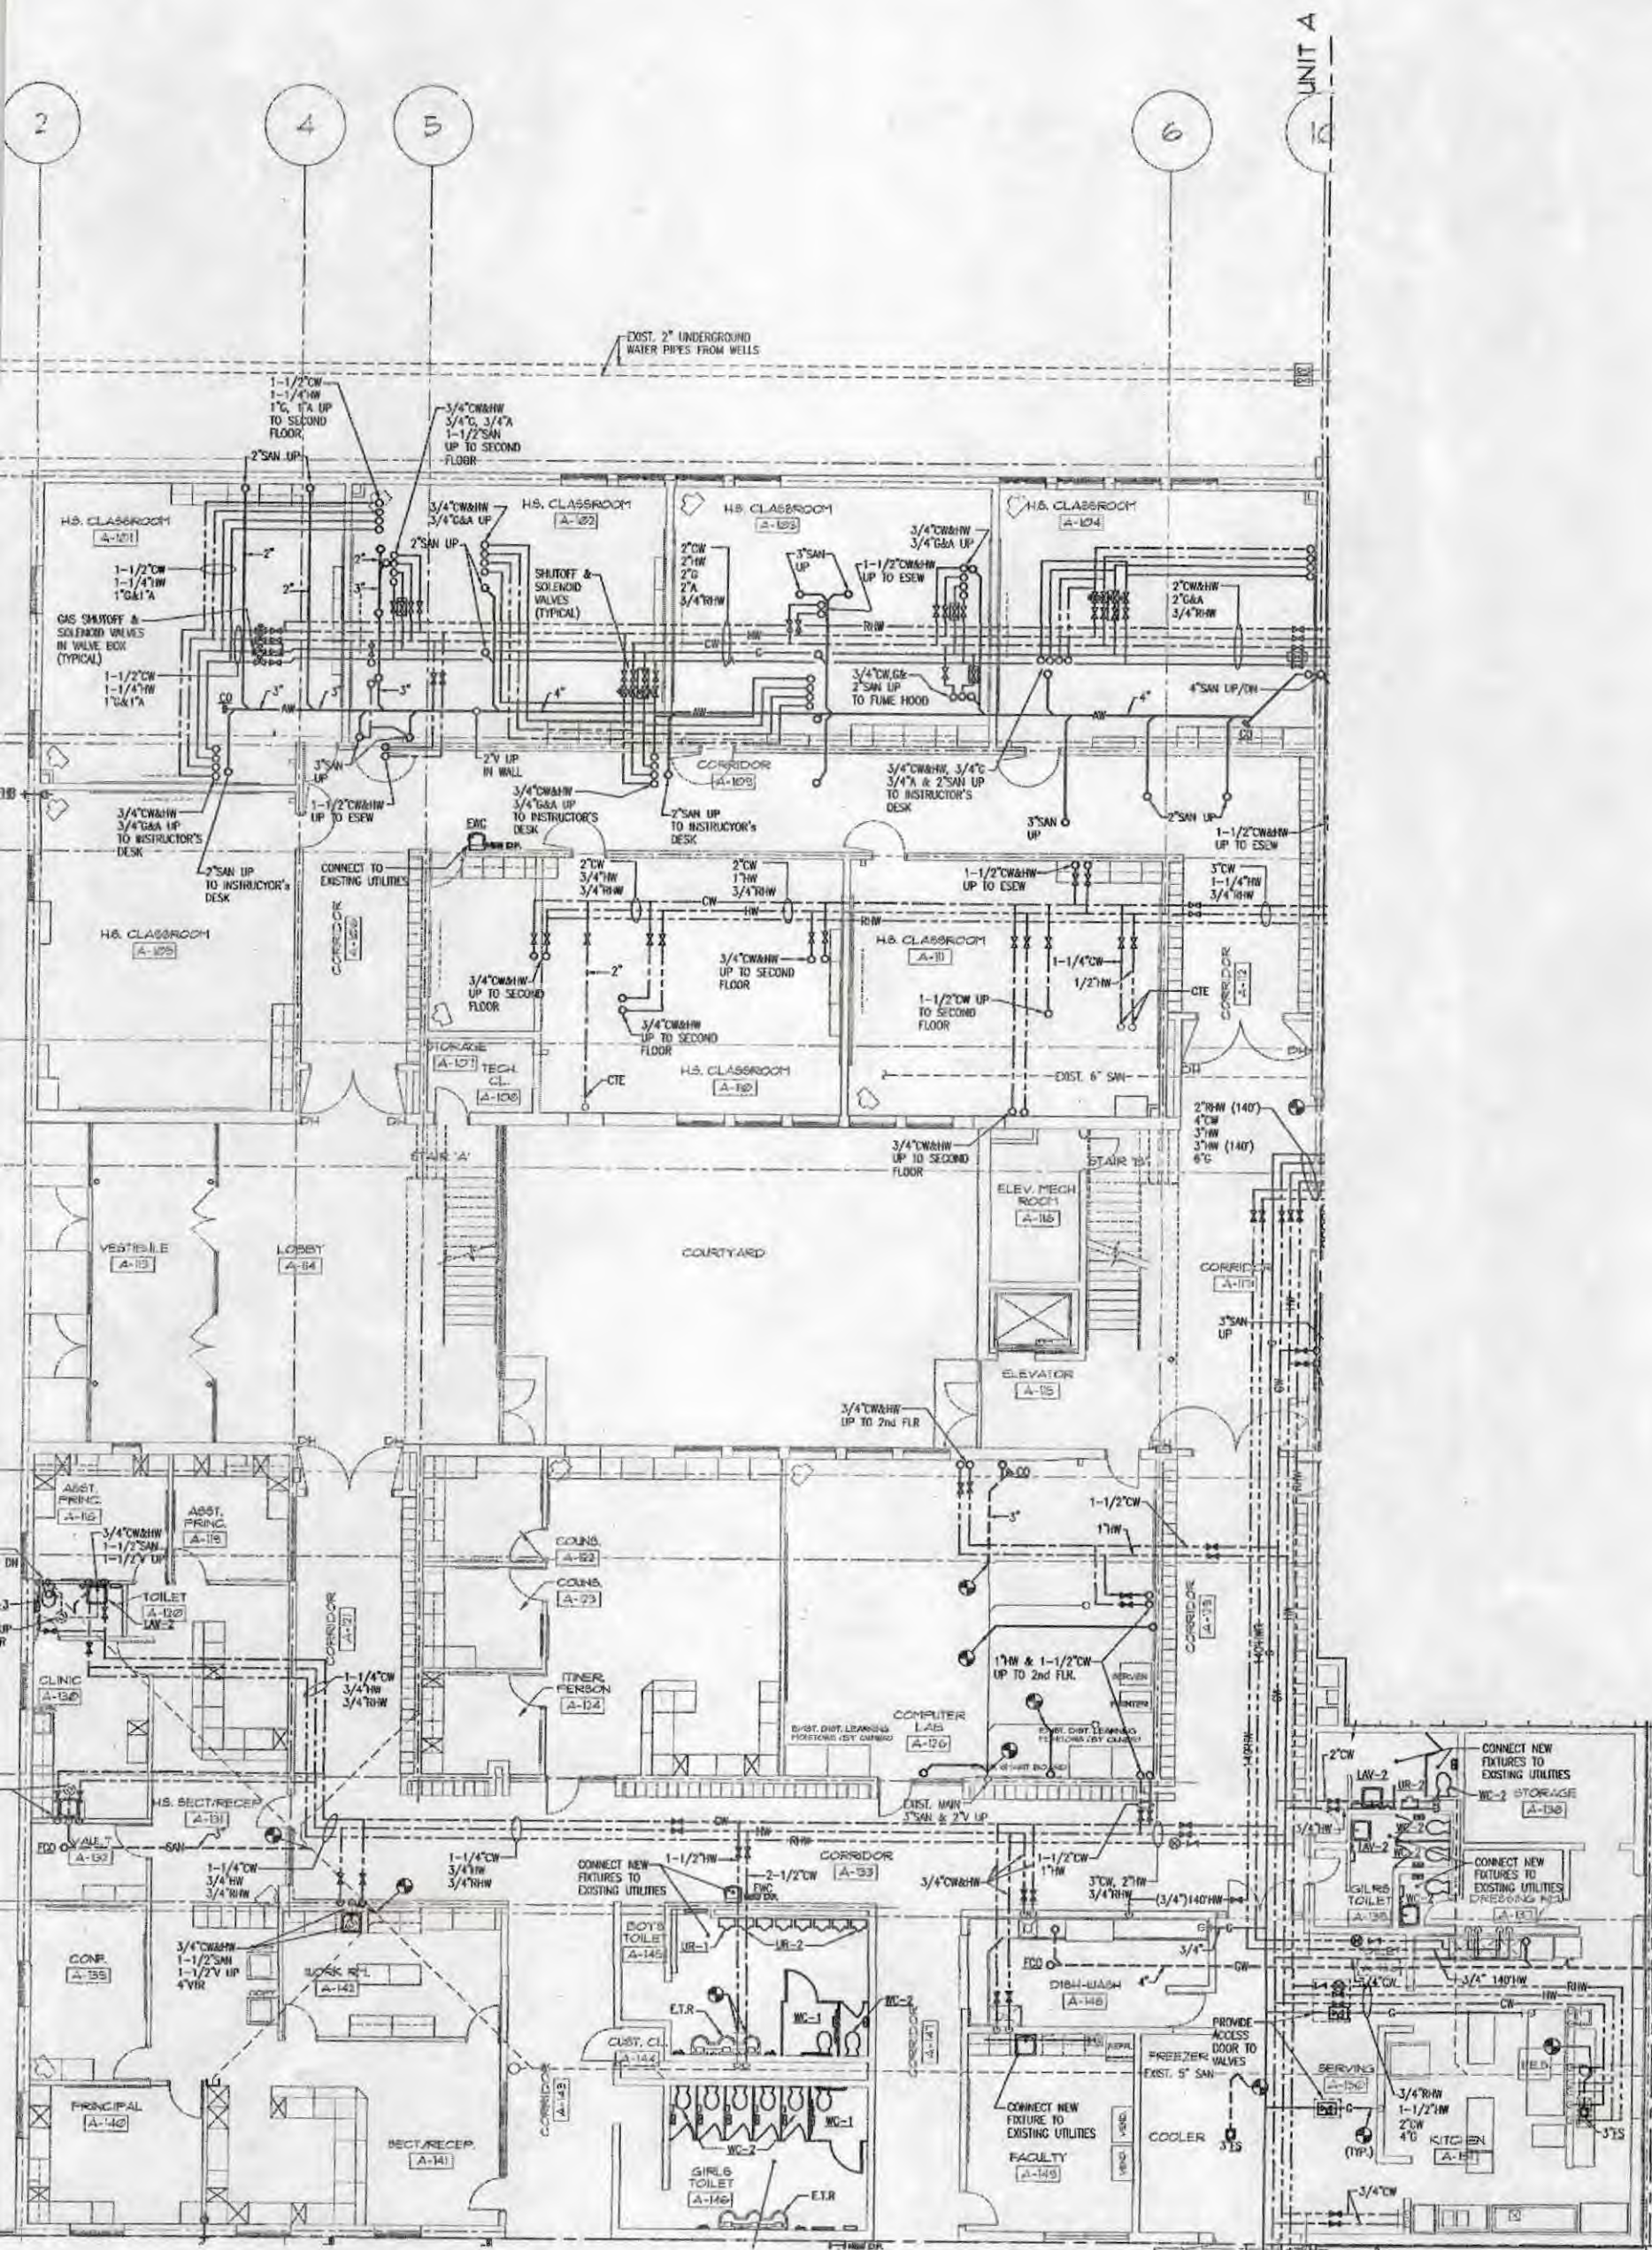


RECEIVED
 MAR 13 2017
 Central District Office
 Ohio EPA

FIRST FLOOR PLUMBING PLAN UNIT "A"
 SCALE: 1/8"=1'-0"



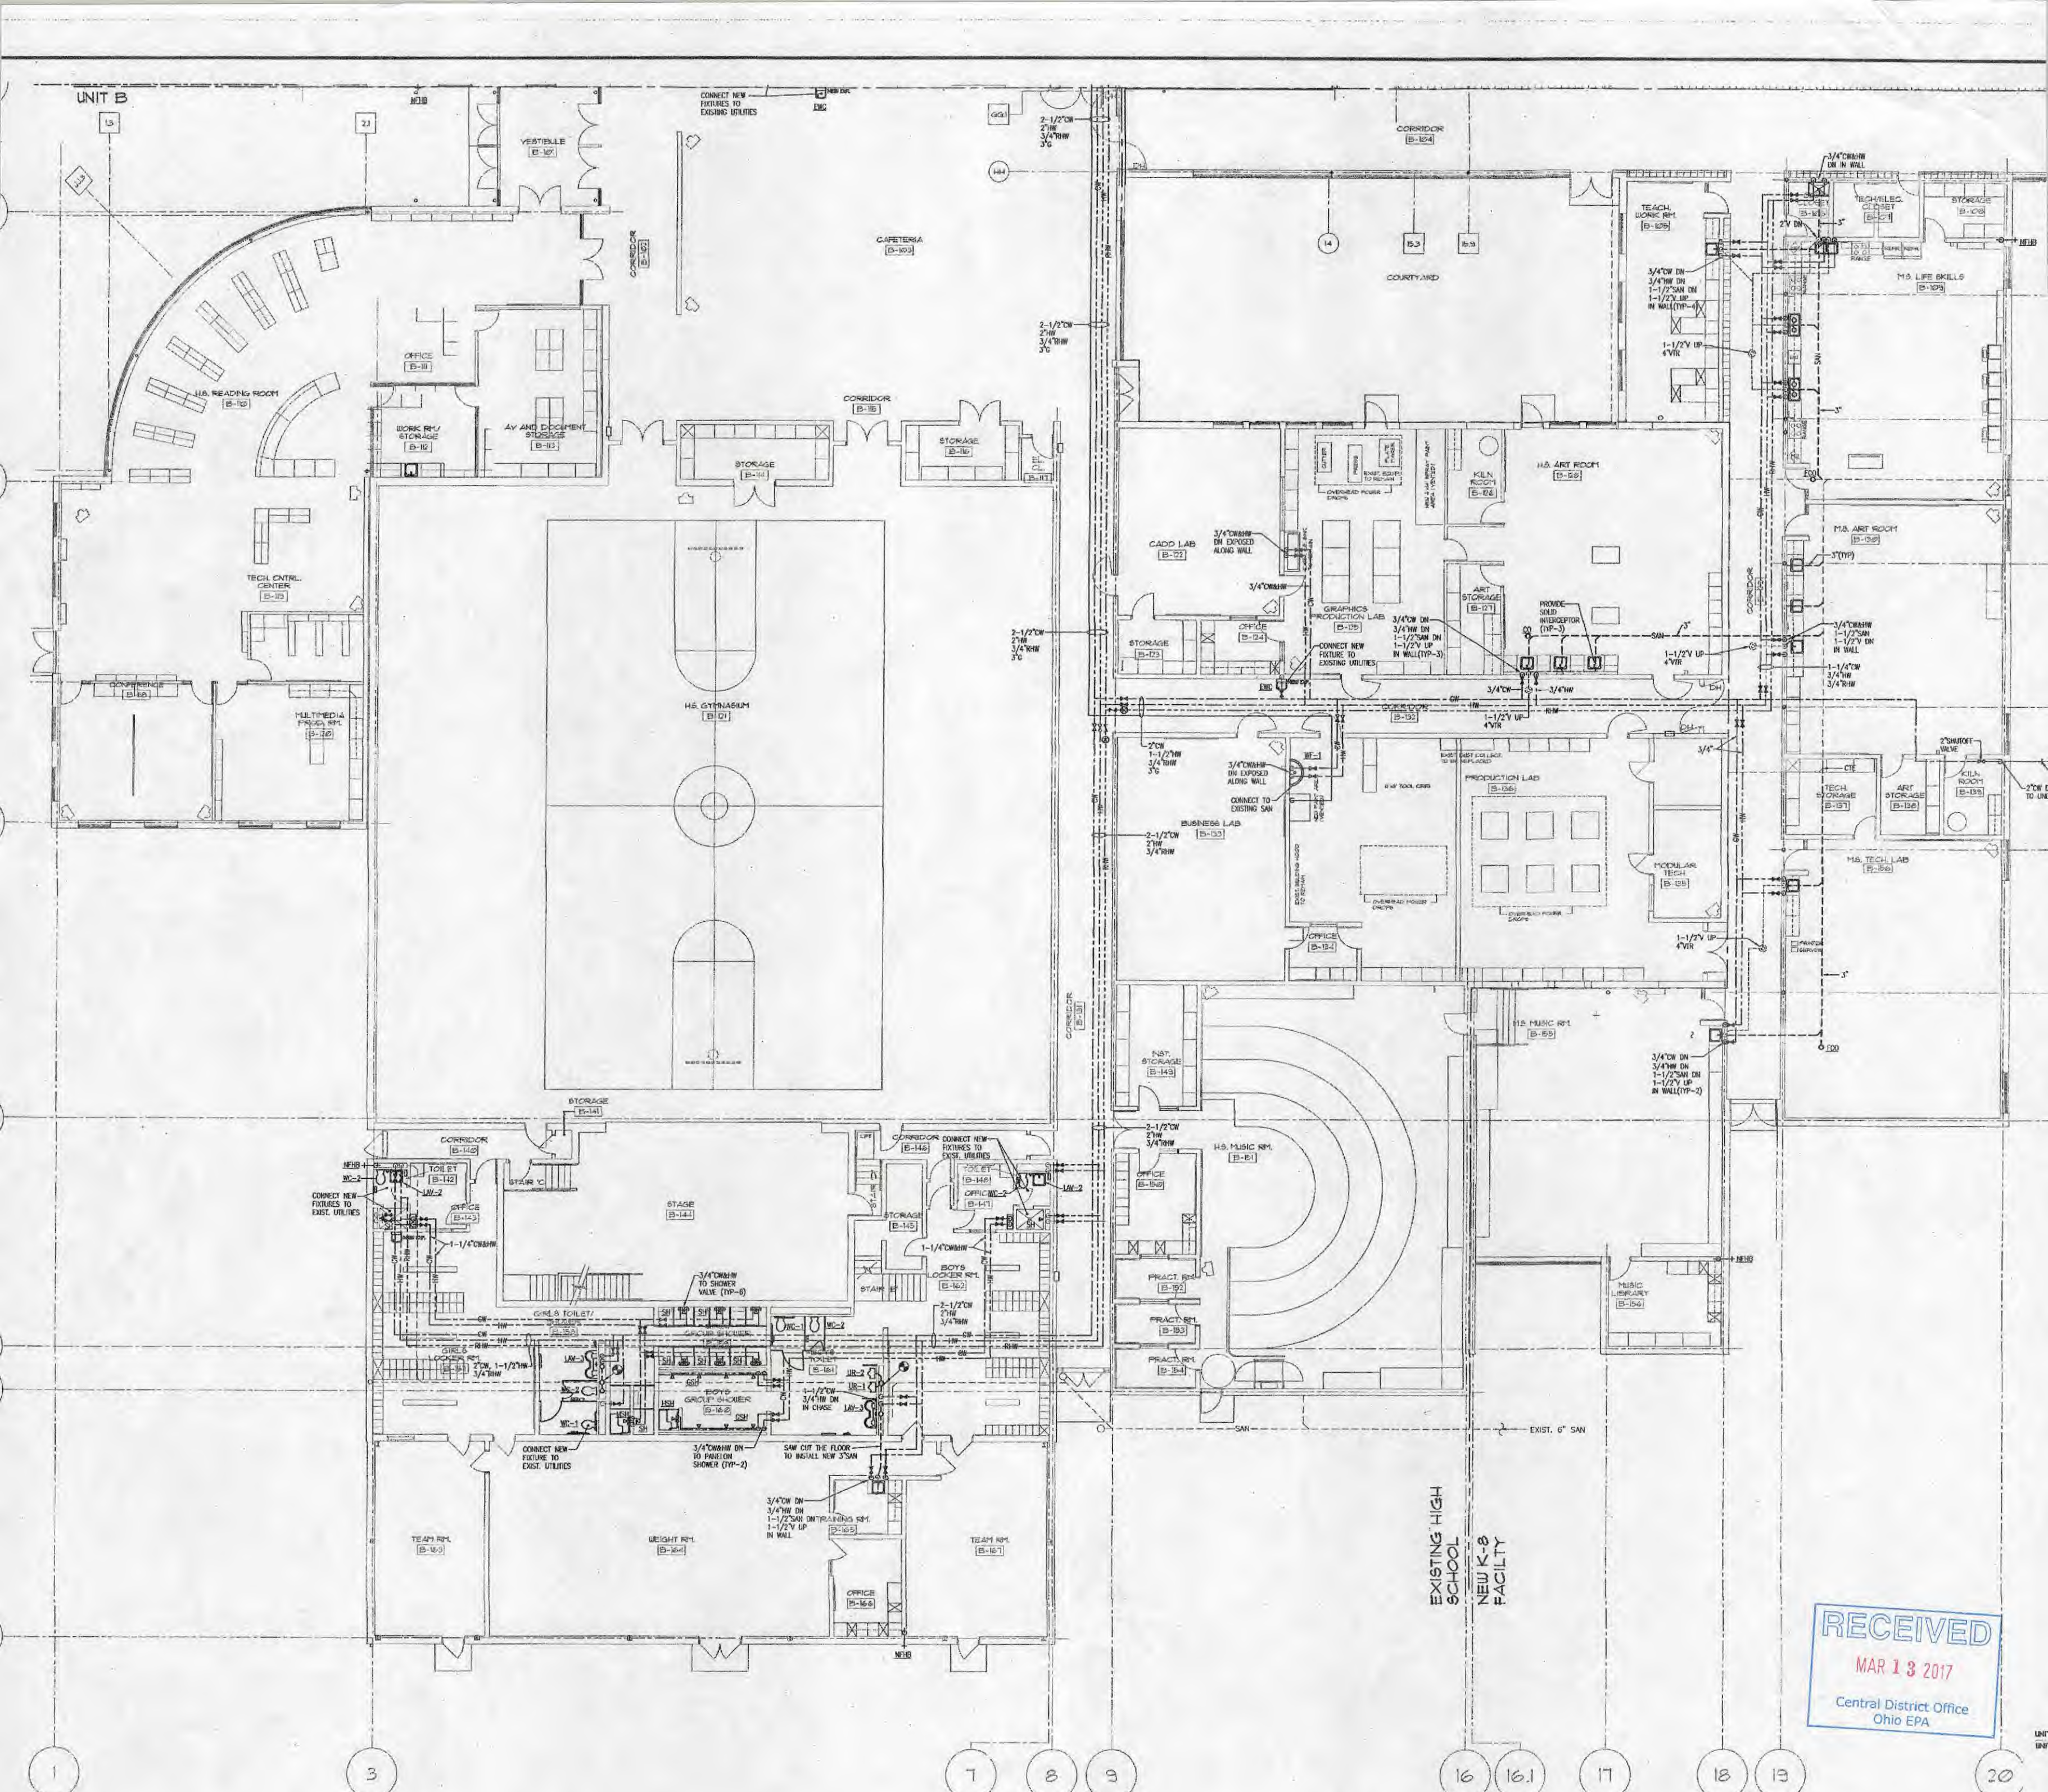

FIRST FLOOR PLUMBING PLAN UNIT "B"
SCALE: 1/8" = 1'-0"

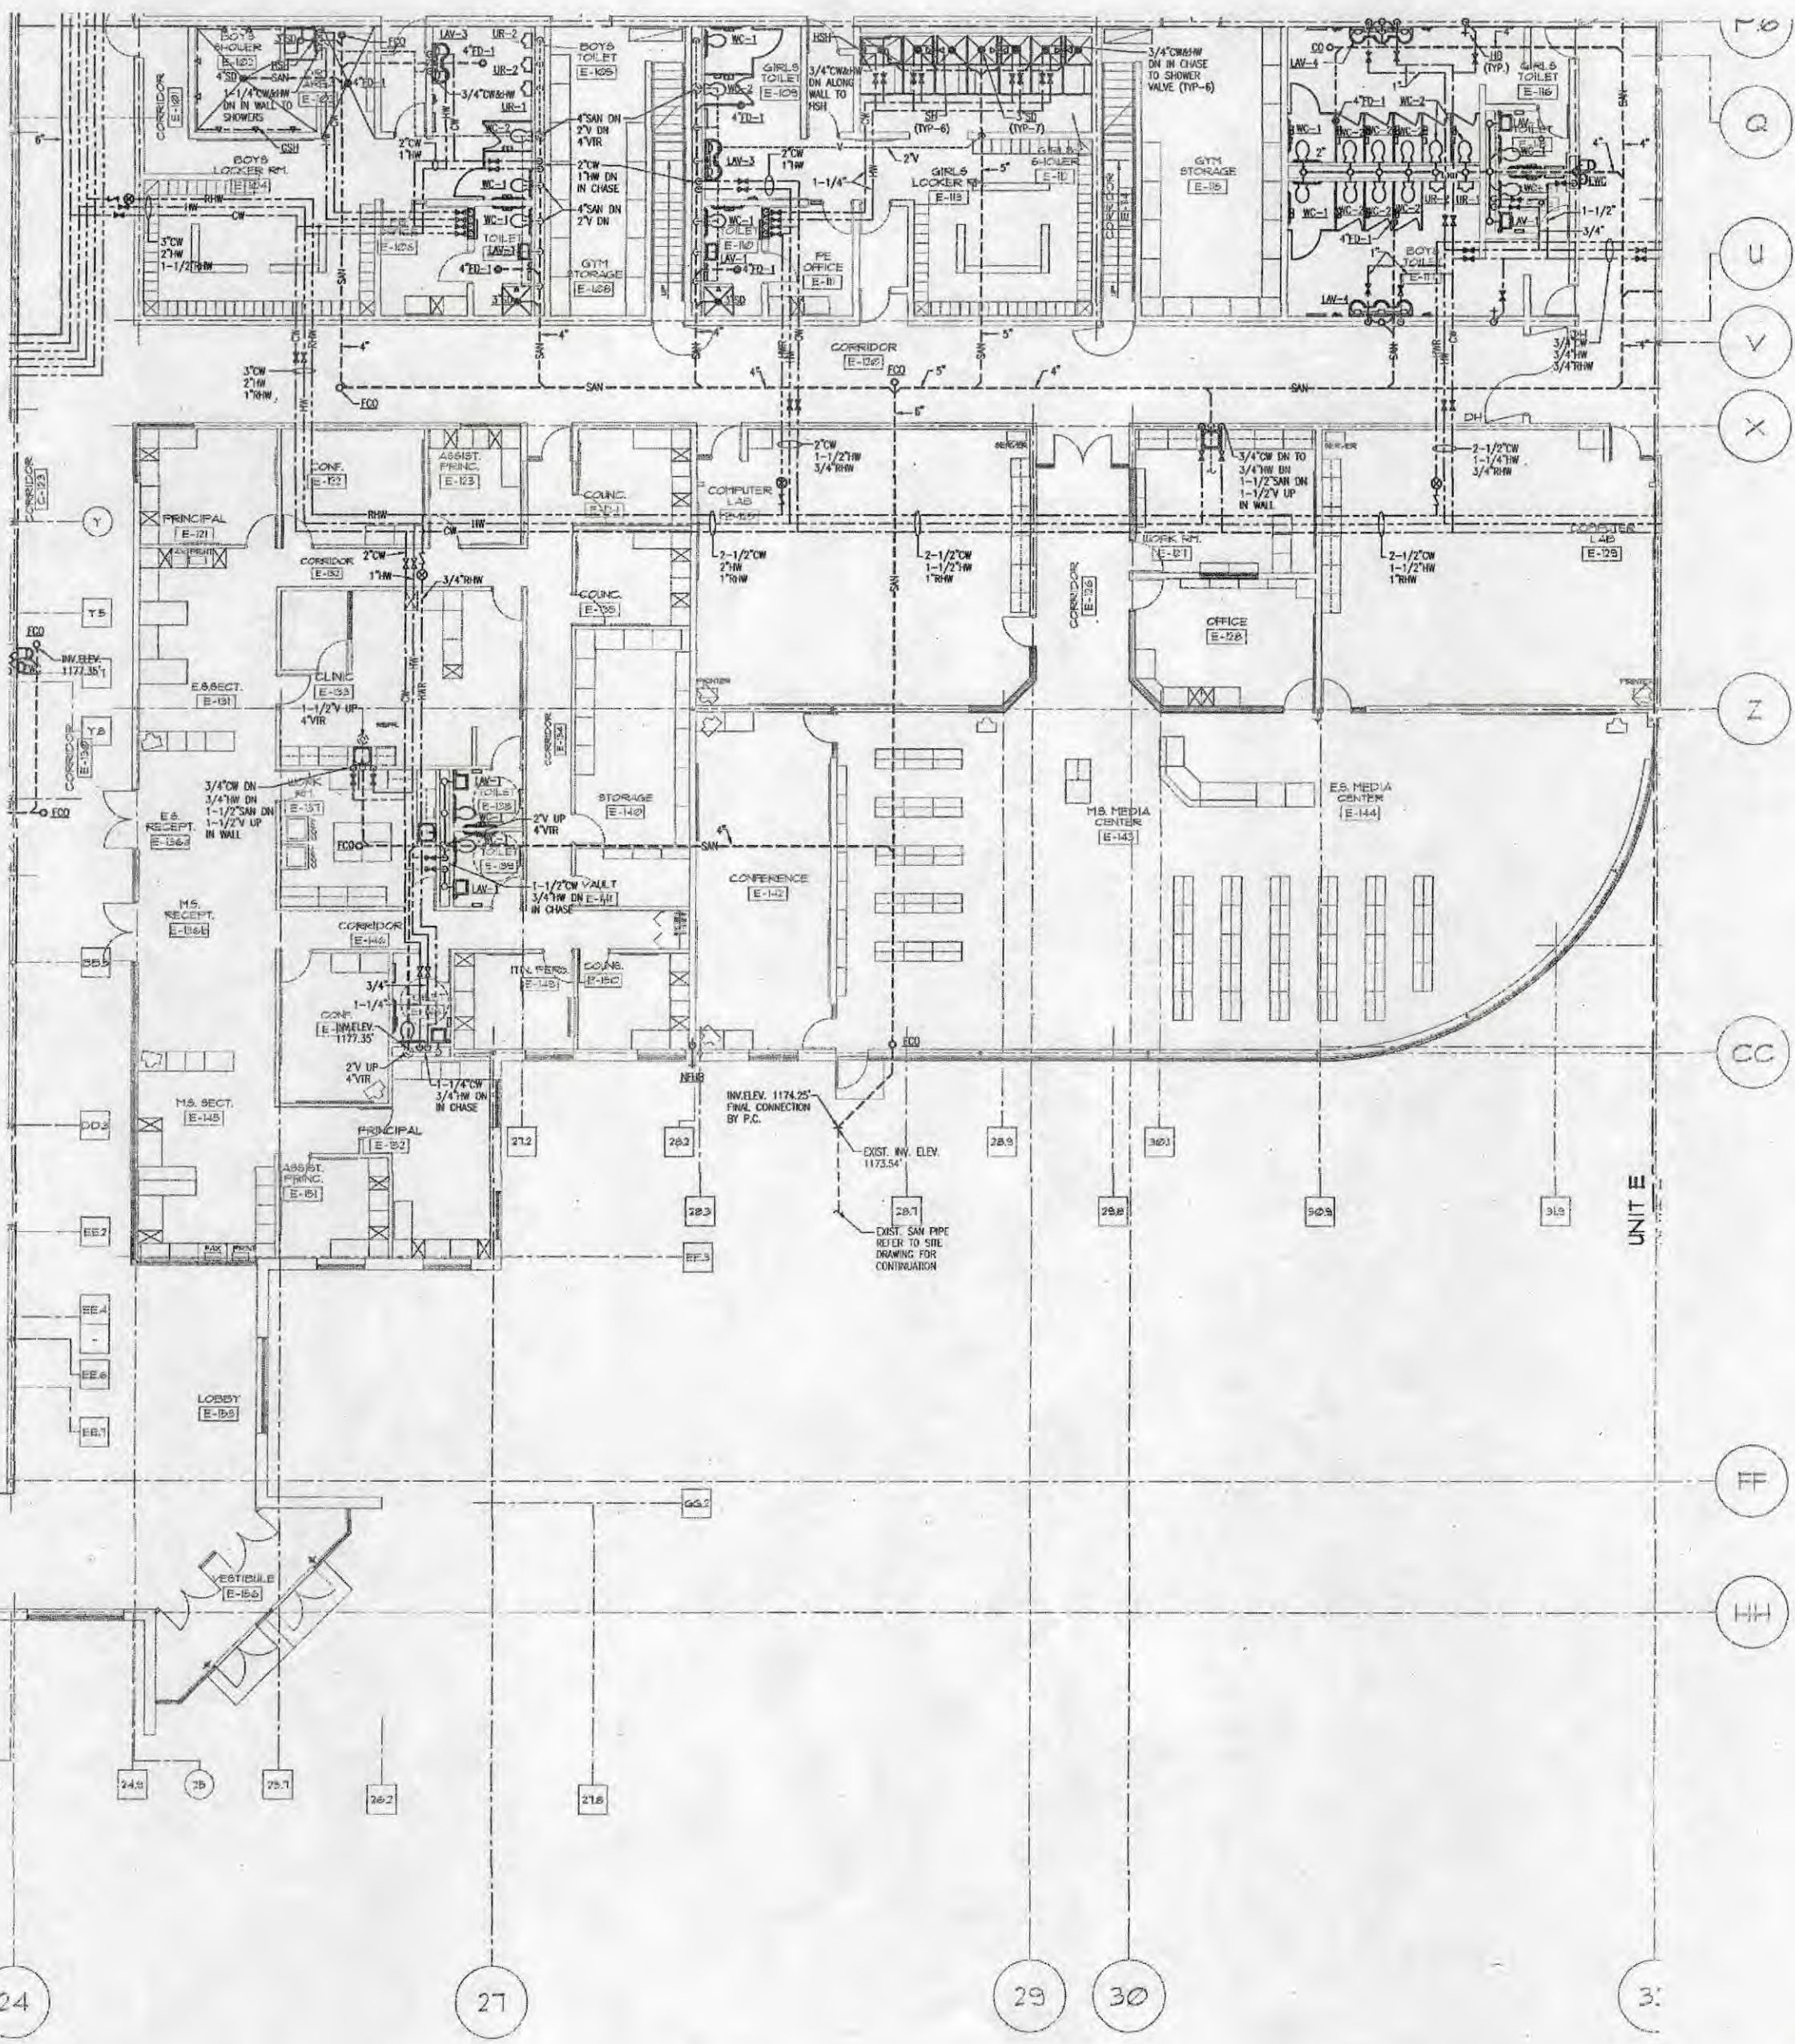

RECEIVED
 MAR 13 2017
 Central District Office
 Ohio EPA

FIRST FLOOR PLUMBING PLAN UNIT "E"
 SCALE: 1/8"=1'-0"

