



"Your Pro in H₂O"

OH Lic #38188

ALLIANCE WATER COND. & PLMG., INC.
COMPLETE PLUMBING • PUMP & WELL SERVICE

1097 WEST MAIN ST., ALLIANCE, OHIO 44601 • PHONE 330-823-2084 • 800-233-2084 • www.yourproinh2o.com

RECEIVED

FEB 21 2017

OHIO EPA NEDO

2/15/17
Island Creek Homeowners
PWS# 5001812

The entire water main at Island Creek is 6" transite pipe. The homeowners water service lines are either K copper or poly pipe. All homes were built prior to 1988 with the exception of 11460 Island Creek Dr. and 19155 Middletown Rd.


Respectfully,

Jared S. Duncan, Operator # CA-1107366-07
Alliance Water Conditioning

*One copy sent to EPA
5/2/17
JL*

LEAD (Copper pipe w/lead Solder)

Non Lead

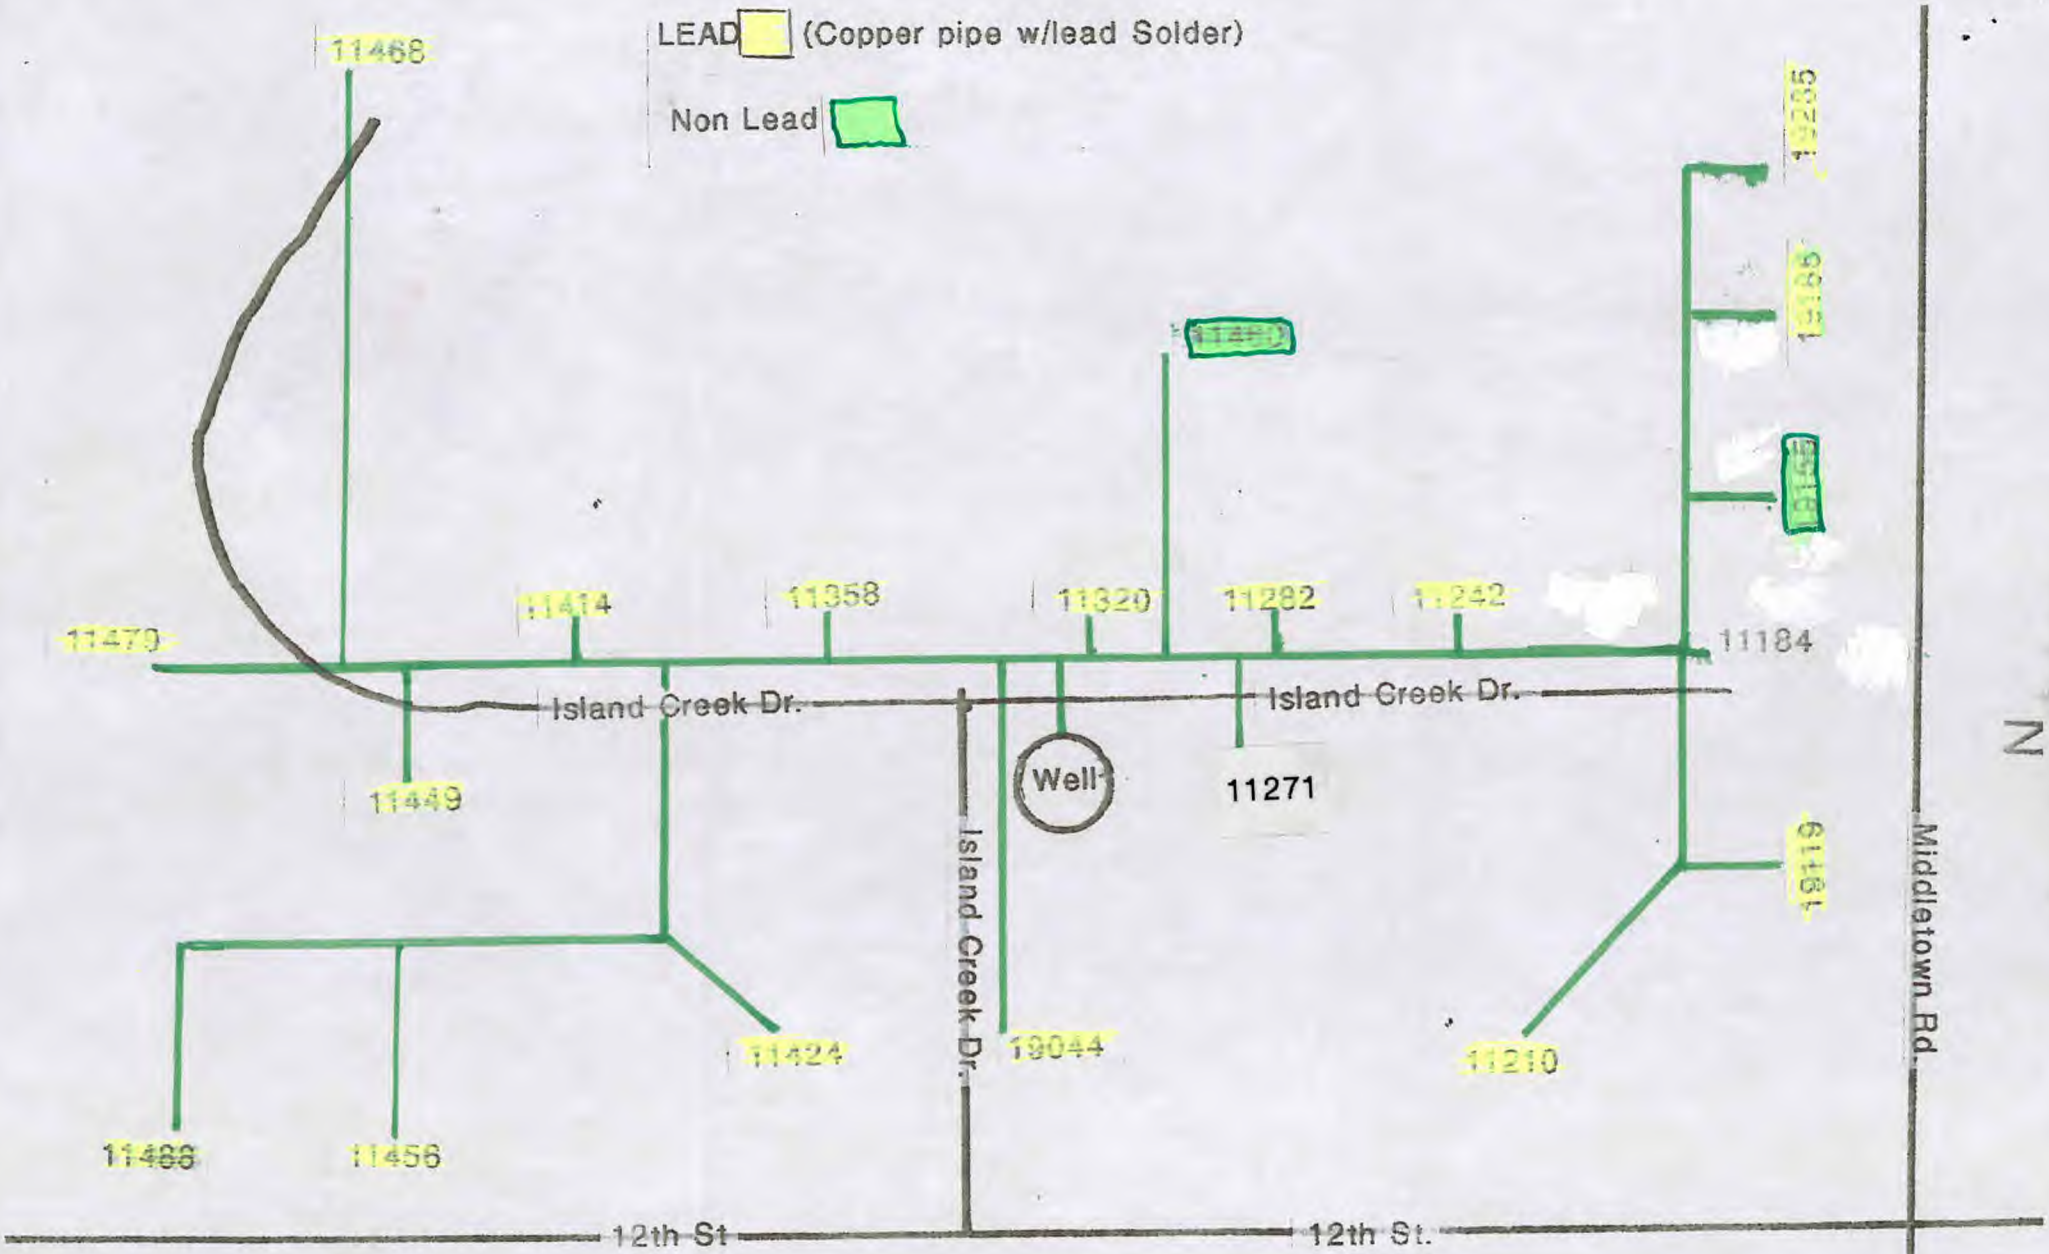

Island Creek Homeowners Beloit, Ohio 44609

PWS # 5001812