

Old Trail School

RECEIVED
MAR 10 2017

March 3, 2017

BY:

To: The Division of Drinking and Ground Water

The water lines feeding Old Trail School are of galvanized/copper with soldered connections.

The buildings that were constructed prior to 1986 are assume as probable or unknown due to the age of buildings.

Bob Morgan, Facilities Manager

Entity: Old Trail School
Doc Type: Report
Doc Subtype: _____
Program: _____
County: _____
Secondary ID: OH 7754712



RECEIVED
MAR 10 2017

BY:

October 28, 2002

Mr. James Paulett, Fire Chief
Bath Fire Department
3864 West Bath Road
Bath, Ohio 44333-1104

RE: **OLD TRAIL SCHOOL - WATER SUPPLY SYSTEM**
2315 Ira Road, Bath Ohio

Chief Paulett:

Per your request, the following are the answers to questions asked regarding the Old Trail School water system. Each is numbered to correspond to your fax, dated October 24, 2002.

1. *What is the gallonage of water maintained for fire protection?* The water storage tank has a low water limit alarm set for 10,000 gallons. The tank is a 20,000 gallon storage tank.
2. *What is the size of pipe from the well to the storage tank?* 2" diameter.
3. *What is the pipe size from the tank to the hydrants and the buildings?* The main line from the water storage tank to all hydrants is 6" diameter. Certain hydrants may have 4" or 6" diameter piping between the main and the hydrant (original drawings indicate 4" while visual inspection at those uncovered in the past year were found to be 6"). The water supply pipe feeding buildings is as follows:
Noble Hall: 3" diameter.
Firestone & Morgan Halls: 3" diameter (domestic) & 6" diameter (fire).
Sisler/McFawn Hall: 2½" diameter.
4. *What size mains are the hydrants on?* See answer in question no. 3 above.
5. *What is the capacity of the well pump?* 25 GPM.
6. *What is the capacity of the well in GPM's?* 220 GPM per last report.
7. *What is the average daily consumption of the system?* 4,750 gallons.
8. *What has been the peak consumption over the past three years?* 15,400 gallons. This is based on a monitoring period of slightly longer than the past year when constant monitoring was begun. Peak consumption may correspond with a recent water leak that was subsequently located and repaired.

If there are any questions, please contact our office. Thank you.

Sincerely,

HASENSTAB ARCHITECTS, INC.

Mark A. Diekmann
Mark A Diekmann, AIA
mad@hainc.cc

cc: J. Heaps - OTS
P. Klanac - PTB
File: 20041.01/MP/HAI Correspondence
O:\2000PROJECTS\20041.01\HAI Correspondence\BathFire.10.28.02.wpd

Chicago Faucets

RECEIVED
Page 1 of 1
MAR 10 2017

CHICAGO
FAUCETS

a Geberit company

BY:
GEBERIT

HOME > CONTACT US

What's New

Chicago Faucets
Commercial Products

- Company History
- General Plumbing Products Catalog
- Food Service Catalog
- Warranty Information
- Product Bulletins
- Promotions
- Literature Request
- Glossary Of Terms

Geberit Commercial Products

Geberit Residential Products

OEM Products

Order Management

Tech Support

Distribution Partners

Online Literature

Industry Links

Geberit Facts & Figures

PRODUCT SEARCH

by manufacturer or category

Select

GO

Home > Commercial Products > General Plumbing Products Catalog > Commercial Plumbing >
Kitchen Sink Faucets - Adjustable 4"-8 3/8" Centers > 445-L9CP

Kitchen Sink Faucets

Adjustable 4"-8 3/8" Centers

PRINT

Chicago Faucets is an industry leader committed to innovation met by the latest in engineering technology. Solid brass construction ensures unequalled product durability. These well mounted commercial fittings feature adjustable centers for increased installation flexibility. Lever handles meet ADA requirements.



445-L9CP

\$ 242.33

- Wall Mounted Fitting
- LS - Swing Spout
- RS - Self-Moist Aerator
- 360° Lever Handles
- Quietair™ Dispensing Cartridge
- H - Adjustable Supply Arms
- 1/2" NPT Female Inlets
- Pressure Compensating 2.2GPM (8.3 L/min.)

TECHNICAL DRAWINGS

SHOW PDF DRAWING

DOWNLOAD CAD DRAWING

TECHNICAL PARTS DRAWINGS

SHOW PDF DRAWING

DOWNLOAD CAD DRAWING

INSTALLATION INSTRUCTIONS

SHOW INSTRUCTIONS

The product complies with the following codes and standards:

- ASME A112.18.1M
- NSF 61, Section J

Copyright © 2007 The Chicago Faucet Company, Chicago. All Rights Reserved.
Terms and Conditions | Site Requirements

Veg Sink in Main Kitchen.
Faucet

Chicago Faucets

RECEIVED
Page 1 of 1
MAR 10 2017



BY
GEBERIT

What's New

Chicago Faucets
Commercial Products

- Company History
- General Plumbing Products Catalog

- Food Service Catalog

- Warranty Information

- Product Bulletin

- Promotions

- Literature Request

- Glossary Of Terms

Geberit Commercial Products

Geberit Residential Products

OSM Products

Order Management

Tech Support

Distribution Partners

Online Literature

Industry Links

Geberit Facts & Figures

PRODUCT SEARCH

By Model, Part, or Category

Select

GO

Home > Commercial Products > General Plumbing Products Catalog > Sinks >
Lavatory > Geberit OC - 8" Coverplate > 680-8CP

Lavatory


PRINT

Geberit OC - 8" Coverplate

Geberit, Chicago Faucets revolutionary new electronic faucet, combines Chicago Faucets quality and leading edge electronics to create the easiest-to-maintain and most reliable electronic faucet on the market today. Plus, an industry first - new Geberit Commander Software provides set-up and diagnostic capabilities from a Palm OS enabled handheld device.



The product complies with the following codes and standards:

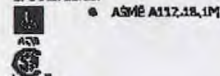

680-8CP

\$ 639.49

- Deck Mounted Fitting
- Cast Brass Spout
- E205 - 0.5 GPM (1.9 L/min) Vandal Resistant Spray Outlet
- Forged Brass Cover Plate
- Includes Optional 2.2 GPM (8.3 L/min) Aerosol Inset
- 4 "AA" Cell Alkaline Batteries Included
- 1/4" NPT Female 1/8"

TECHNICAL DRAWINGS

SHOW FOR DRAWINGS

DOWNLOAD CAD DRAWINGS

TECHNICAL PARTS DRAWINGS

SHOW FOR DRAWINGS

DOWNLOAD CAD DRAWINGS

INSTALLATION INSTRUCTIONS

SHOW INSTRUCTIONS

Copyright © 2007 The Chicago Faucet Company, Chicago, All Rights Reserved.
Terms and Conditions | Site Requirements

Class Room & Hallway Lavatory Faucets 8" d

Chicago Faucets

CHICAGO FAUCETS

A Geberit company

What's New

Chicago Faucets Commercial Products

- Company History
- General Plumbing Products Catalog
- Food Service Catalog
- Warranty Information
- Product Bulletins
- Promotions
- Literature Request
- Glossary Of Terms
- Geberit Commercial Products
- Geberit Residential Products
- OSM Products
- Order Management
- Tech Support
- Distribution Partners
- Online Literature
- Industry Links
- Geberit Facts & Figures

PRODUCT SEARCH

BY MODEL NO. OR CATEGORY

Select

GO


HOME > Commercial Products > General Plumbing Products Catalog > Carles > Lavatory > Galileo DC - 4" Complate > 680-4CP

Lavatory

F2121

Galileo DC - 4" Complate

Galileo, Chicago Faucets revolutionary new electronic faucet, combines Chicago Faucets quality and leading edge electronics to create the easiest-to-maintain and most reliable electronic faucet on the market today. Plus, an industry first - now Geberit Commander SpSystm provides set-up and diagnostic capabilities from a Palm OS enabled handheld device.

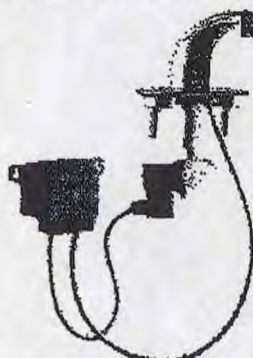

680-4CP

\$ 639.97

- Deck Mounted Fitting
- Cast Brass Spout
- C2006 - 0.6 GPM (1.9 L/min) Vandal Resistant Spray Outlet
- Forged Brass Copper Plug
- Includes Optional 2.2 GPM (8.3 L/min) Aerator Insert
- 4 "AA" Cell Alkaline Batteries Included
- Field Adjustable Distance and Time Delay Settings
- 1/4" NPT Female Inlet
- Field Configurable to Metering, Water Sever, Night and Time Delay Modes

This product complies with the following codes and standards:



• ASME A112.18.1M

TECHNICAL DRAWINGS:

SHOW PDF DRAWING

DOWNLOAD CAD DRAWING

TECHNICAL PARTS DRAWINGS:

SHOW PDF DRAWING

DOWNLOAD CAD DRAWING

INSTALLATION INSTRUCTIONS:

SHOW INSTRUCTIONS

Copyright © 2007 The Chicago Faucet Company, Chicago. All Rights Reserved.
Terms and Conditions | Site Requirements

Class Room to have way Lavatory Faucets 4" &


Chicago Faucets - Commercial Plumbing - 1201-AHA8CP

Page 1 of 1
RECEIVED
MAR 10 2017

Kitchen Sink Faucets

Chicago Faucets is an industry leader committed to innovation that's supported by the latest in engineering technology. Solid brass construction ensures unequalled product durability.

BY:

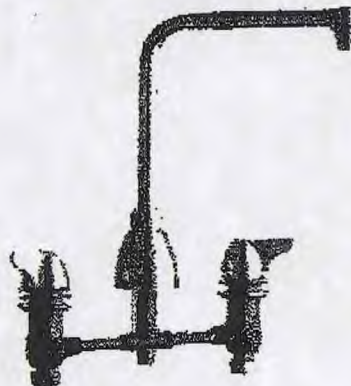

1201-AHA8CP

\$ 272.89

- Deck Mounted Fitting
- HA8 - High Rise Swing Spout
- EL2 - Softflow Aerator
- 1000 - Single Wing Handles
- Quantum™ Operating Cartridge
- 1/2" NPSM Coupling Nuts for 3/8" or 1/2" Flexible Risers
- Pressure Compensating 2.2GPM (8.3 L/min.)


This product complies with the following codes and standards:



- ASME A112.18.1M
- NSF 61, Section 9

Copyright © 2006 The Chicago Faucet Company, Chicago. All Rights Reserved.

CLASSROOM SINK FAUCETS.
W/ WRIST BLADE HANDLES.

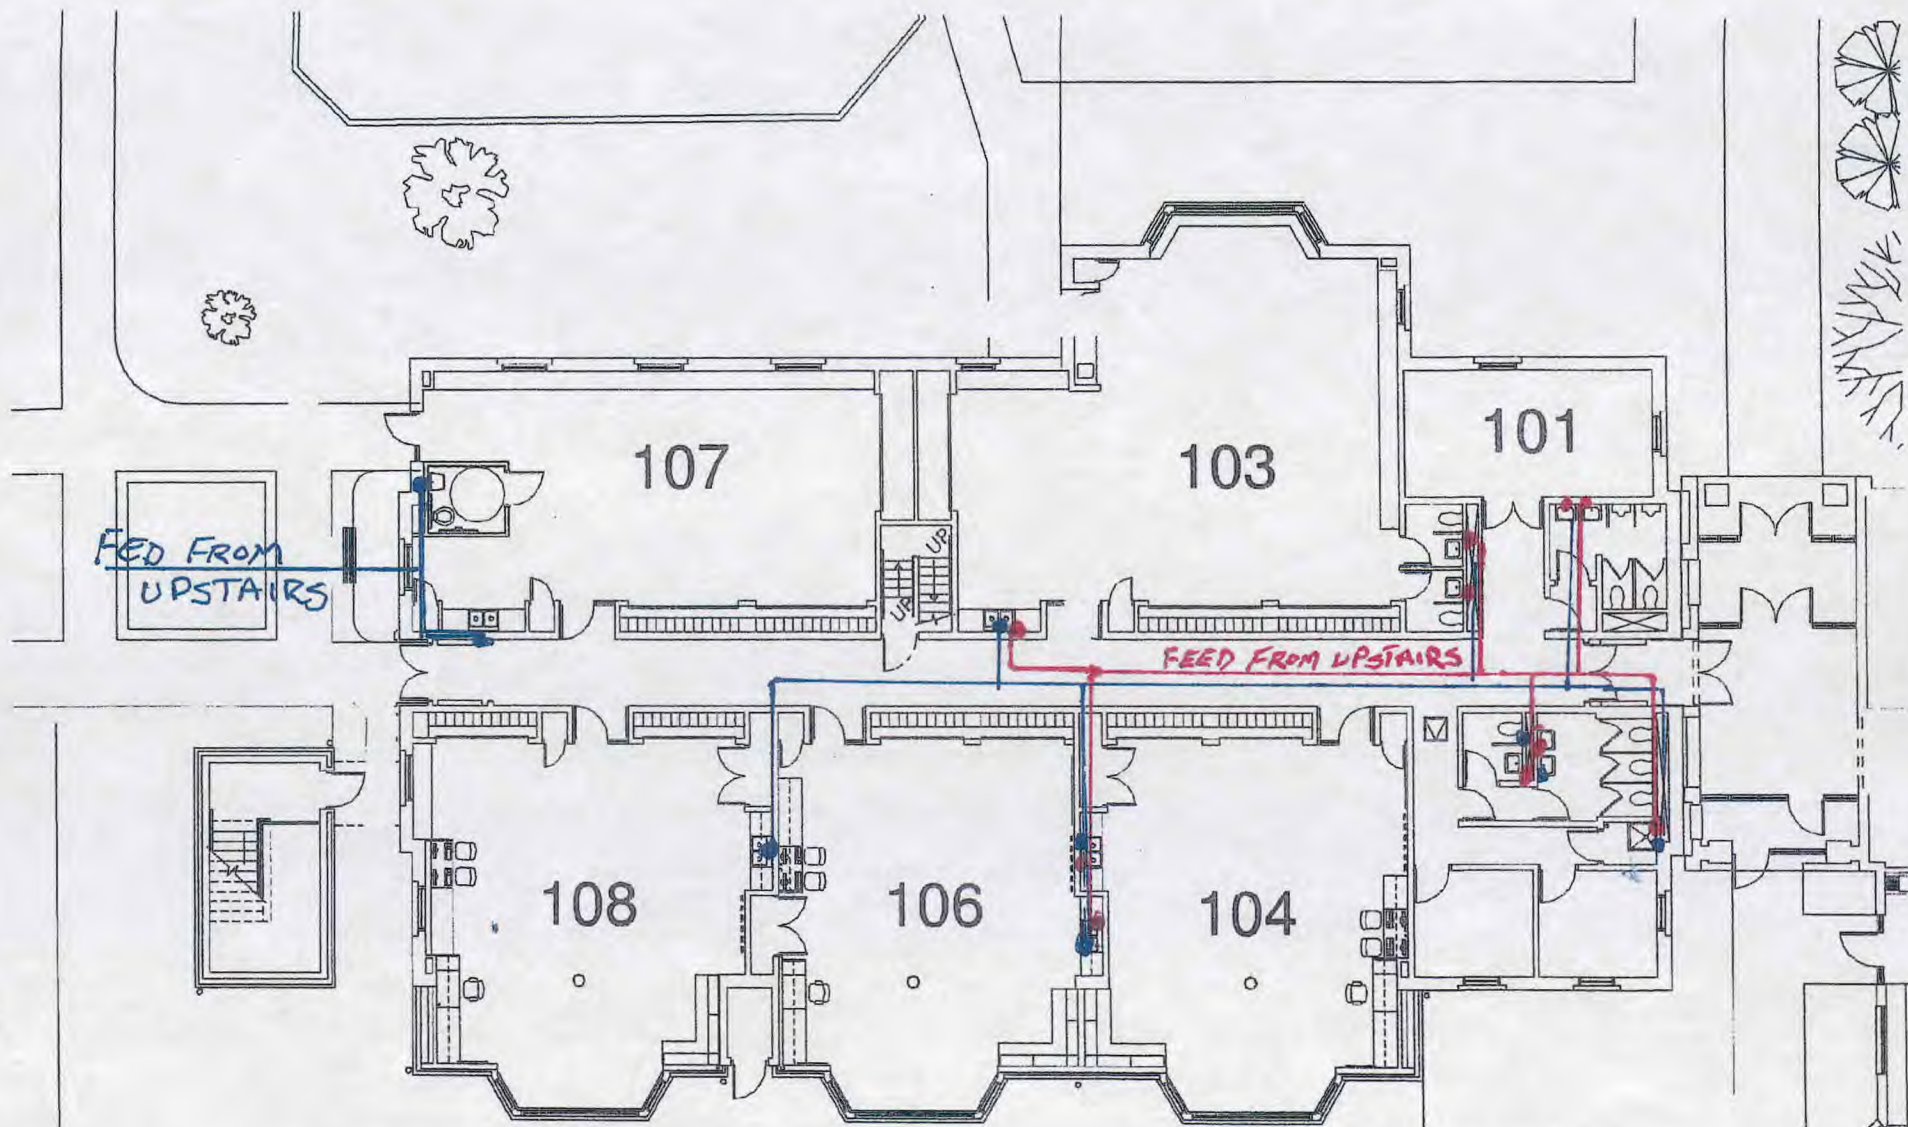

LOWER Sissler

SCALE: 1/16" = 1'-0"

08/24/12




BY: **DECEIVE**
MAR 1 0 2017

UPPER SISSLER

FEED TO BLDG

MAIN FEED TO
AIDER FER


HW TANK

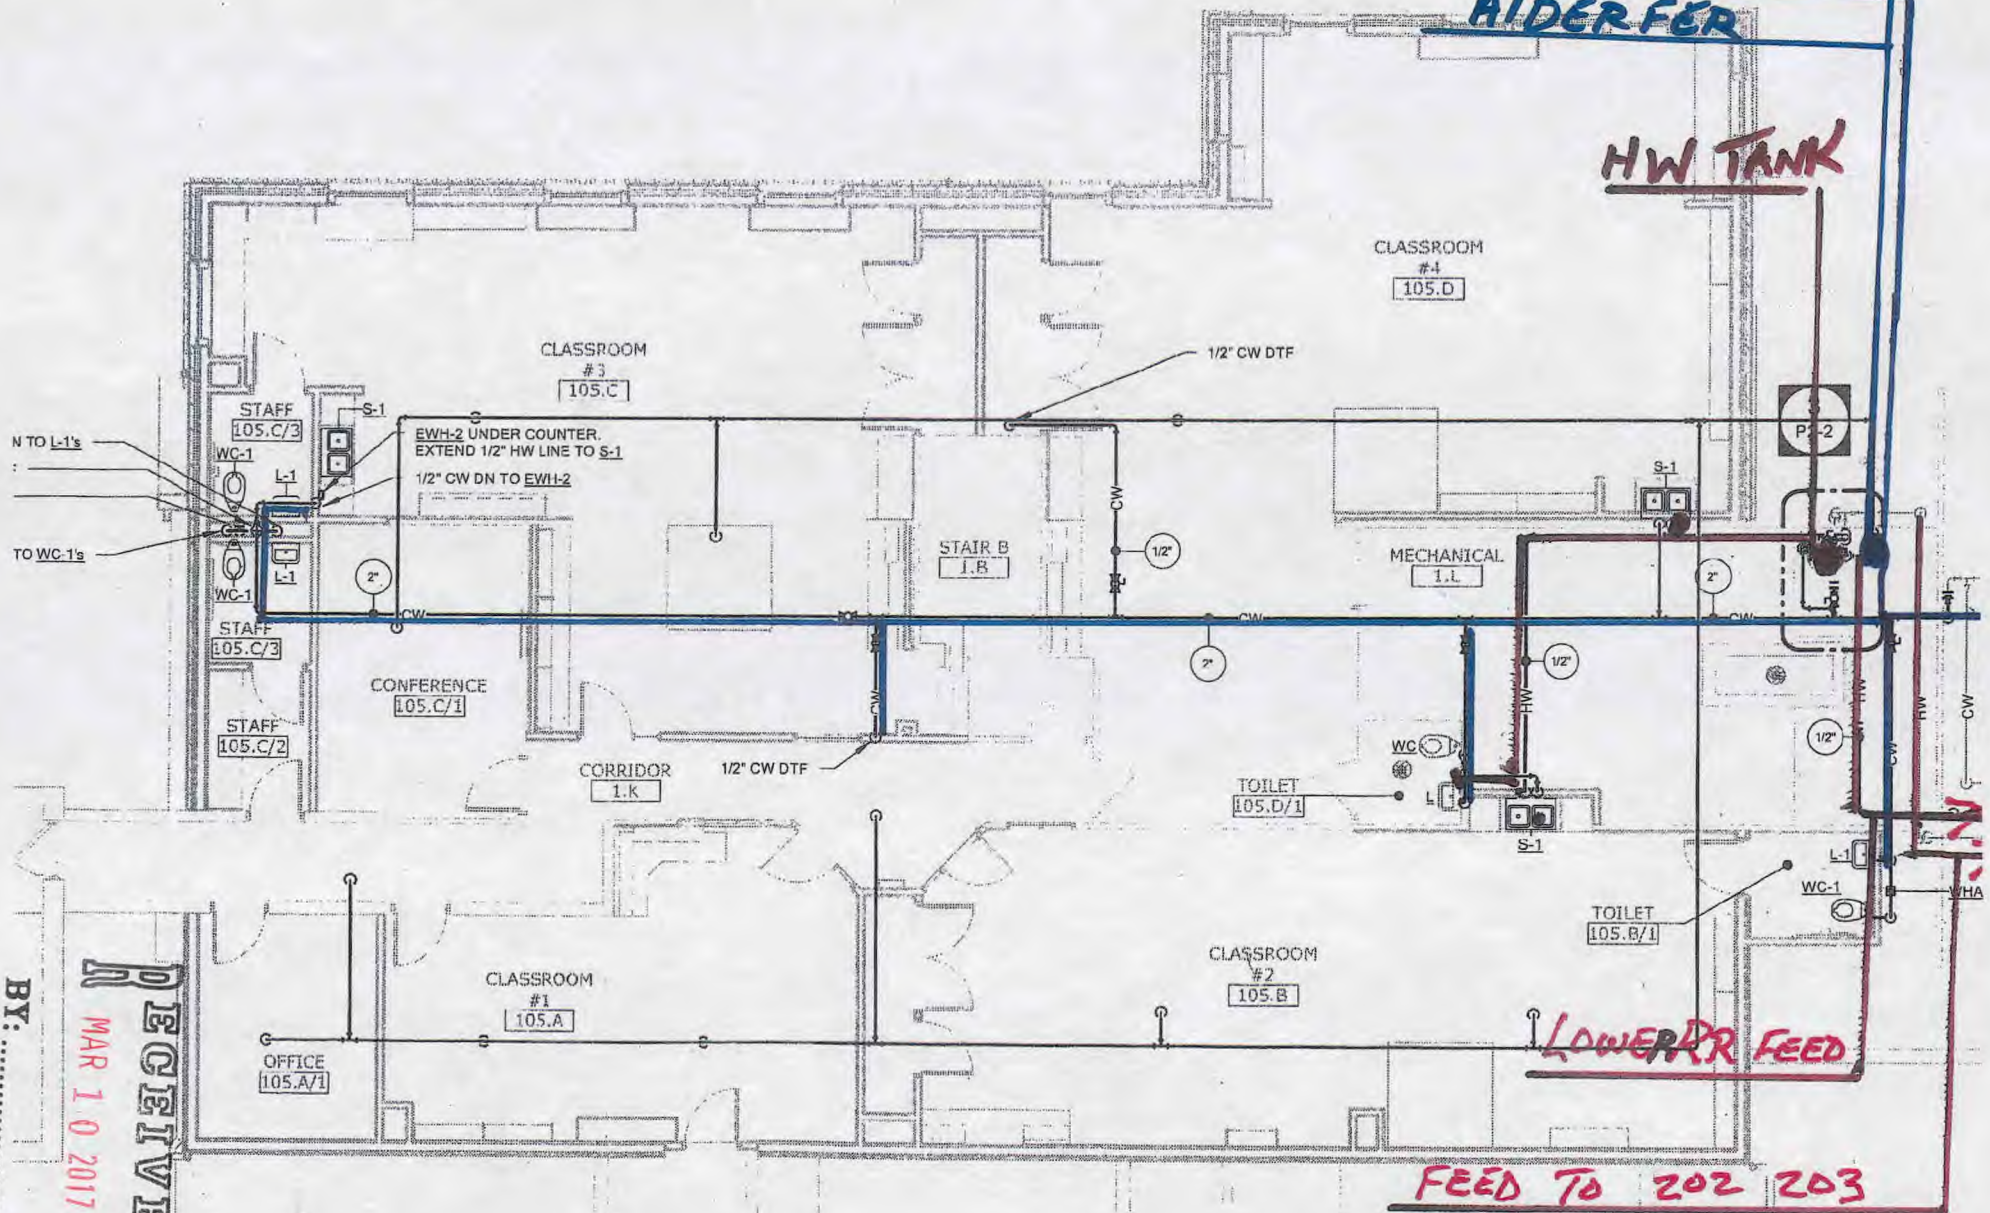

FEED TO 202 203

RECEIVED
MAR 10 2017

BY:

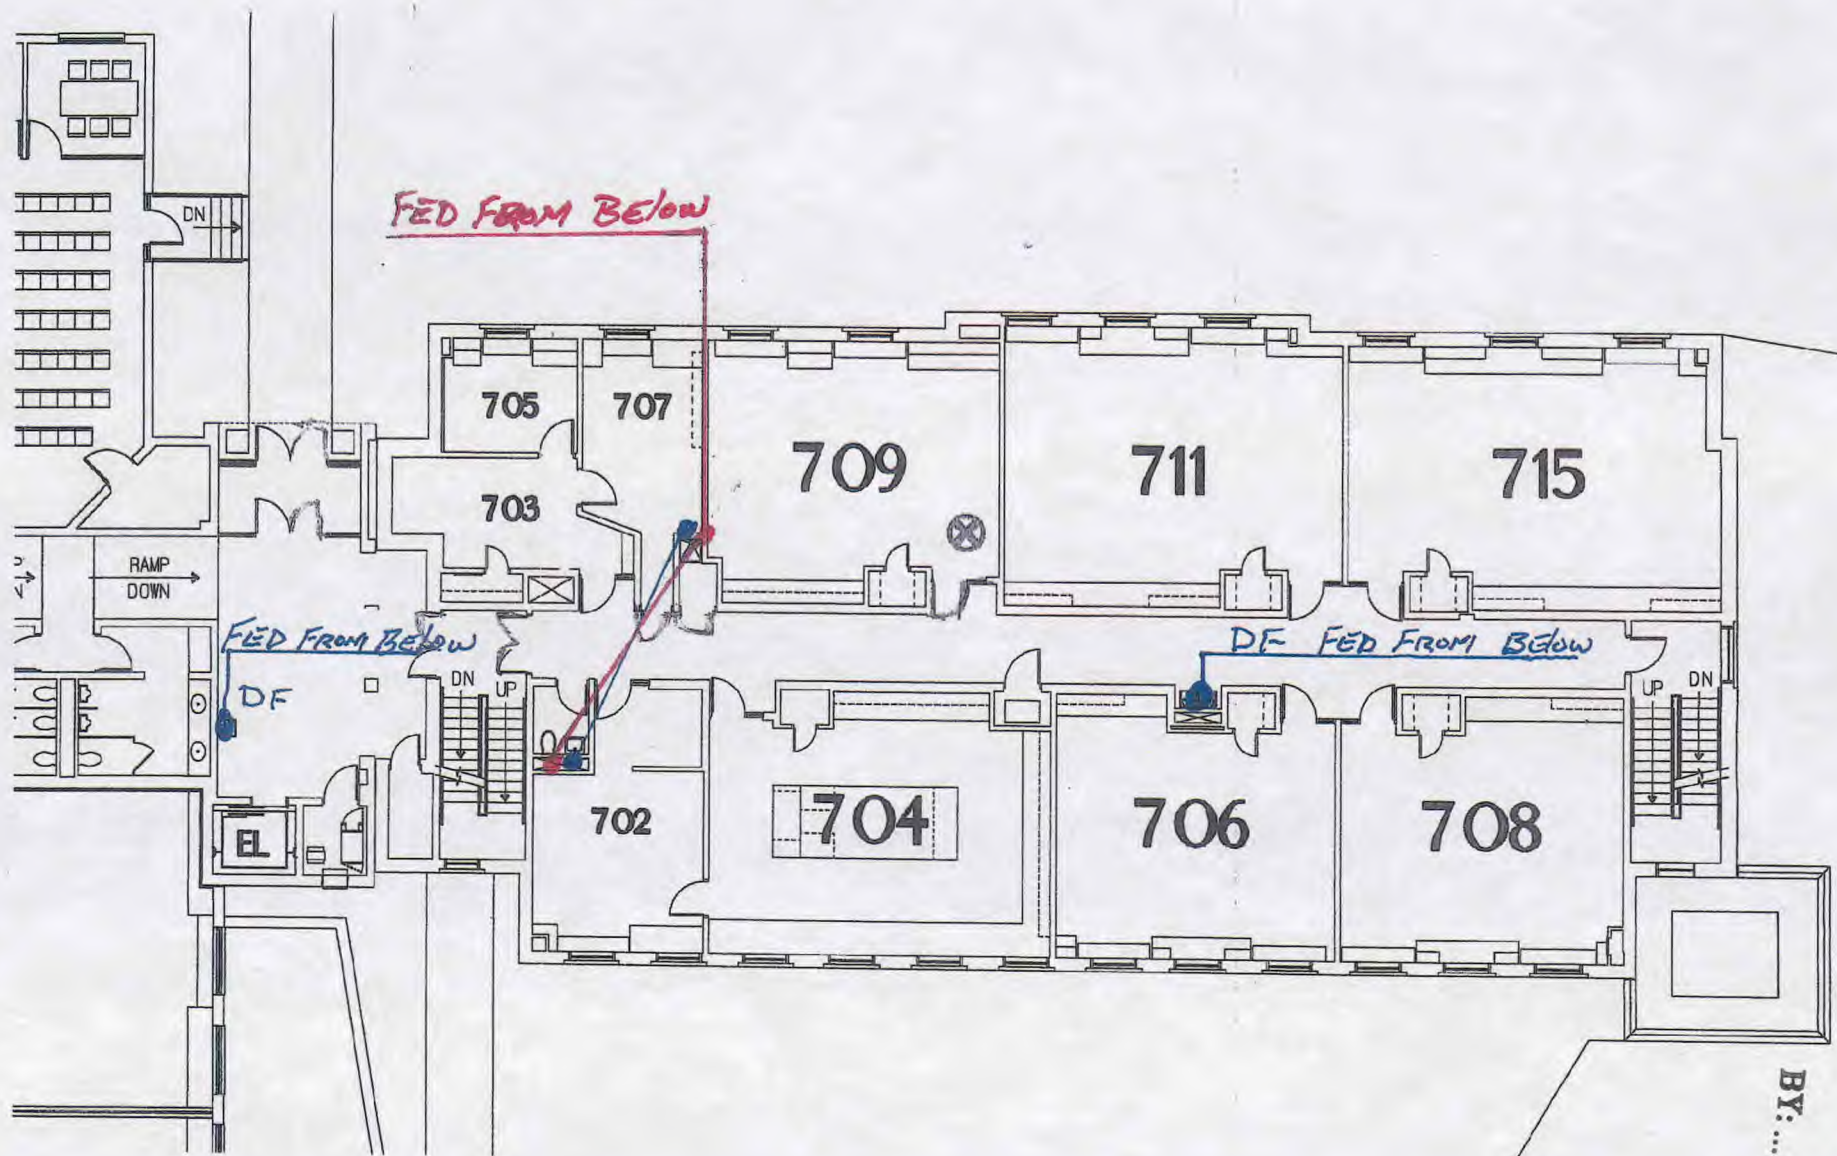

NOBLE HALL - MAIN LEVEL

SCALE: 1/16"=1'-0"


9/2/04



FIRE EVACUATION ROUTE
EMERGENCY WEATHER SHELTER
YOU ARE HERE



RECEIVED
MAR 1.0 2017
BY:

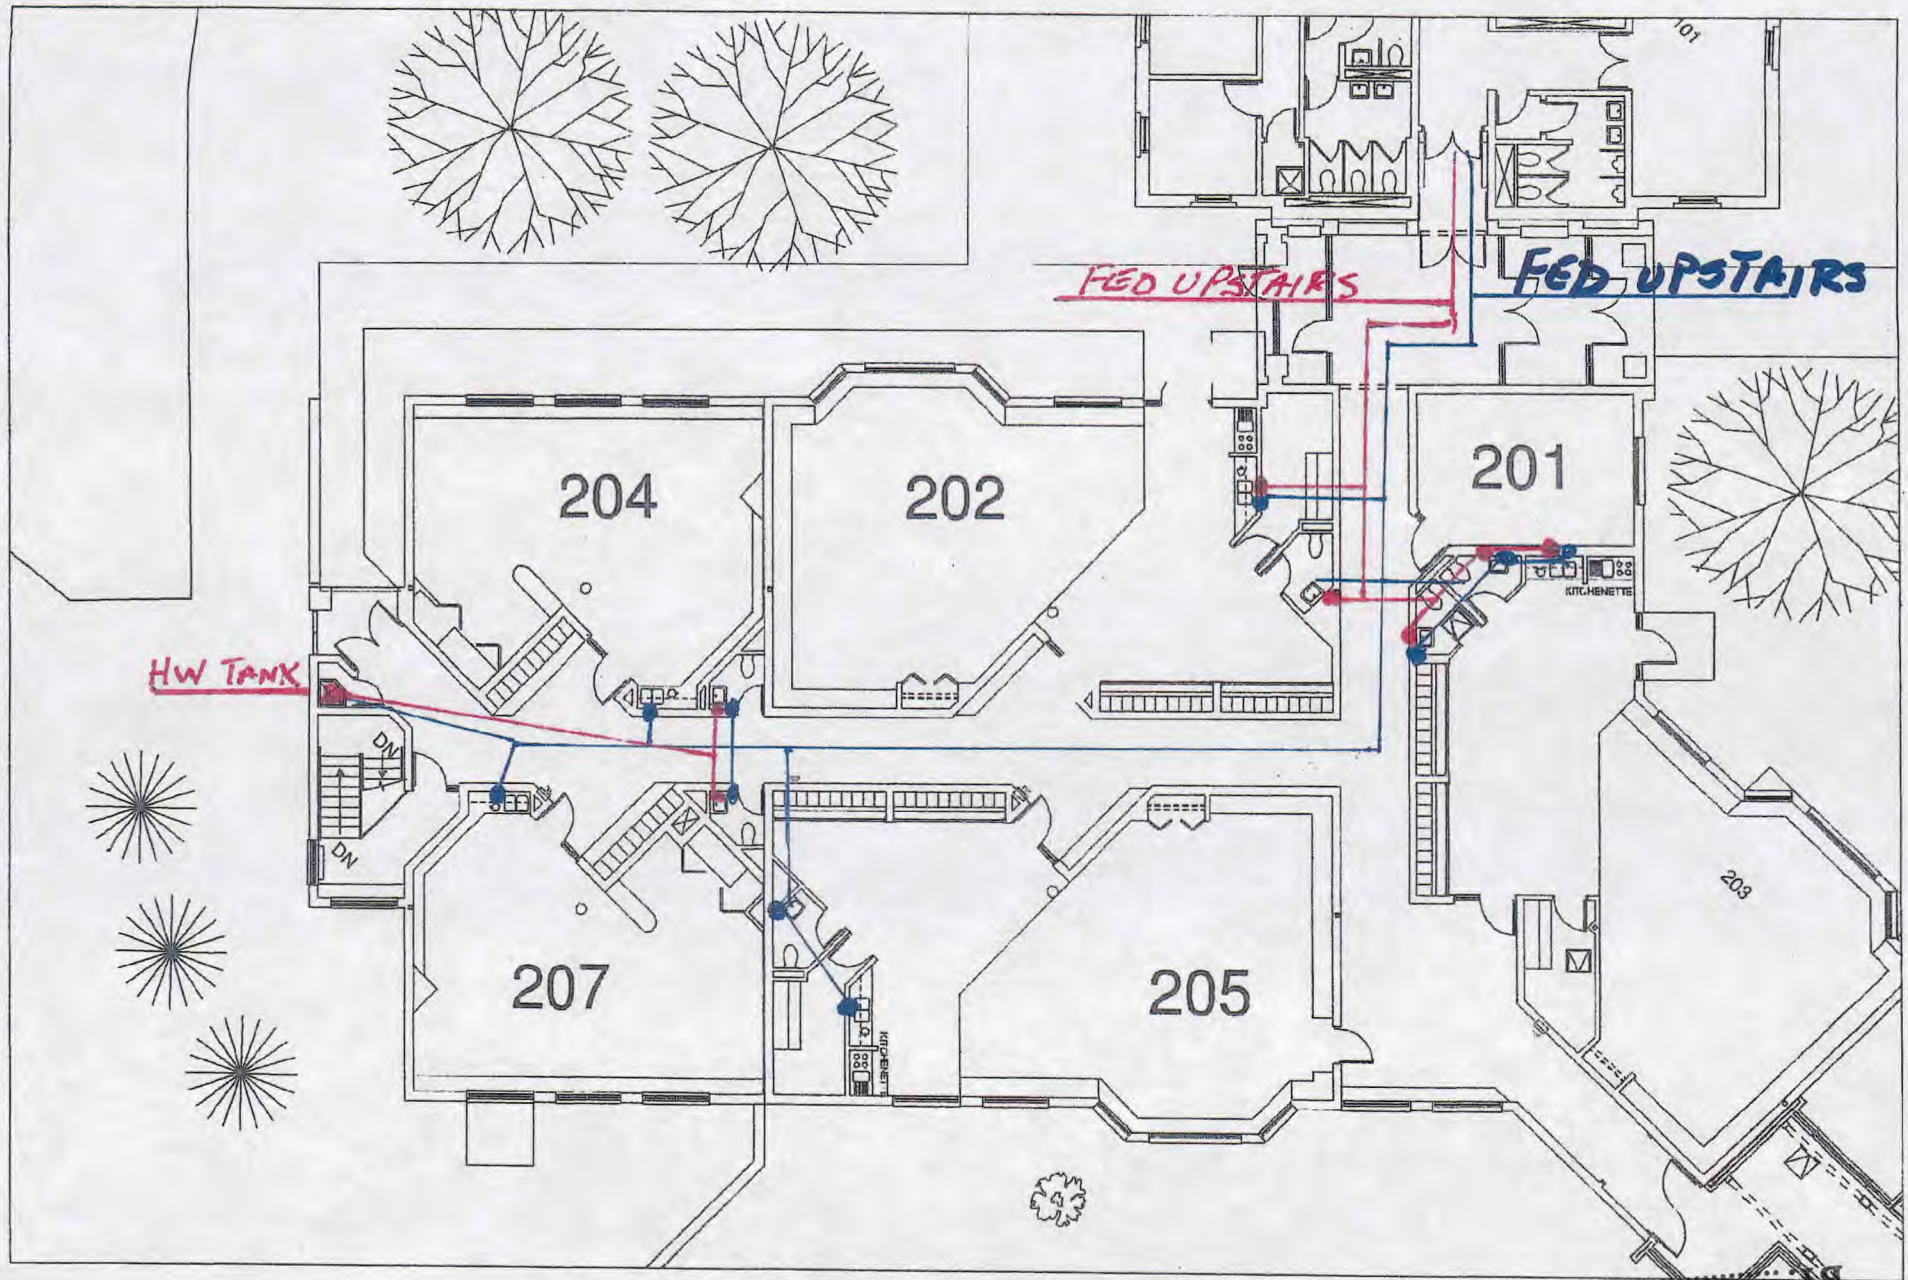


SCALE: 1/16" = 1'-0"

08/24/12



AIDERFER

RECEIVED
MAR 10 2017

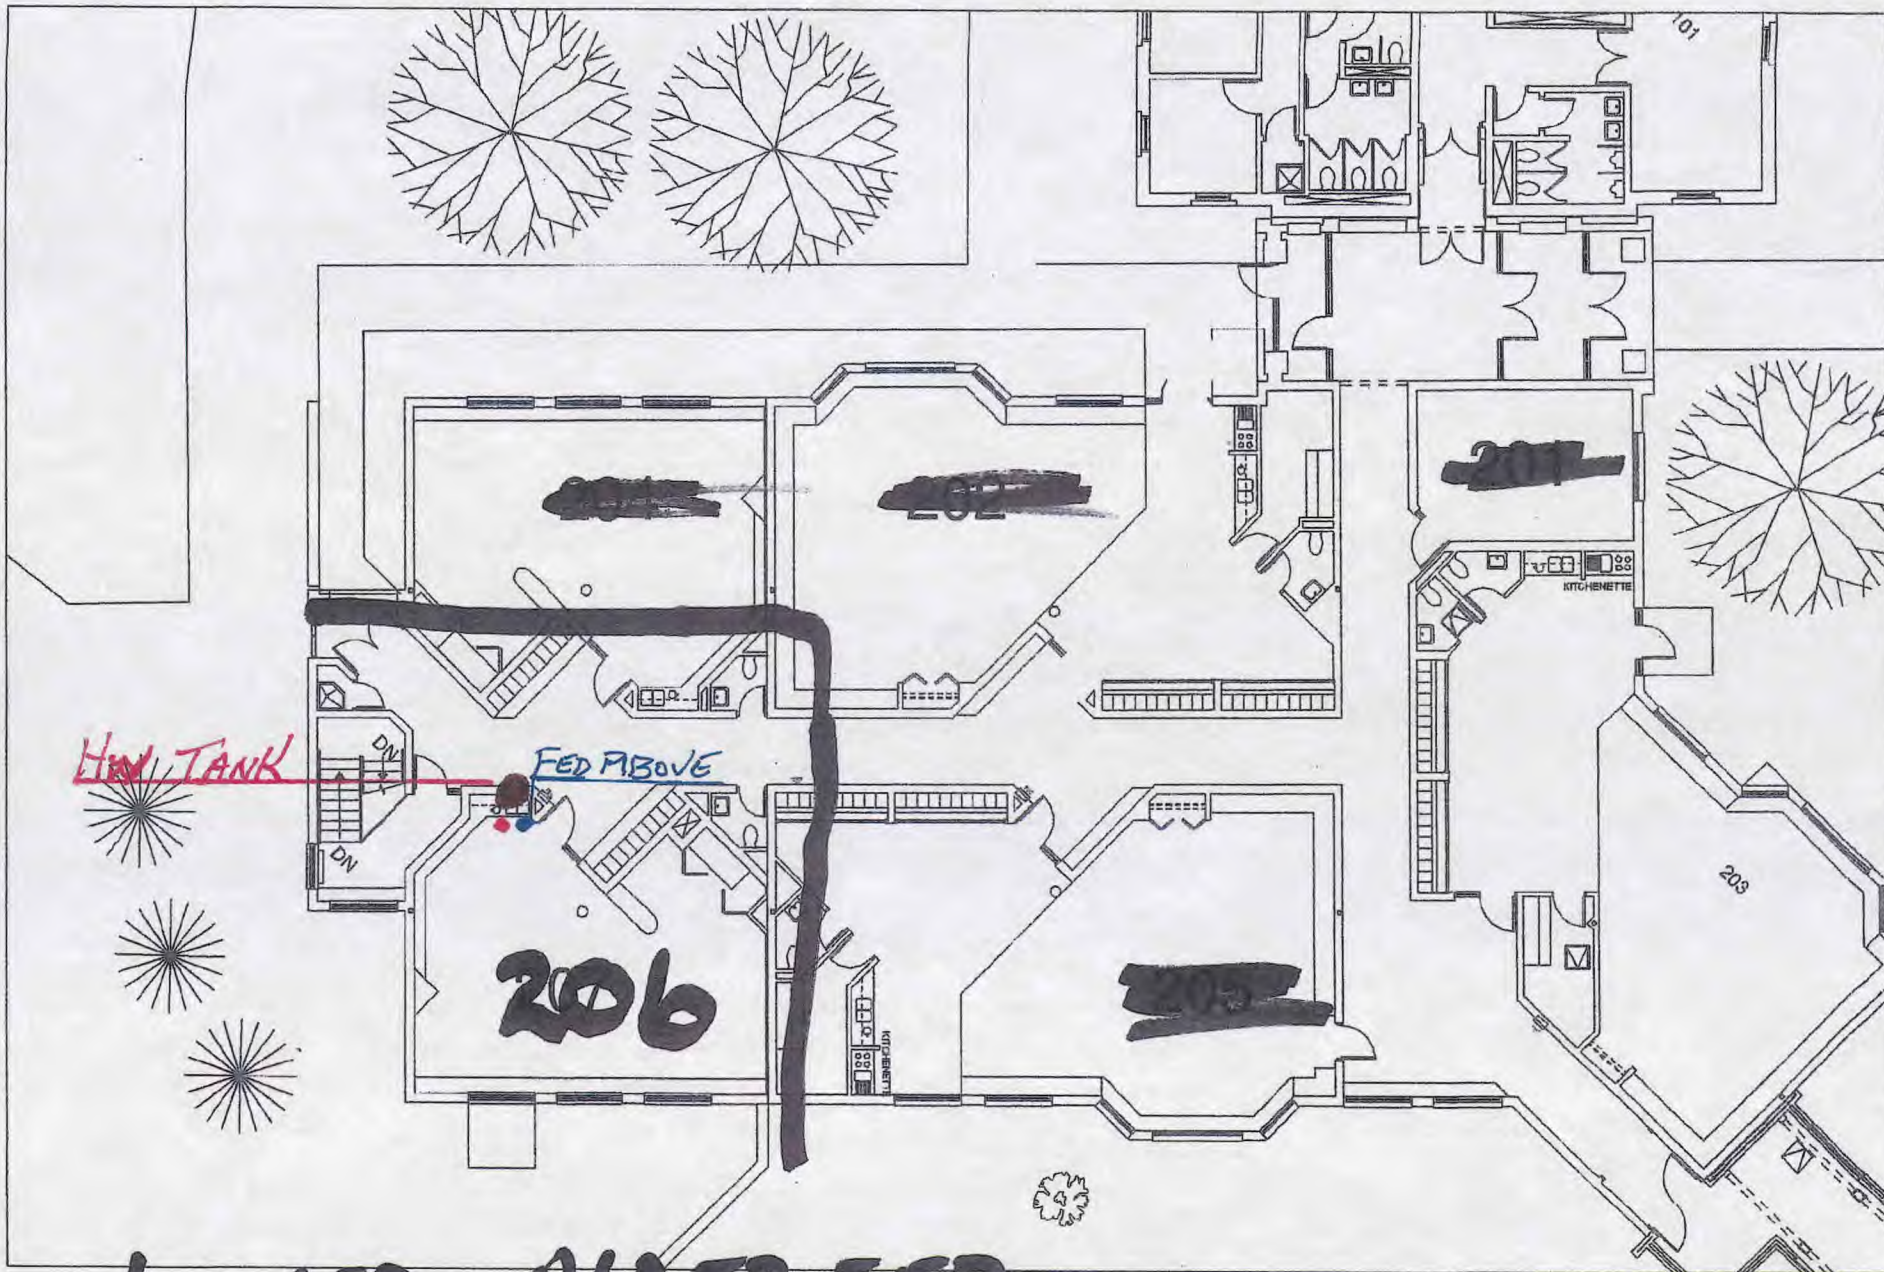

LOWER ALDER FER

SCALE: 1/16" = 1'-0"

08/24/12


NORTH


RECEIVED
MAR 10 2017

BY:

RECEIVED
MAR 10 2017

BY:

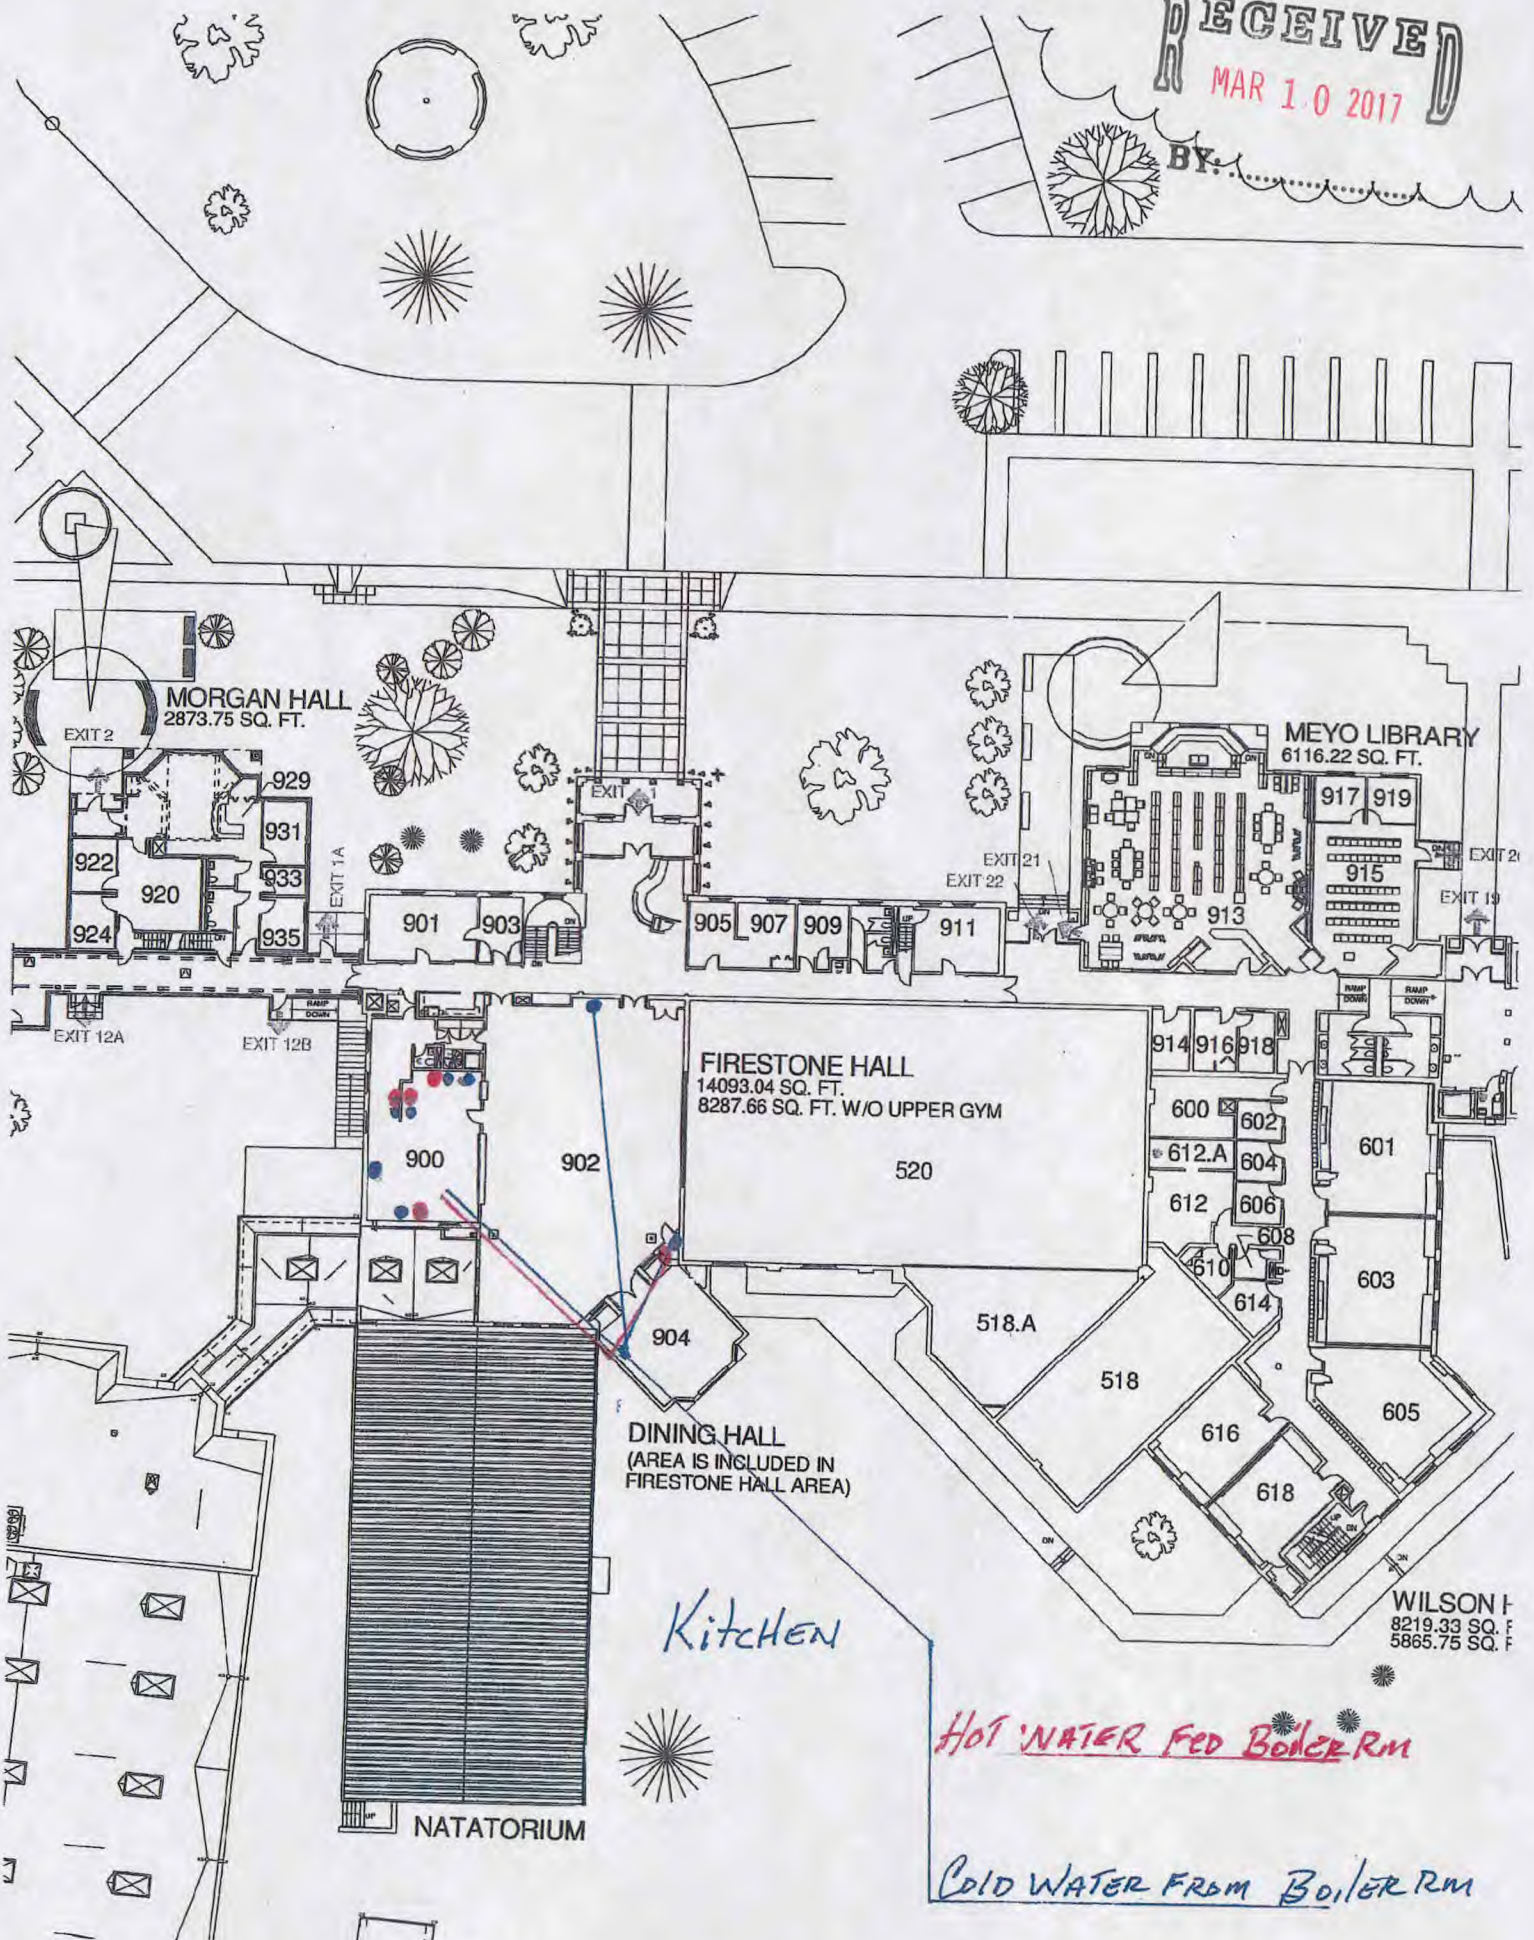

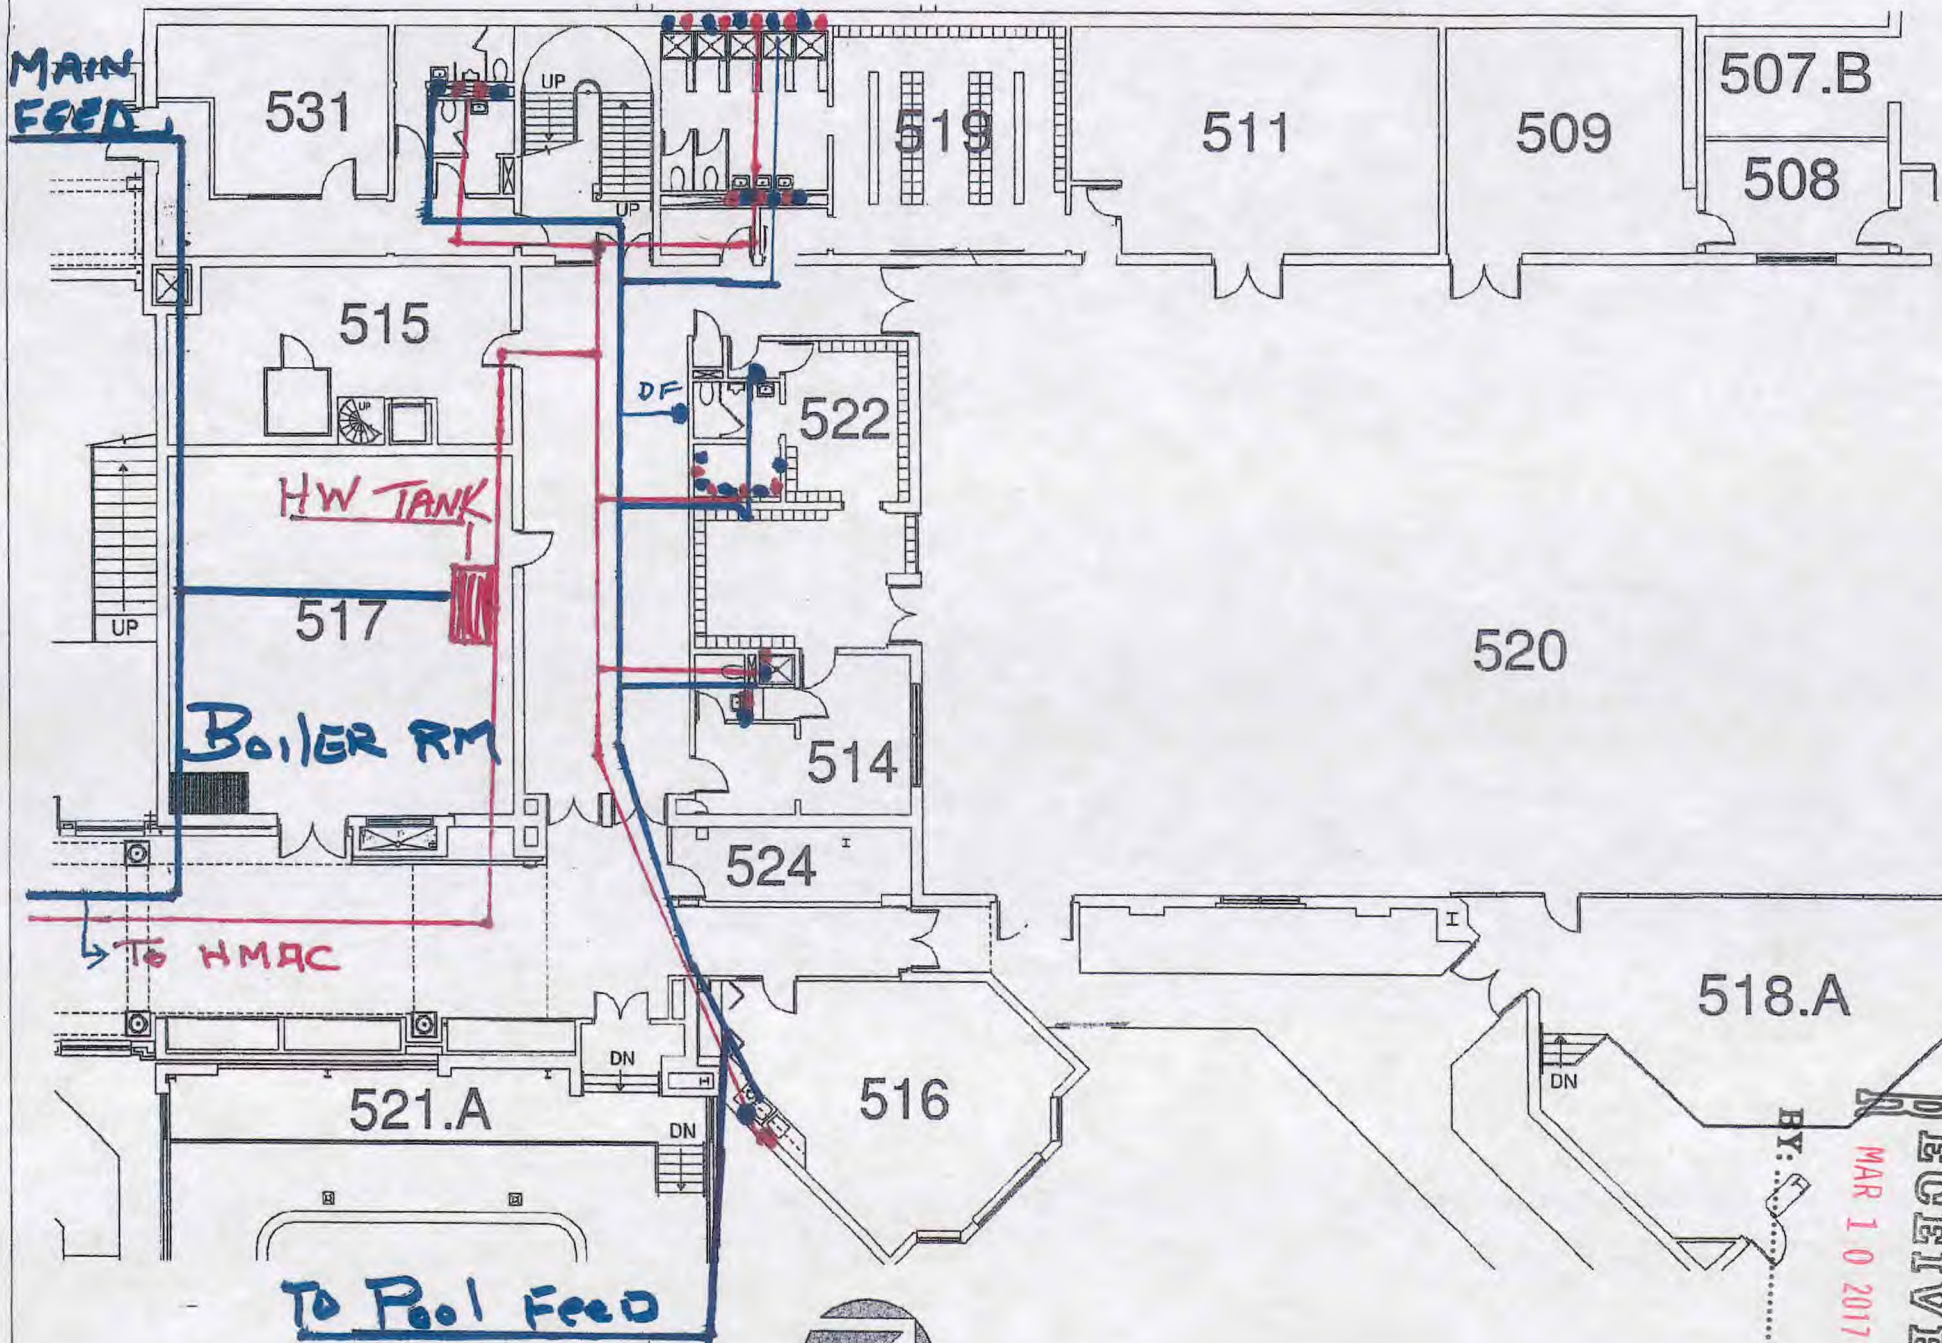

SCALE: 1/16" = 1'-0"


08/24/12



RECEIVED
MAR 10 2017
BY: [Signature]

RECEIVED
MAR 10 2017

BY

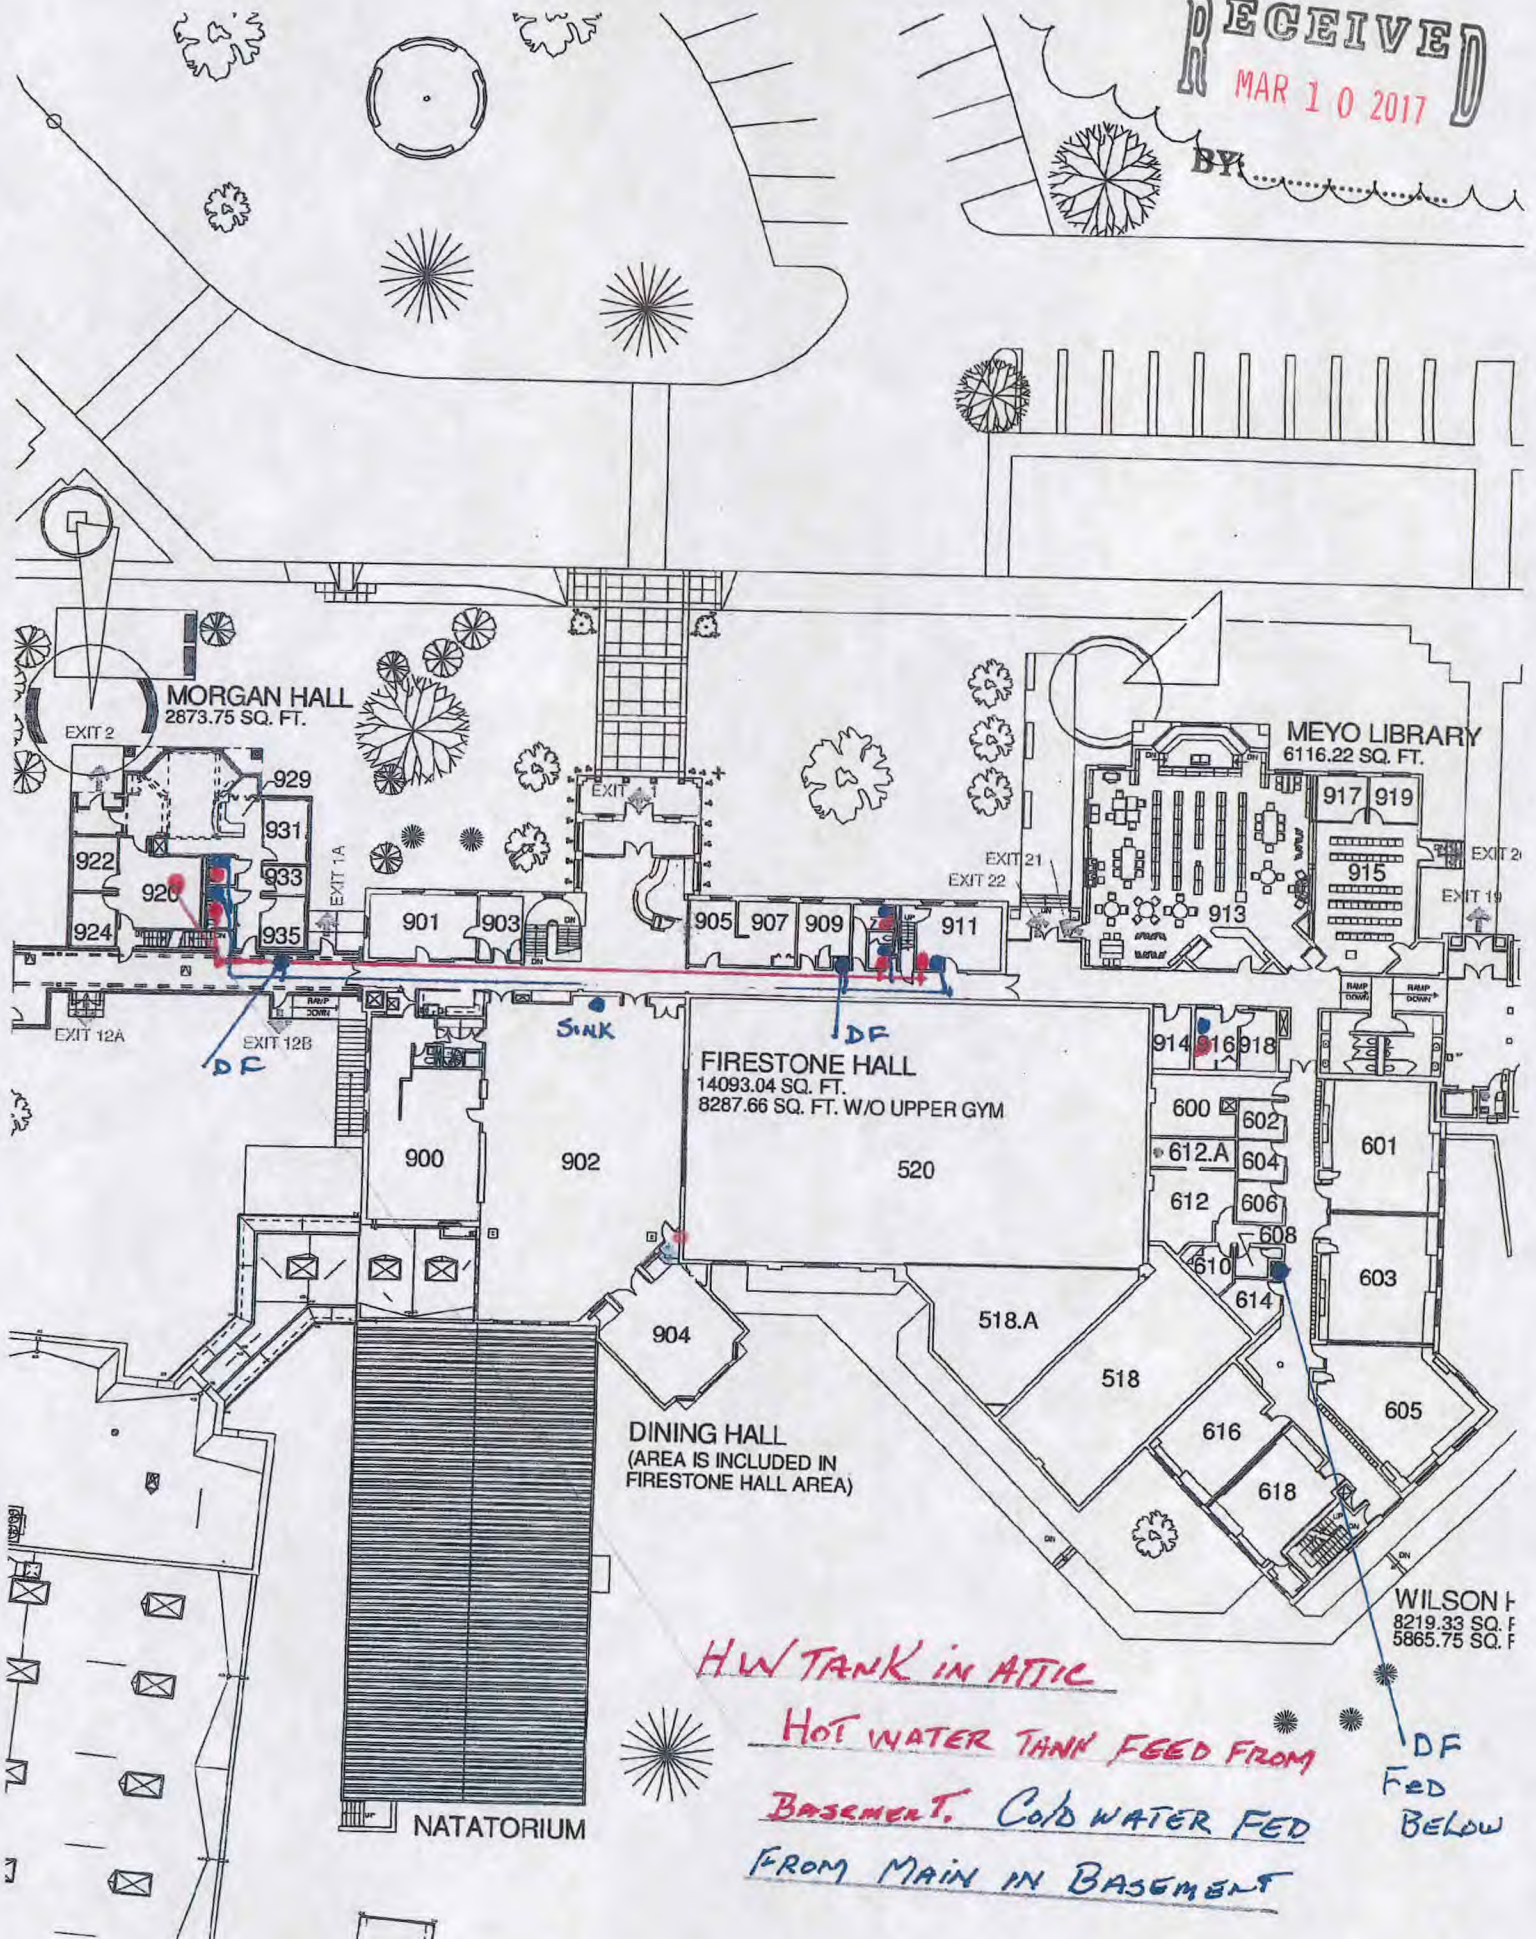

HW TANK IN ATTIC


HOT WATER TANK FED FROM
BASEMENT. COLD WATER FED
FROM MAIN IN BASEMENT


DF
FED
BELOW

RECEIVED
MAR 10 2017

WILSON LOWER HALL

BY:

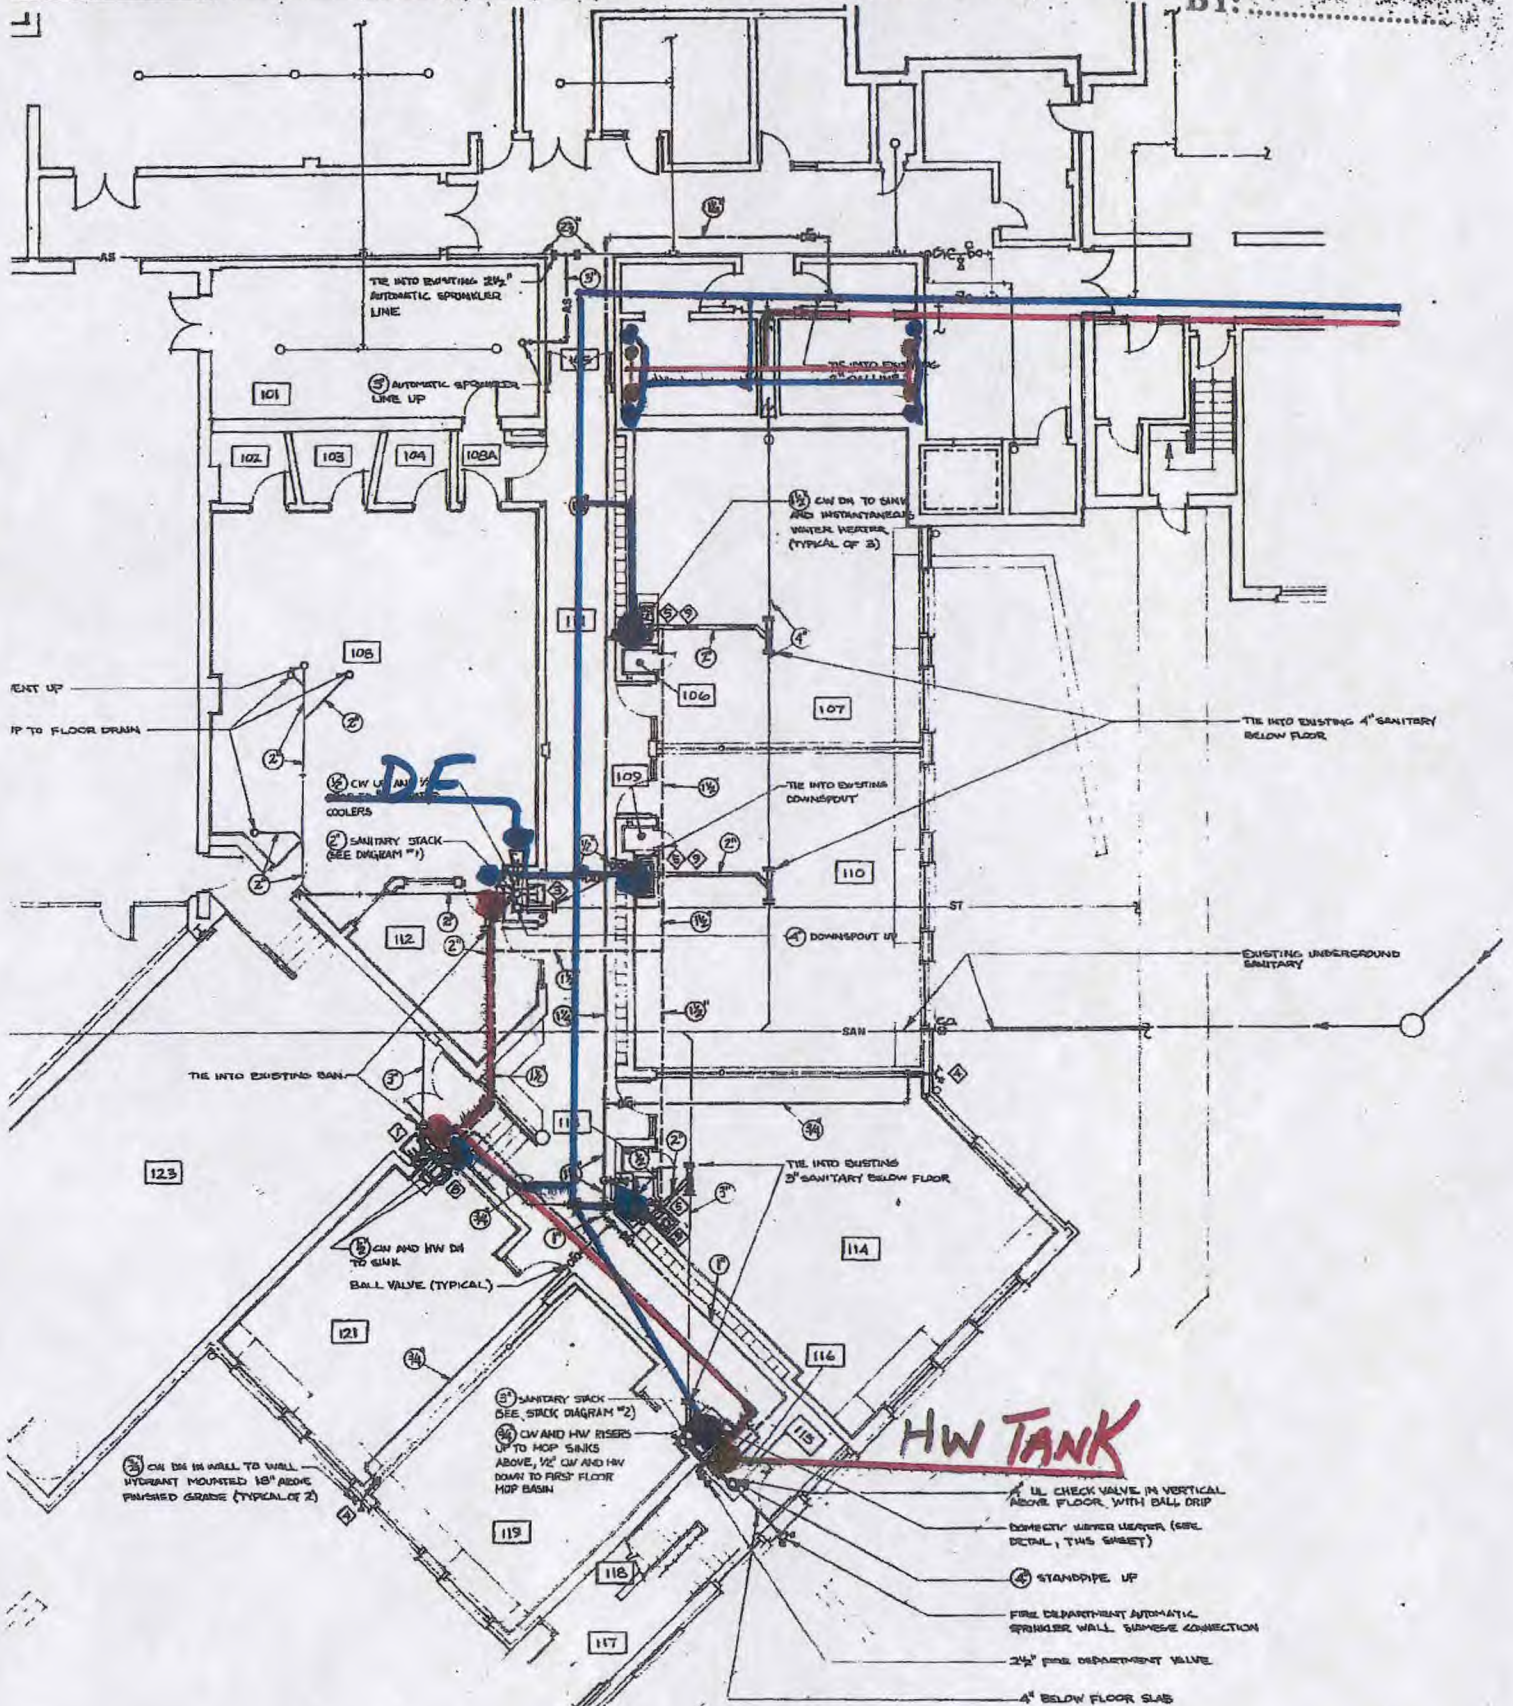

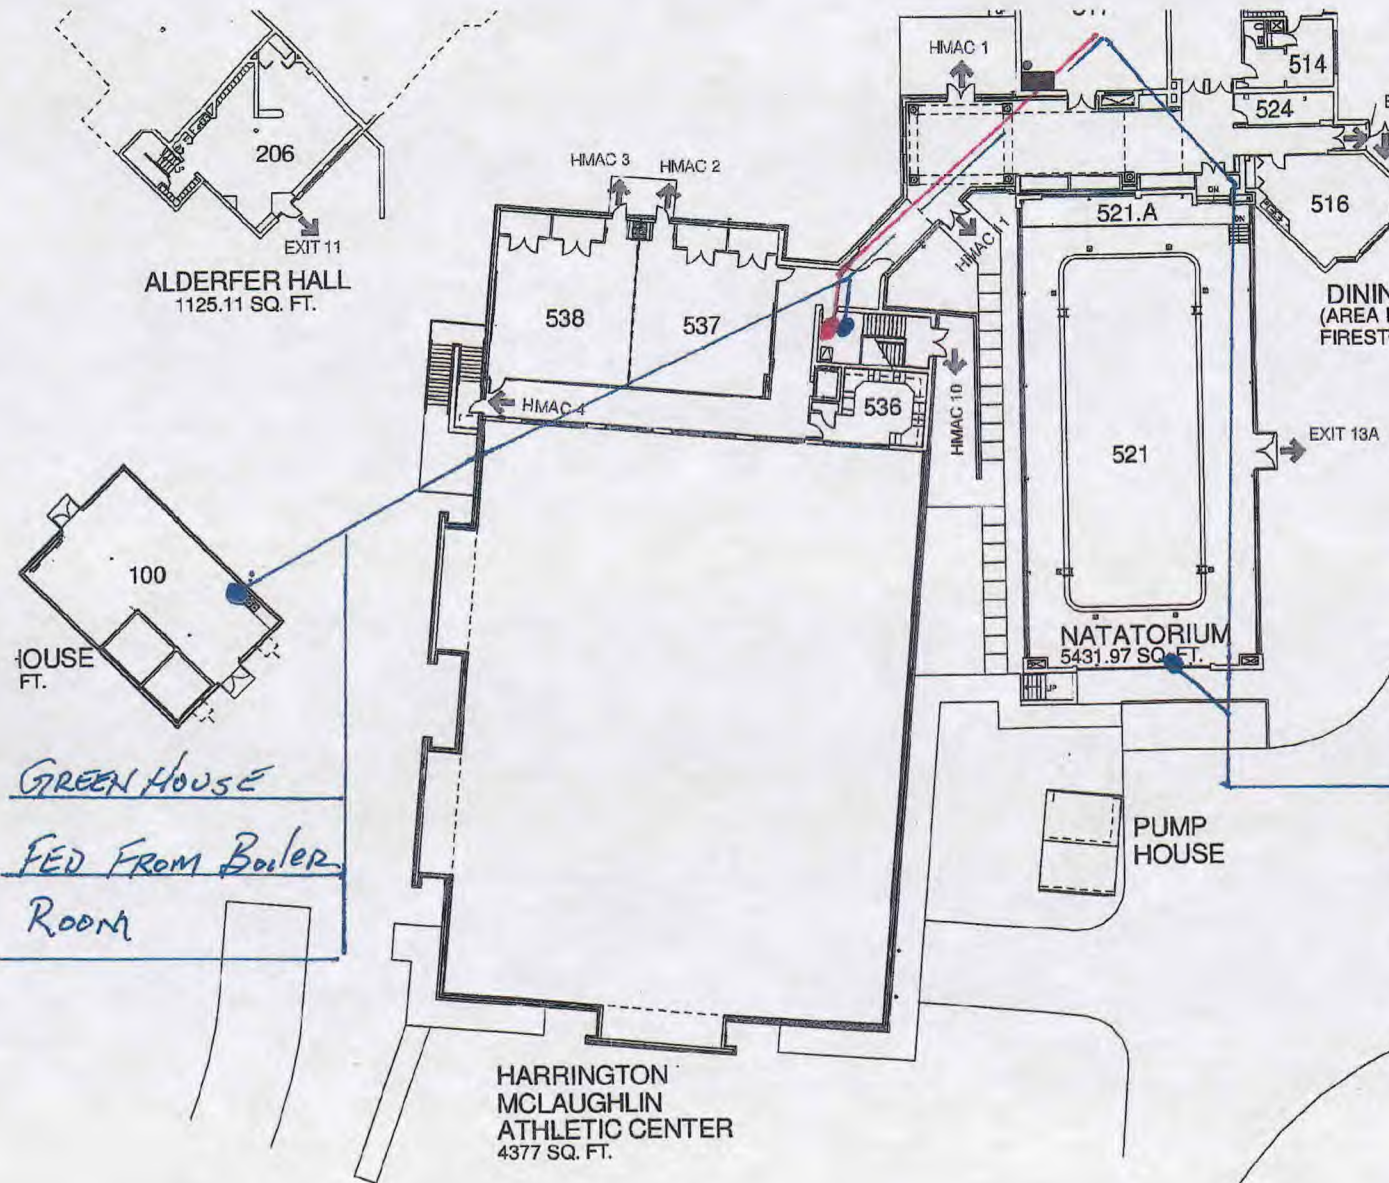

1


LOWER LEVEL OVERALL FLOOR

SCALE: 1" = 50'-0"

RECEIVED
MAR 10 2017
BY:

HMAC RESTROOMS

COLD AND HOT WATER FED FROM BOILER RM

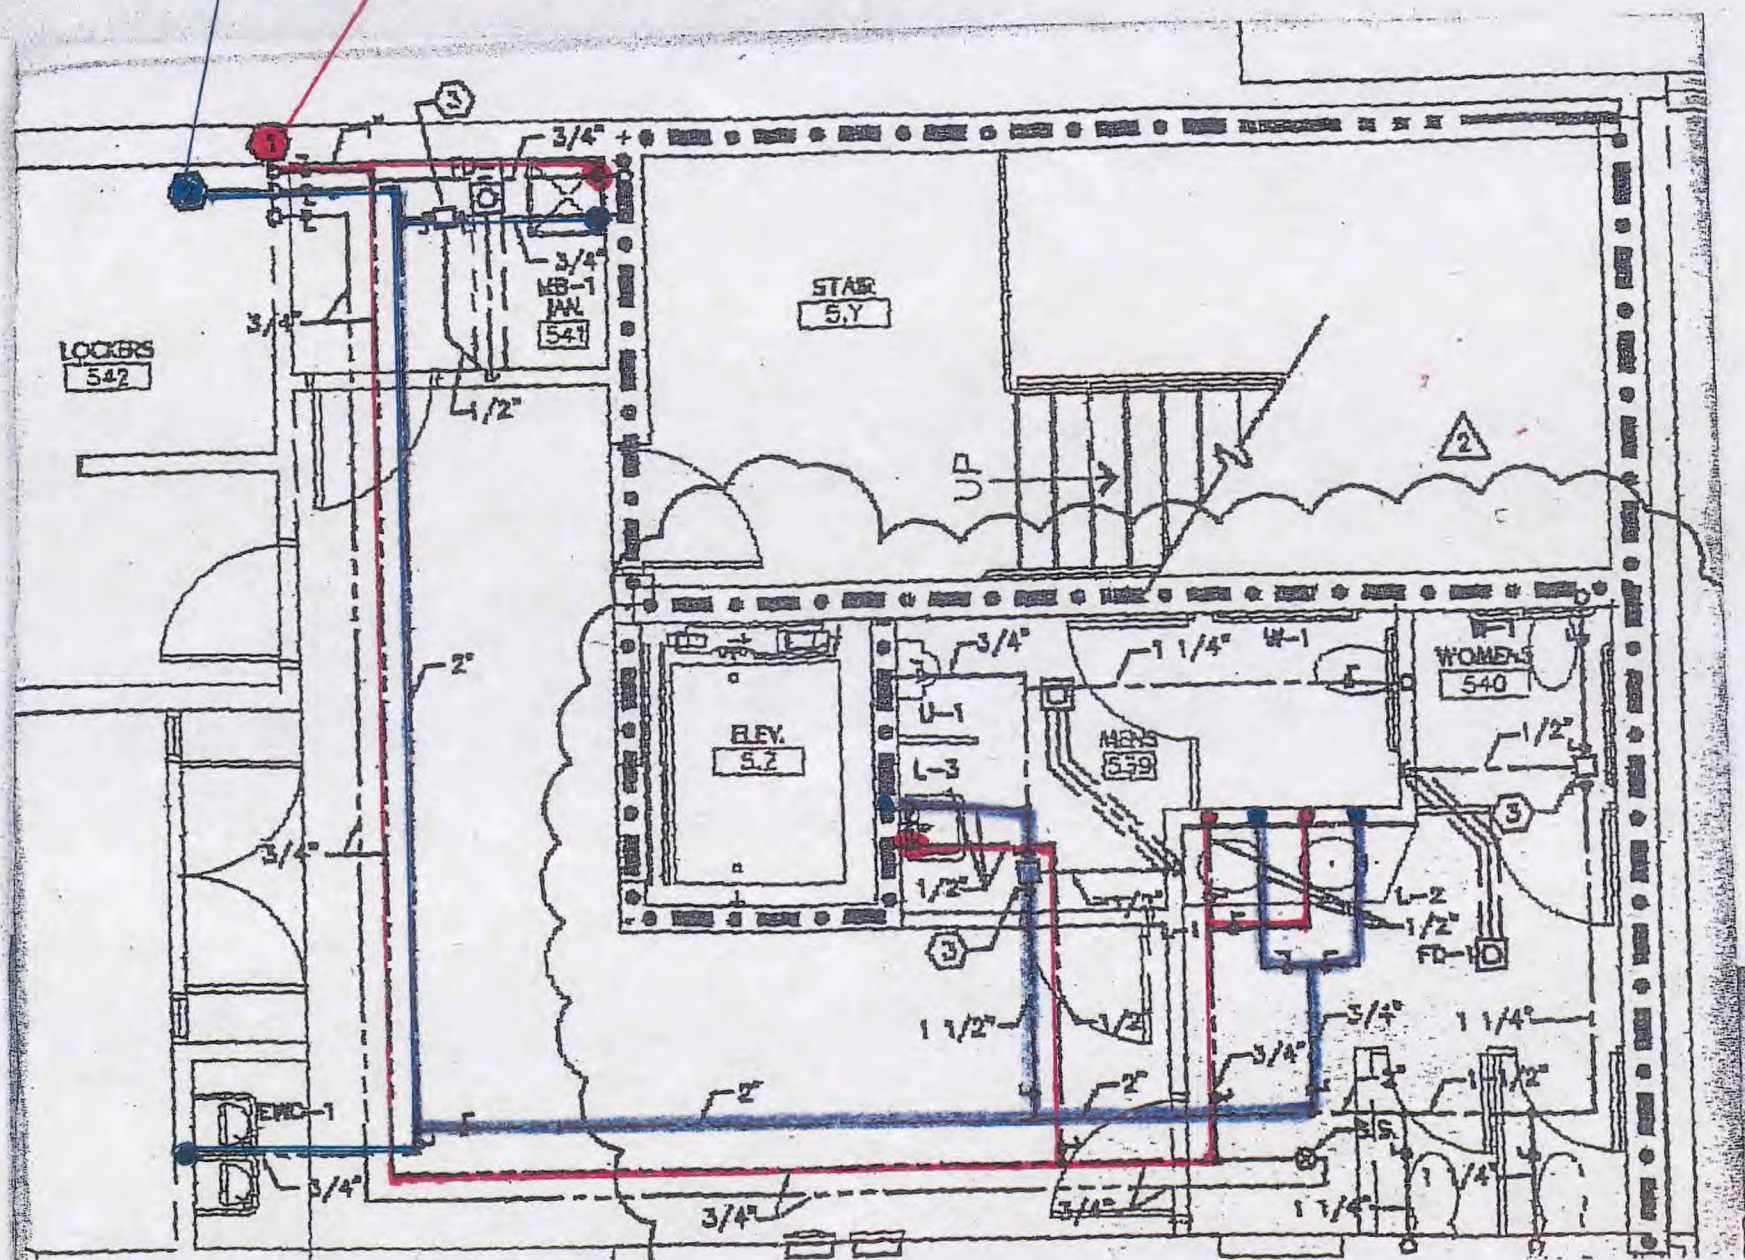

RECEIVED
MAR 10 2017
BY:

1-23-17

ELKAY®

INSTALLATION, CARE & USE MANUAL

Manual de Instalación, Cuidado y Utilización
Manuel d'installation/entretien/utilisation

RECEIVED
MAR 10 2017

BY:

EZ™ & LZ™ Series Bottle Filling Stations & Coolers

EZ™ & LZ™ Serie Botella Bombas y Enfriadores

EZ™ & LZ™ Stations de Remplissage de Bouteille Série et Refroidisseurs



"EWC-1" WATER COOLER

RECEIVED
MAR 10 2017

Accessory Apron
LKAPREZL

BY: **ELKAY**


SPECIFICATIONS

GENERAL

Accessory apron designed to bring Elkay water coolers into compliance with the Americans with Disabilities Act (A.D.A.) when units are mounted on an exposed wall. This apron provides the mandatory 27" (686 mm) floor to underside requirement when mounted in this manner. Suitable for use with models LZSTL8C, LZTL8C, EZSTL8C, EZTL8C, EZSTLR8C, EZTLR8C, EZSTLDDC, EZSTLRDDC and EZØSTL8C.


Construction

Thermo-formed textured ABS plastic. Available in gray only. Equipped with bottom cover plate.

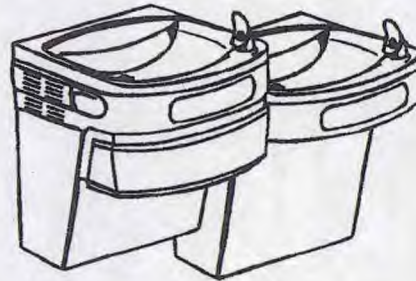


EZSTL8C - Shown with accessory apron LKAPREZL mounted.

FRONT VIEW

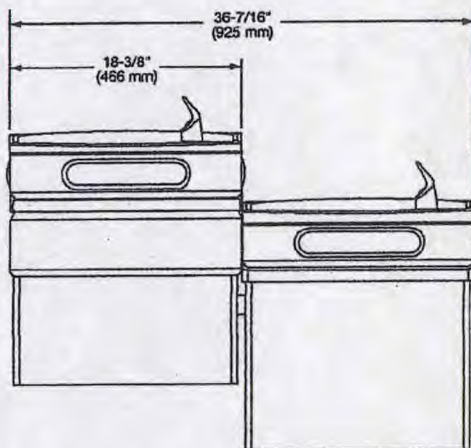

SIDE VIEW

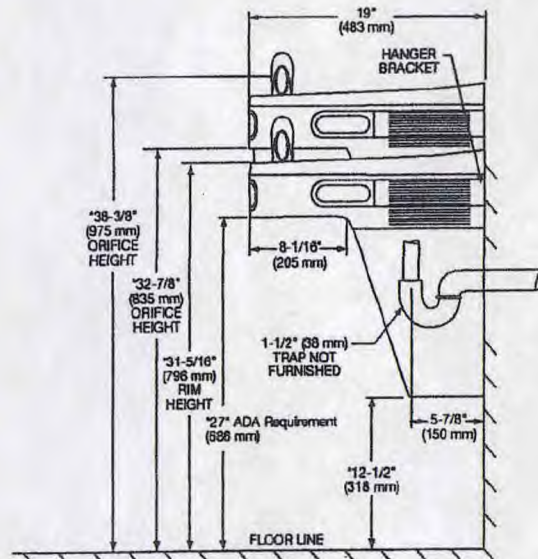

EZSTL8C shown with accessory apron LKAPREZL mounted.

Elkay Manufacturing Company

www.elkay.com


2222 Camden Court
Oak Brook, IL 60523

Printed in U.S.A.
©2000 Elkay Mfg. Co.

(05/00) 16-19

RECEIVED
MAR 10 2017

BY: IRA ROAD

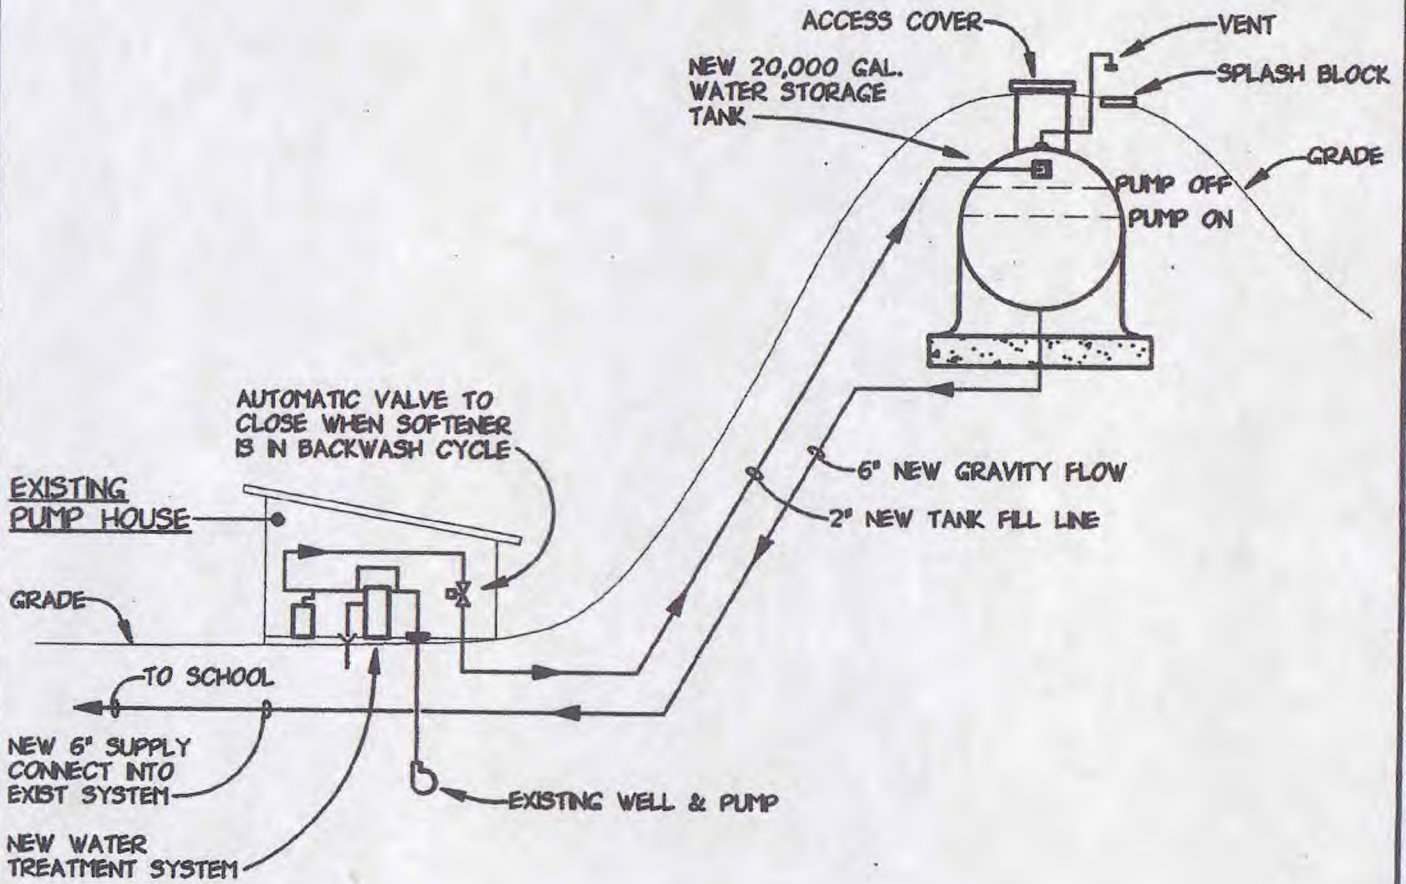

DOMESTIC WATER SCHEMATIC
EXISTING SYSTEM - REBUILT
NTS

OLD TRAIL SCHOOL
OPTION I
SCALE: NTS

		REVISION	
		DATE	
		CONSULTING ENGINEERS THETS ASSOCIATES INCORPORATED 2150 W. 13th Ave. • Suite 200 • Grand Rapids, MI 49506-1021	
		PROJECT NO. 950035 DRAWN BY: DJP CHECKED BY: GGL SCALE: NO SCALE DATE: 07-26-96 Sheet No. M-2	
WELL WATER SYSTEM RENOVATION OLD TRAIL SCHOOL 2315 BOA ROAD BOA, MI 49811			

