

LEAD MAPPING

SEASONS
456 SEASONS RD
STOW, Ohio
330 688-5553

OH 770 04812
Facility ID 7758634


William L. Roth Sr
operator -

John M. Roth + Son Inc
DBA Mr Dependable Pump
6200 Mandator Rd.
New Franklin, Ohio 44216

330 882 4111
Fax 330 882 6778
cell 330 819 9638
E. Mail Mr Dependable Pump @ SBC Global. Net

◇ = PULL BOX
 ○ = FIRE EXTINGUISHER
 △ = SMOKE DOOR

#3 Sink
 4 Hand Sink

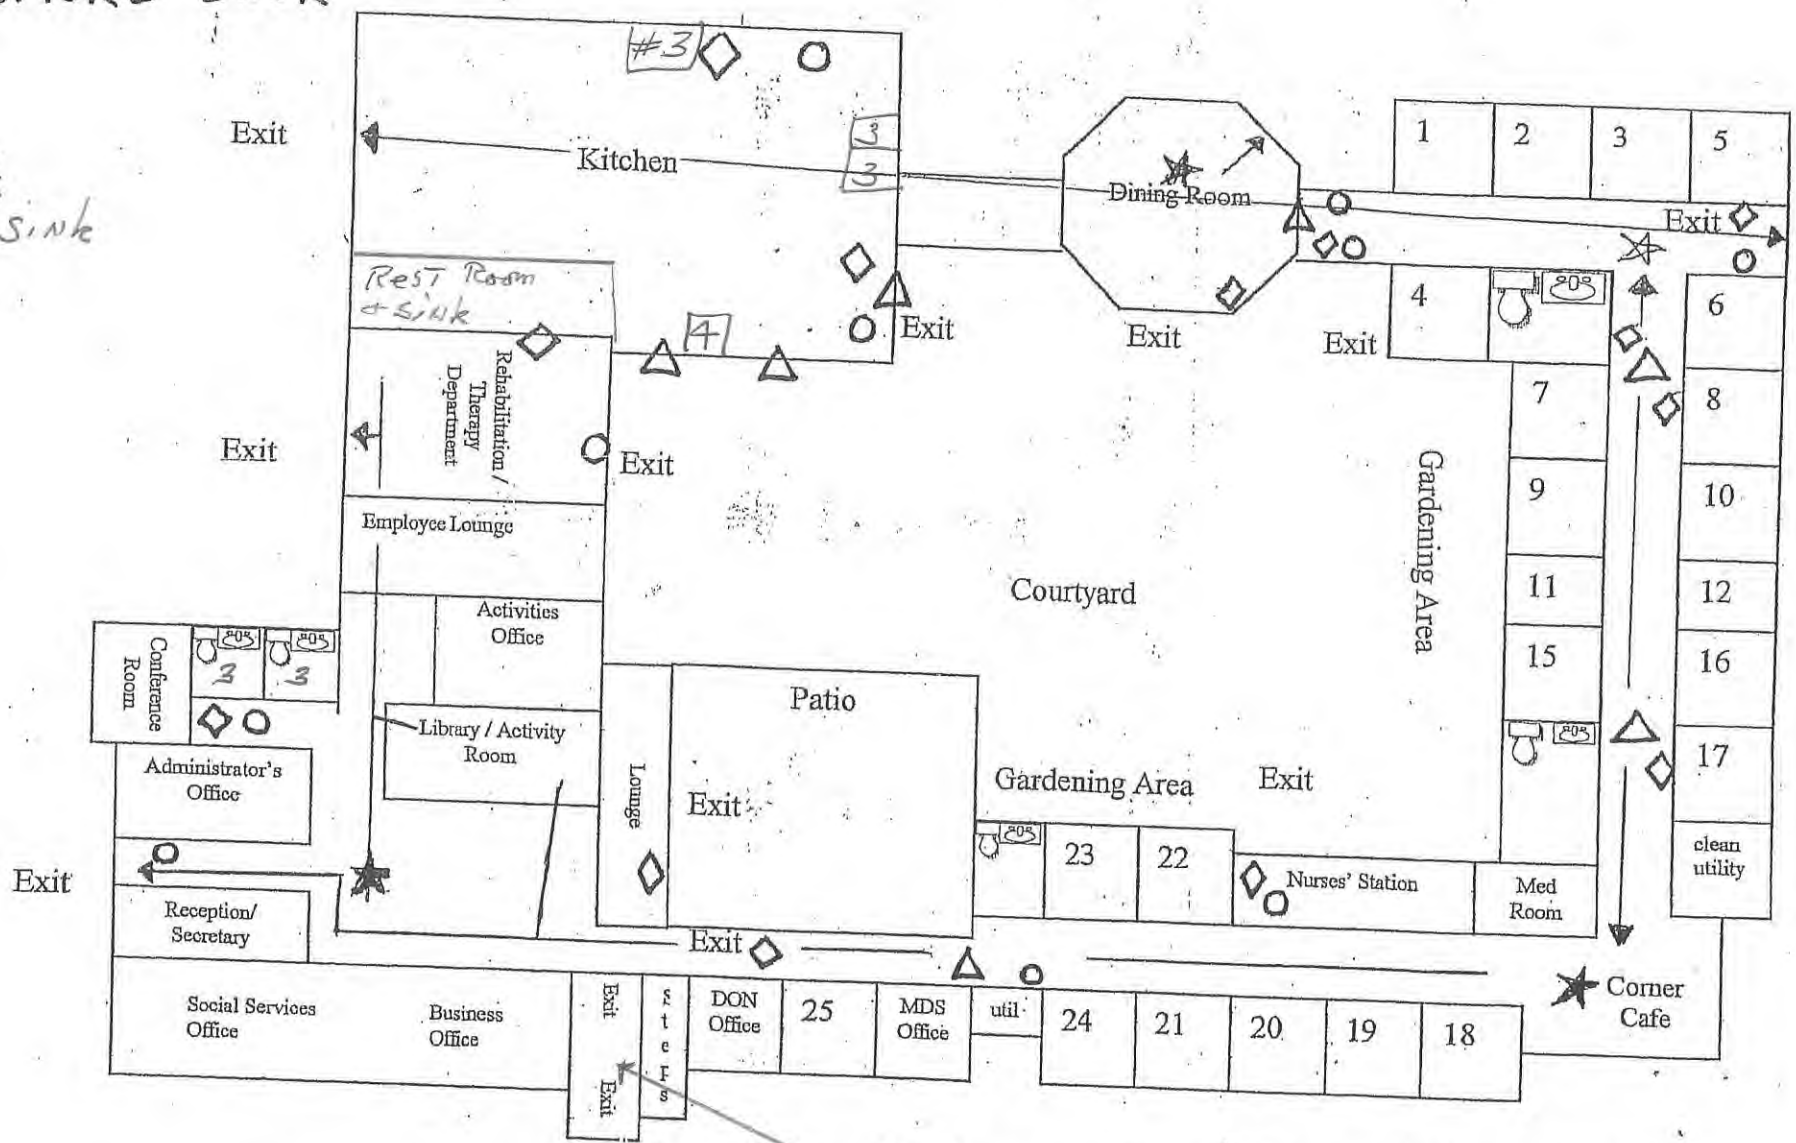


h-2-c

All # Rooms Have Sinks
Rooms are Residents
NOT Suitable For Testing

Employees Break Room Sink + Toilet #3
DRINKING WATER FOR RESIDENTS
Supplied From Kitchen

Basement

SEASONS.
456 SEASONS RD
STOW, Ohio 3306885353

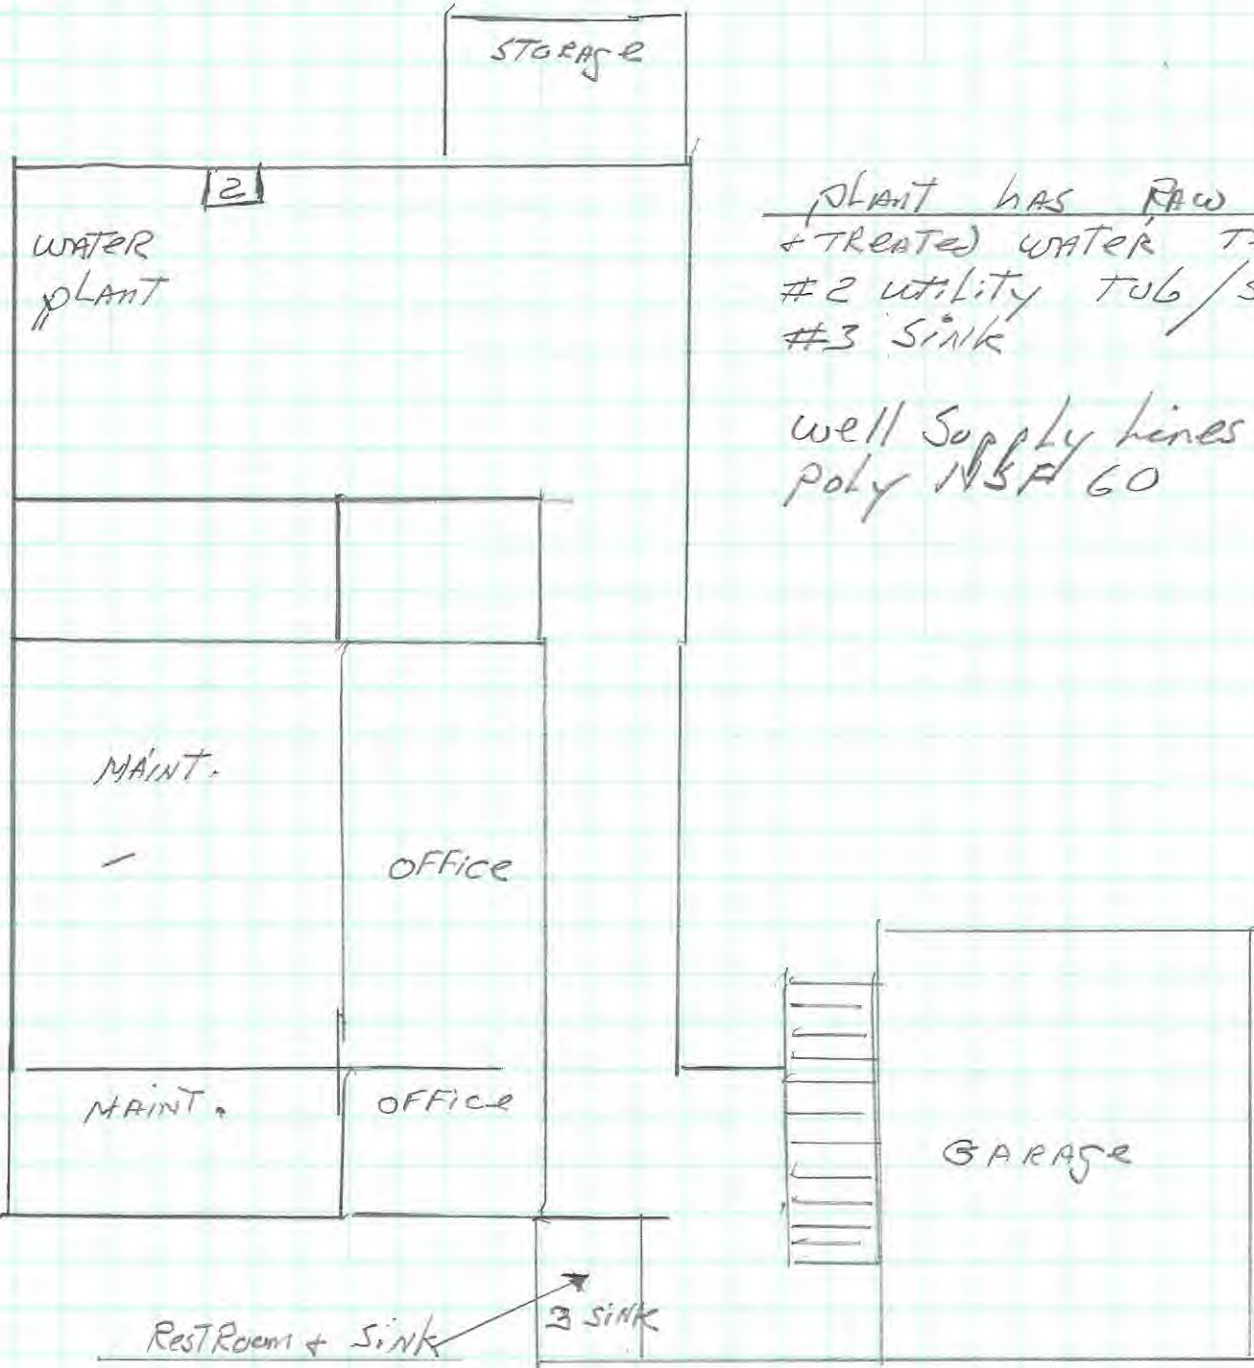

PLANT HAS RAW WATER
+ TREATED WATER TEST PORTS
#2 utility TUB/SAMPLING PORT.
#3 Sink

well supply lines 2 are
poly NSF 60



Most piping is pre 1986 and would be
suspect

* Notice system will be on city water
& sewer in April 2017