


RE: American Augers
Report
Drinking Water Program
Ashland County
PWS ID: OH0333112

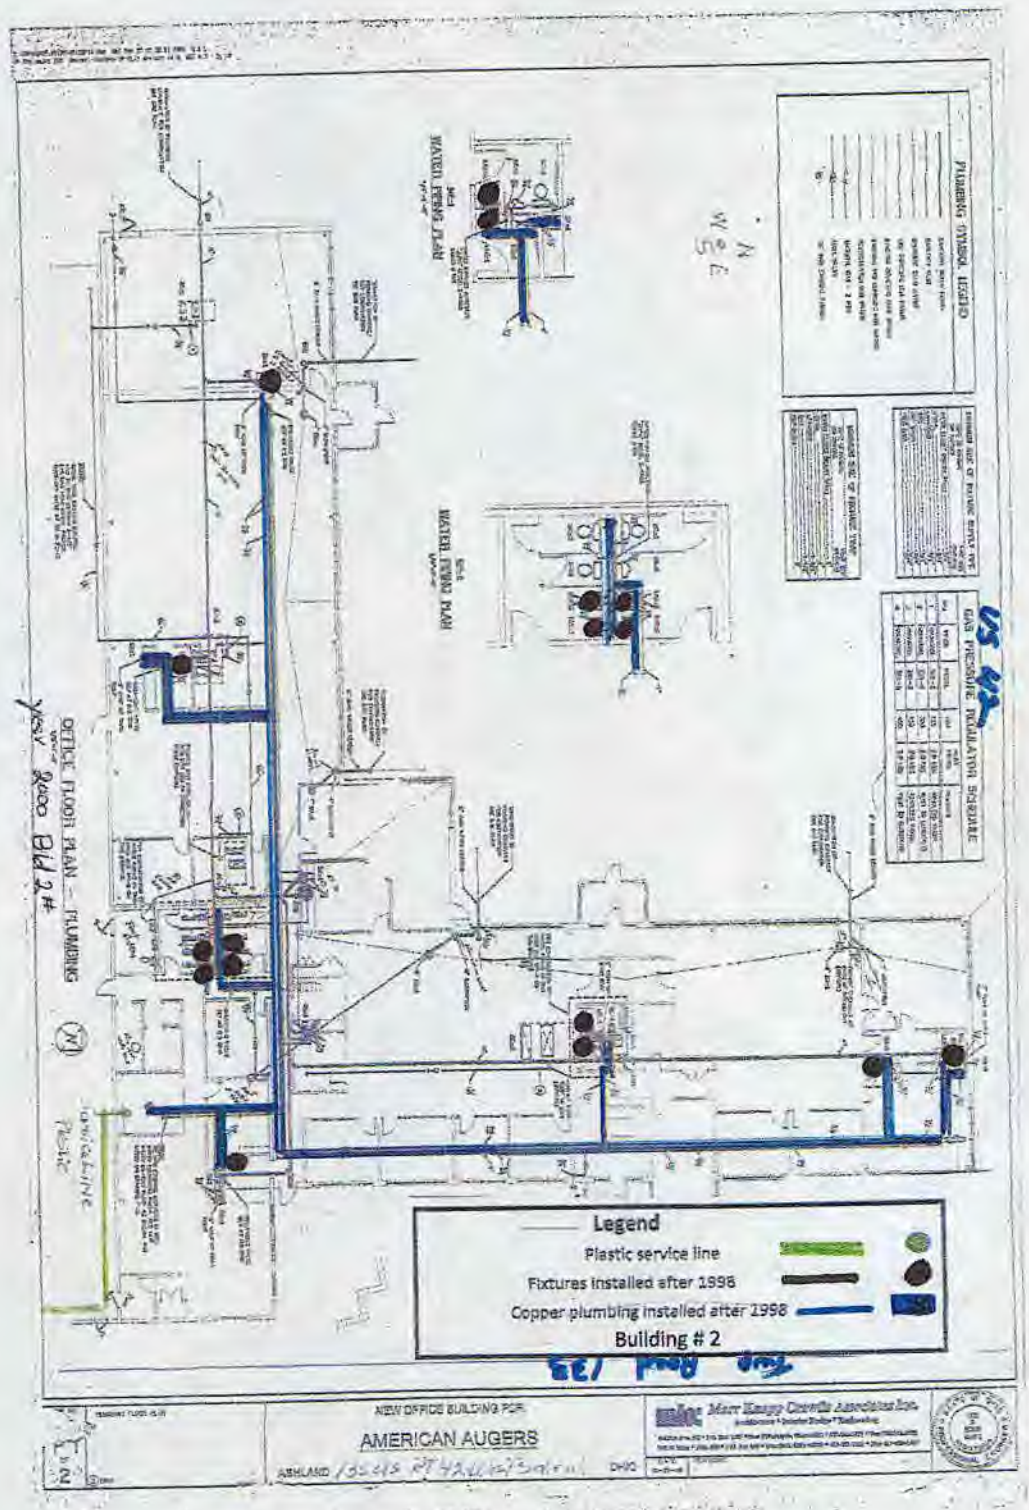


RECEIVED
MAR 08 2017
DDAGW - NWDO

Revised

N
W
E
S

MS RT 42

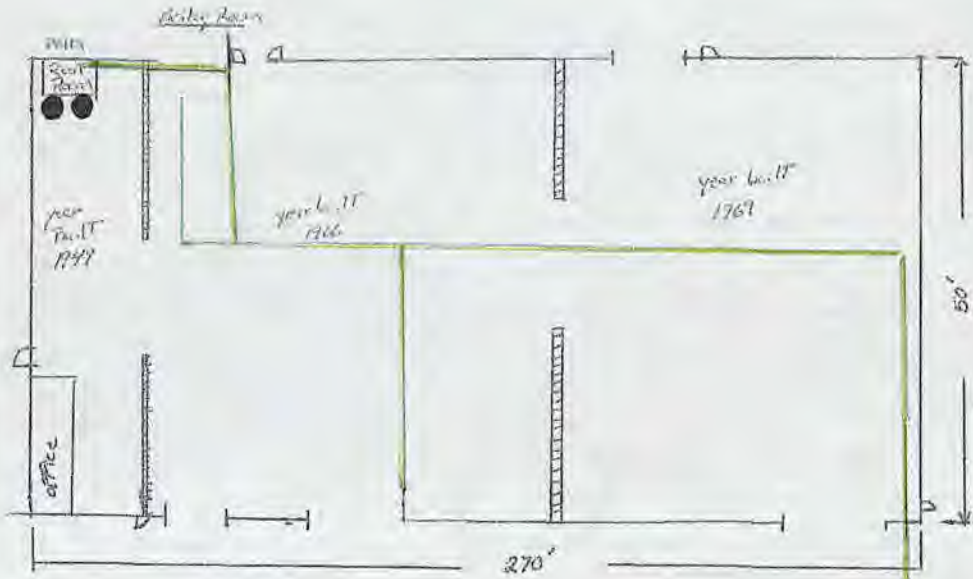

Legend

Plastic service line 

Fixtures installed after 1998 

Building # 1

AMERICAN AUGUR'S
13525 RT 42 LOT 5 Salem, CA 95670
415-255-7017
No. 8016

Temp Rd 133

Building 1

RECEIVED

MAR 08 2017

DDAGW - NWDO