



RECEIVED
MAR 15 2017
OHIO EPA NEDCO

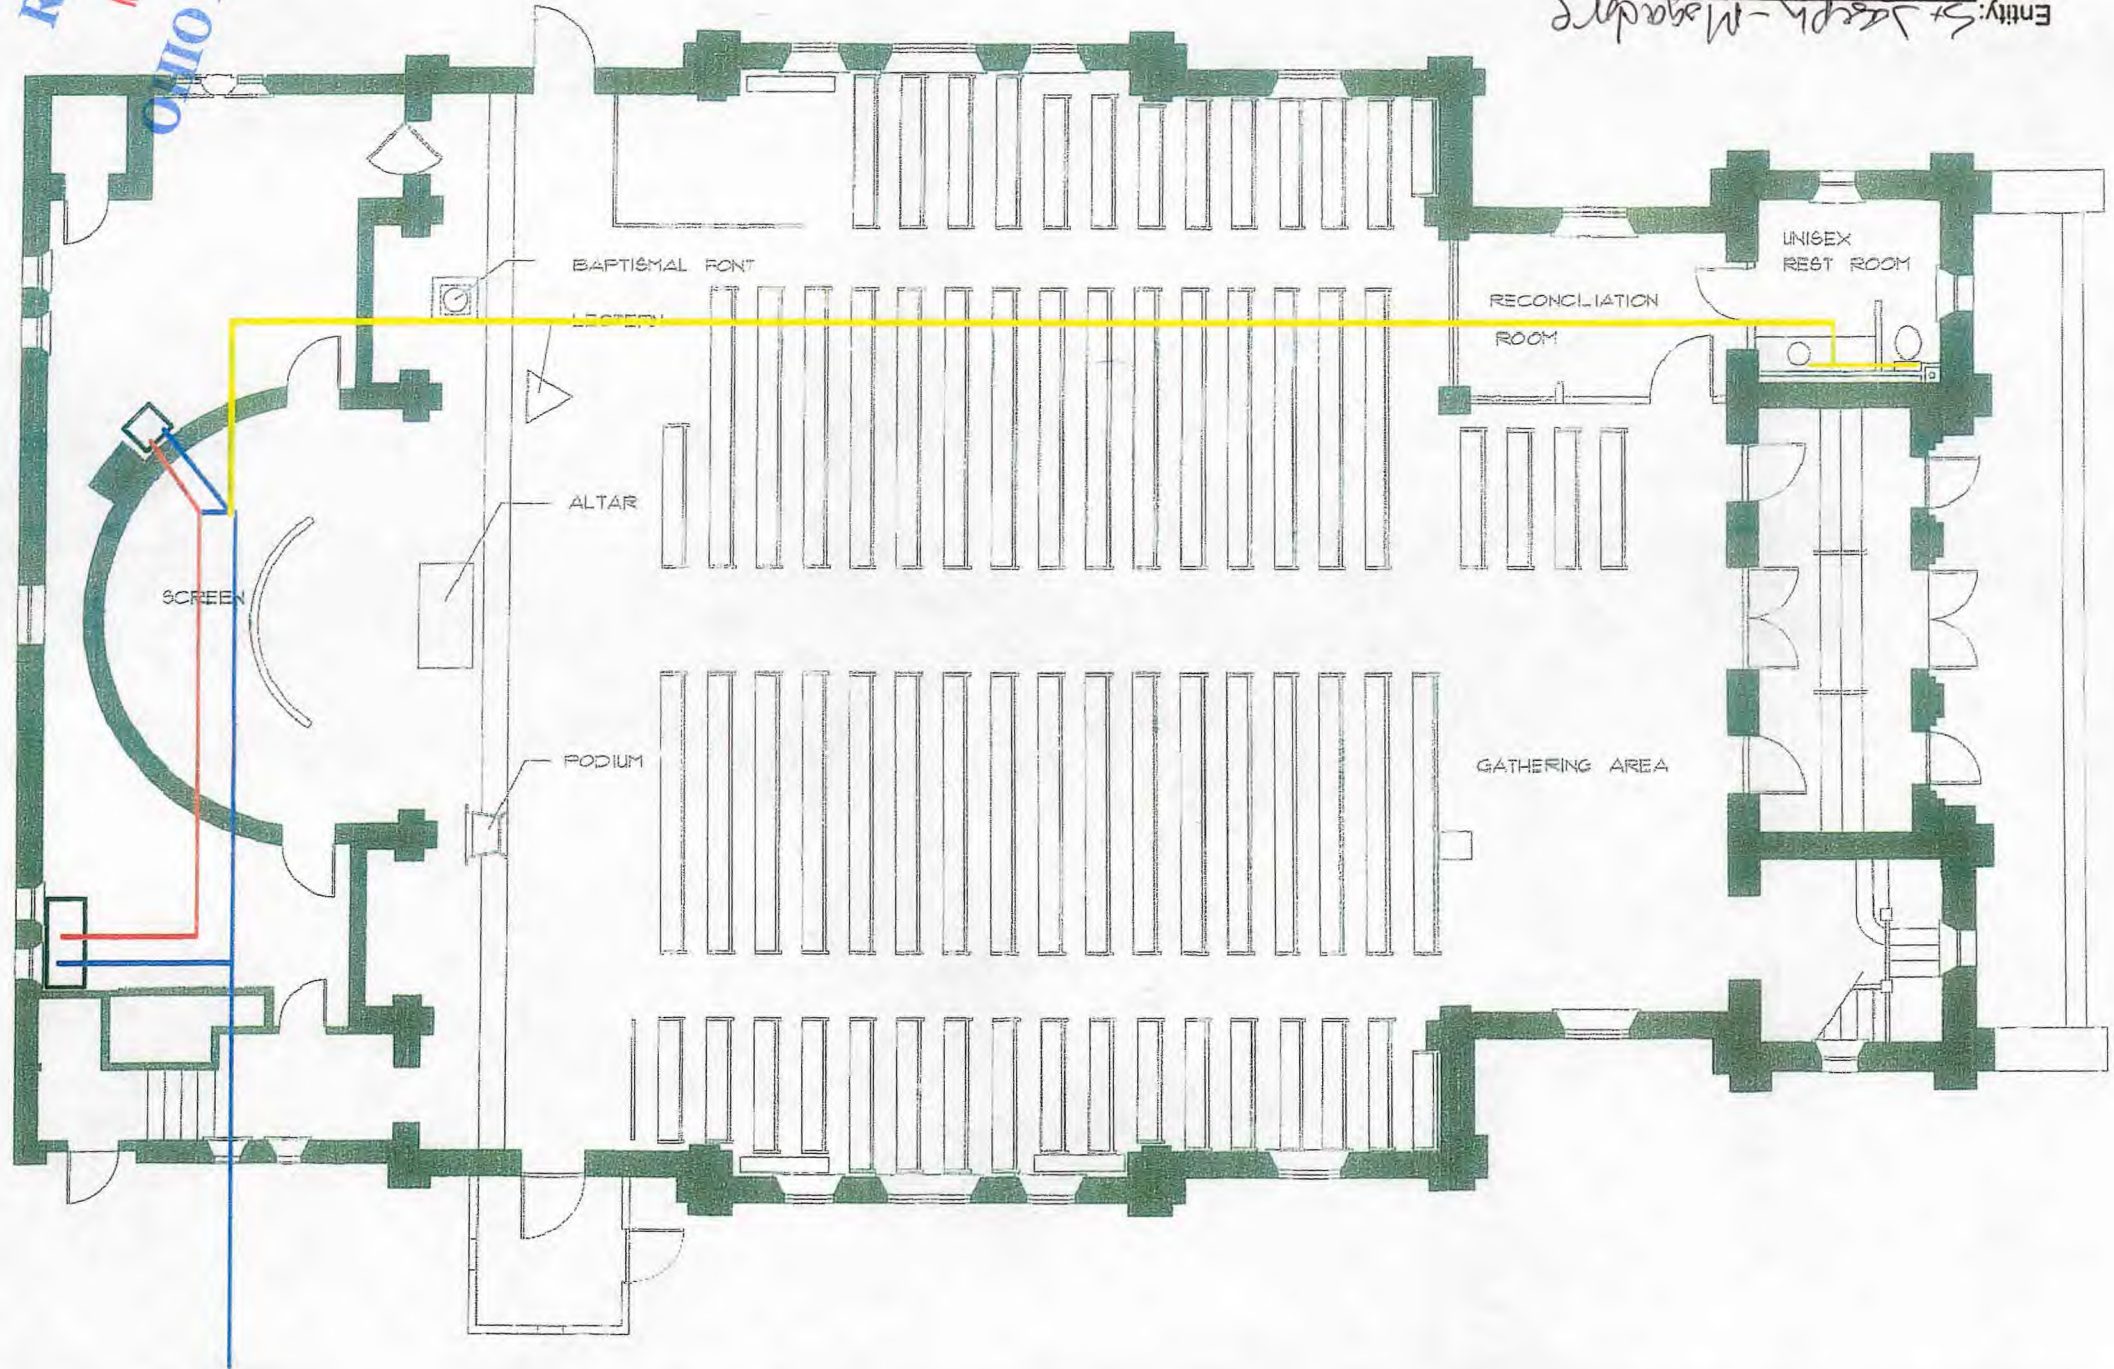


Entity: St Joseph - Magadore
Doc Type: Report
Doc Subtype:
Program: PPAW
County: Perry
Secondary ID: 01675391A

CHURCH
BLUE LINES = Galvanized
RED LINES = Copper
YELLOW = PVC

Daycare Center

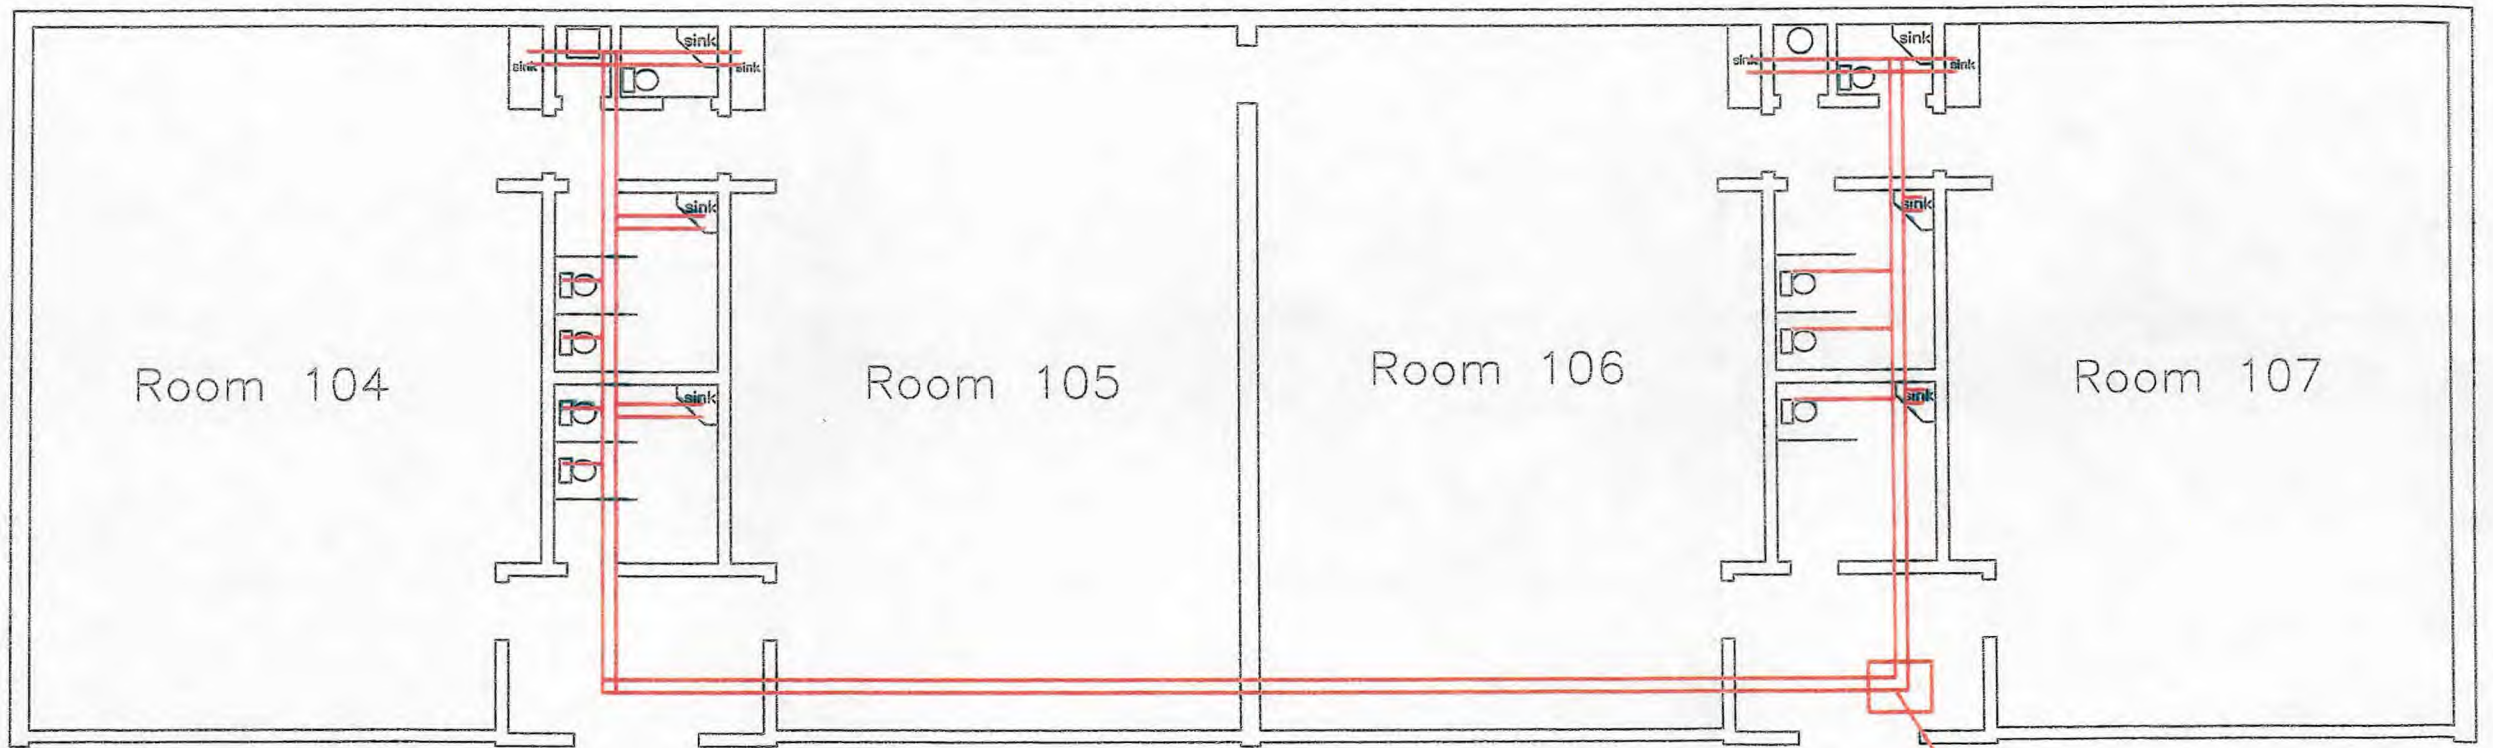


RED LINES = Copper

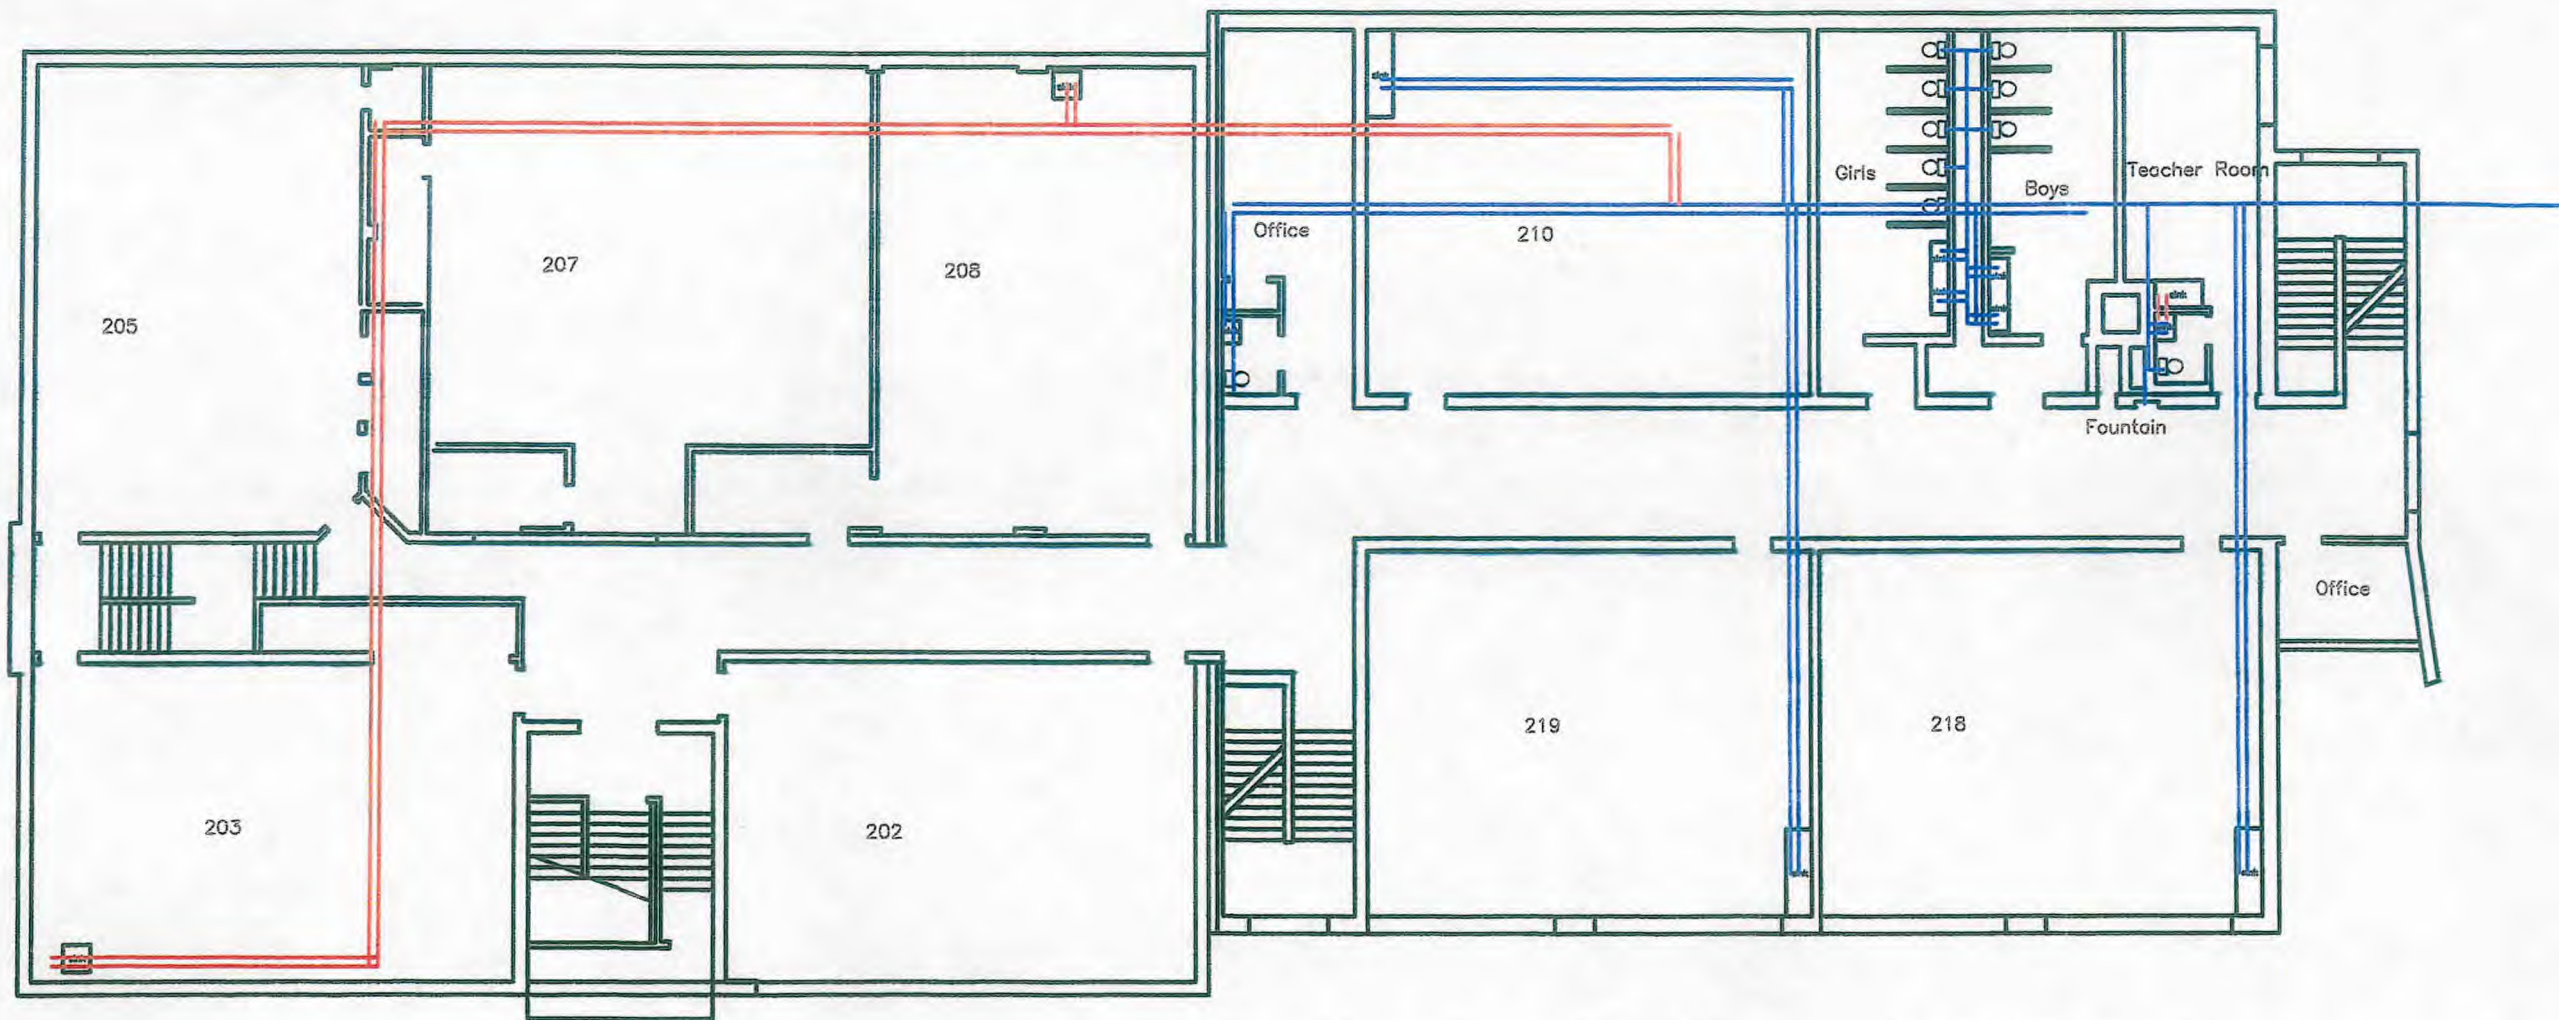

Second Floor of School

BLUE LINES = Galvanized
RED LINES = Copper

Rectory

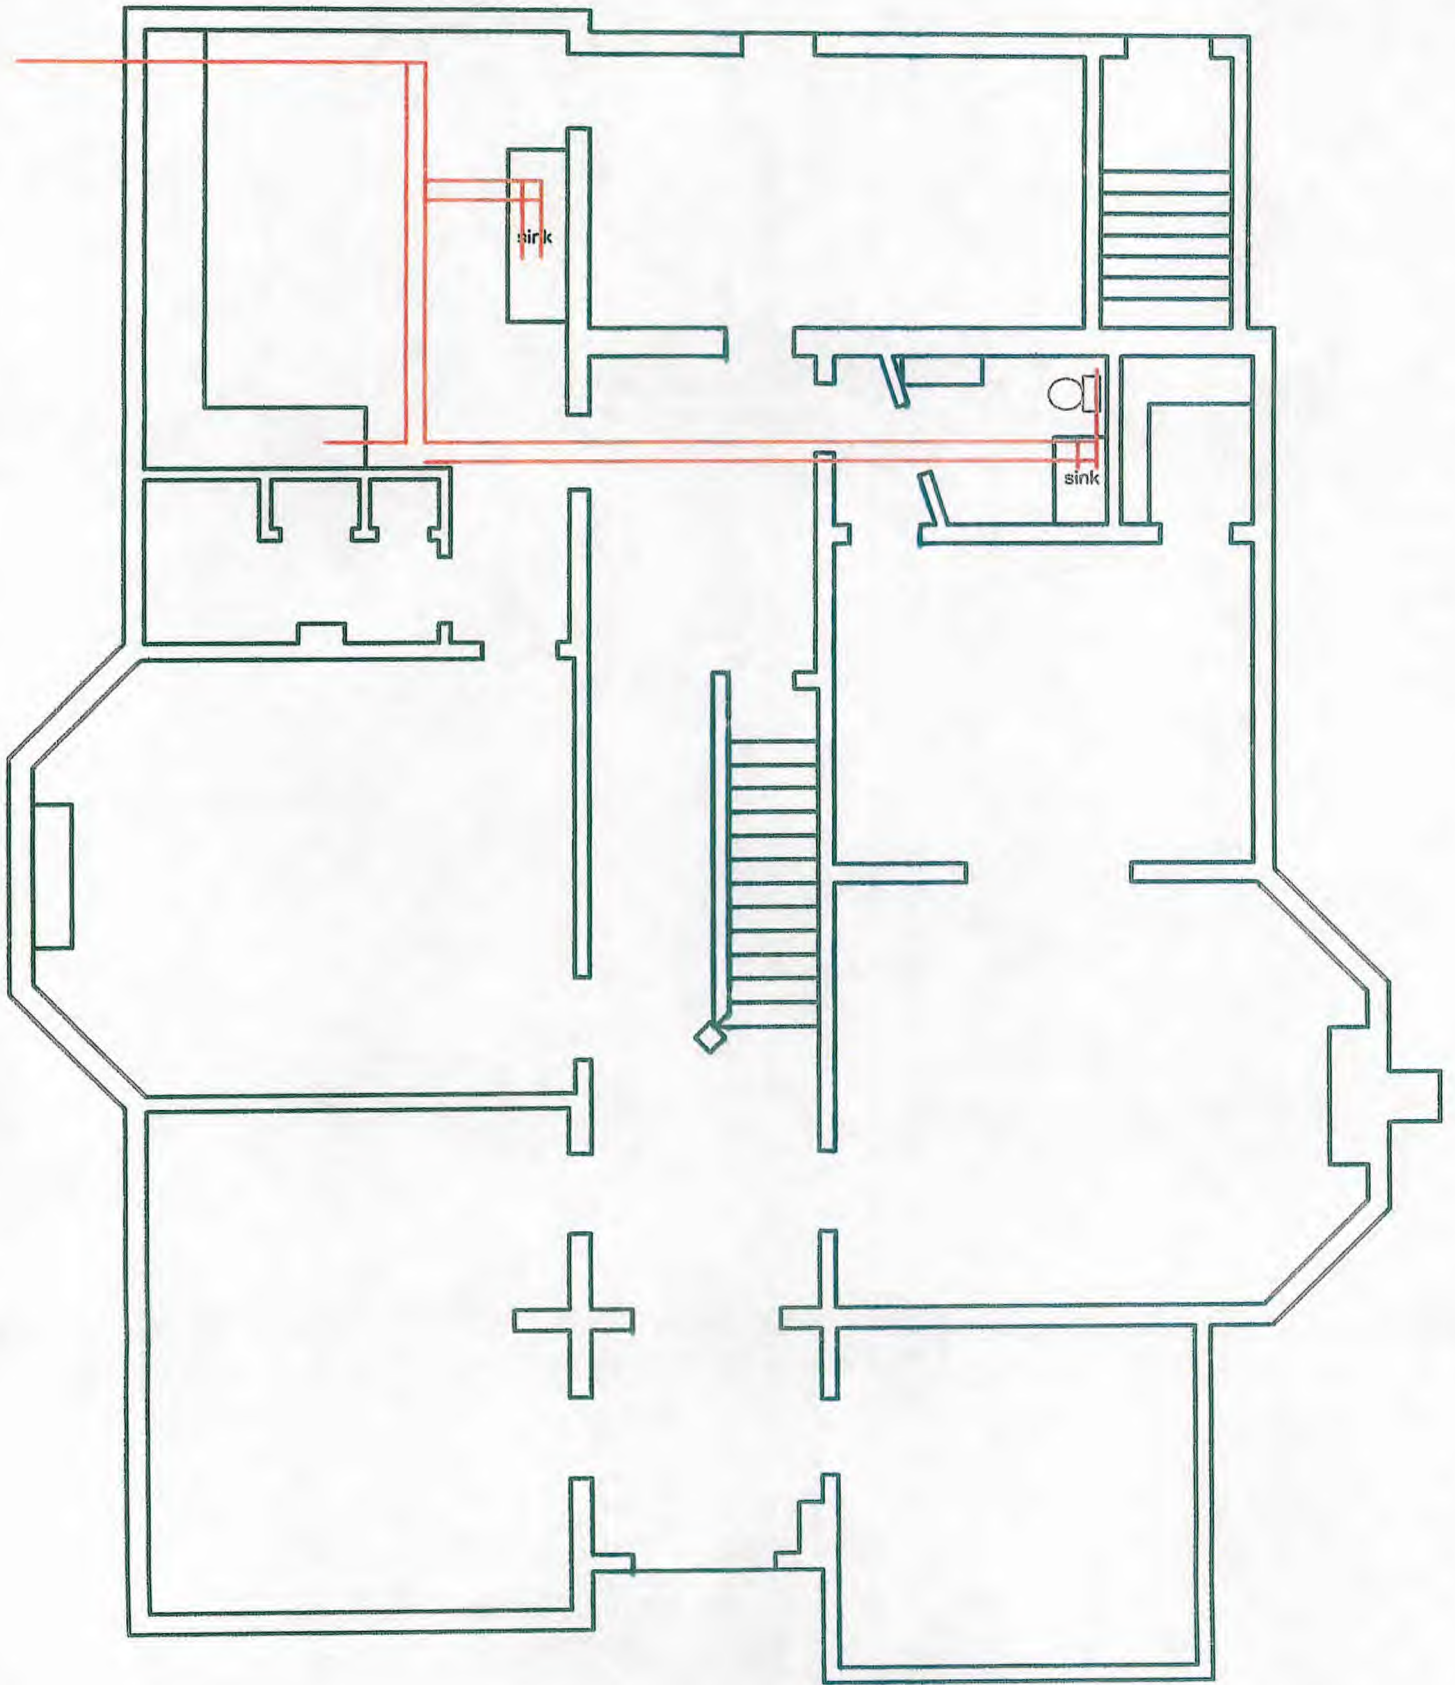

RED LINES = Copper