


RE: Pax Machine Works
Report
Lead Mapping
Drinking Water Program
Mercer County
PWS ID: OH5438212

RECEIVED

MAR 02 2017

DDAGW - NWDO

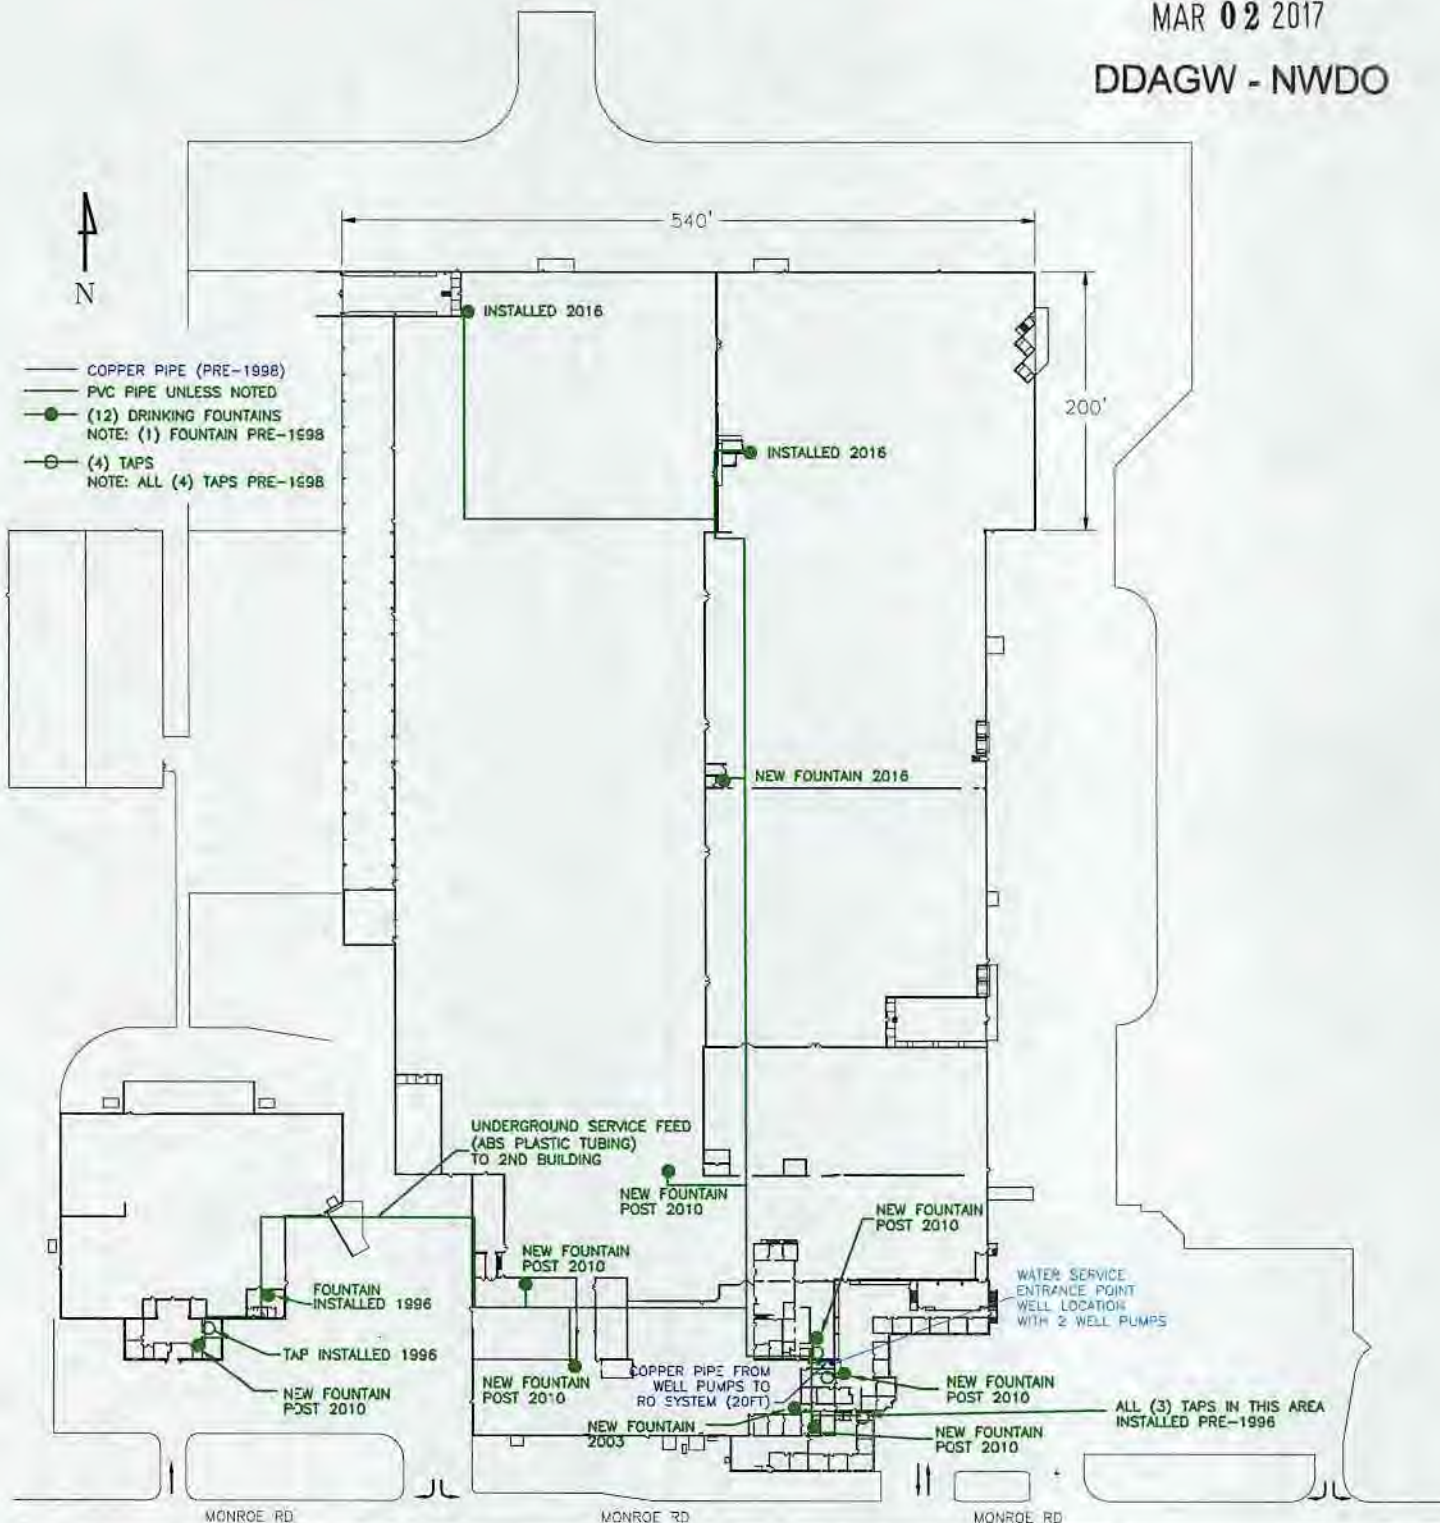

PWS ID: OH5438212
 PAX MACHINE WORKS, INC
 5139 MONROE RD
 CELINA, OH 45822
 PHONE: 419-586-2337
 CERTIFIED OPERATOR:
 JOSEPH H. HAMBERG
 WS1-1104948-6

NOTE: BUILDINGS BUILT PRIOR TO 1998 OR THAT USE PLUMBING MATERIAL OR SOLDER MANUFACTURED BEFORE 1998 MAY HAVE MATERIALS WITH GREATER THAN 8% LEAD AND ARE AT A HIGHER RISK OF CONTRIBUTING LEAD TO THE DRINKING WATER THAN MATERIALS MANUFACTURED AFTER 1998. IN ADDITION, BUILDINGS BUILT AND PLUMBING MATERIALS MANUFACTURED AFTER 2014 WERE REQUIRED TO HAVE LESS THAN 0.25% LEAD BY WEIGHT AND HAVE THE LOWEST RISK FOR CONTRIBUTING LEAD TO THE DRINKING WATER. IT SHOULD BE NOTED HOWEVER THAT, ALTHOUGH PROHIBITED, SOME USE OF LEADED SOLDER OR LEADED COMPONENTS MAY HAVE OCCURRED AFTER THE PROHIBITIONS BECAME EFFECTIVE.

PLEASE ALSO NOTE: SINCE 2001, FOR ALL TESTING TAKEN DURING EVERY 3 YEAR CYCLE, LEAD HAS BEEN LESS THAN 5 UG/L (LESS THAN THE MDL FOR LEAD) (LAST TEST WAS COMPLETED IN 2016)