

RE: Country Acres Golf Club
Report
Lead Mapping
Drinking Water Program
Putnam County
PWS ID: OH6901412

Country Acres Golf Club

17374 St. Rt. 694

Ottawa, OH 45875

(419) 532-3728 Fax (419) 532-3432

e-mail: jhcgcs@bright.net

OH6901412: Facility ID: 6957589

RECEIVED

APR 24 2017

OHIO E.P.A.
N.W.D.O.

Lead & Copper Water System Narrative:


Country Acres Golf Club was built in the summer of 1977. In October of that year I came in as the Golf Course Superintendent. The following fall (1978) the lines were installed for our potable water system. I oversaw the construction and can verify that all of the water lines consist of PVC pipe, varying from 8", 6", 4", 3" and 2" piping. The service connections to all of the houses and buildings consist of Dresser Style 0294 quick taps, (or equivalent) with 1" pvc, or poly piping for supply lines.

The only buildings in the development that have copper plumbing would be the Clubhouse for the Golf Course and the Huey Investment Apartments. The Clubhouse was built in 1980 and the Apartments in the later 80's or early 90's. They are both highlighted on the map.

"Buildings in Ohio built prior to 1998 or that use plumbing material or solder manufactured before 1998 may have materials with greater than 8% lead and are at a higher risk of contributing lead to the drinking water than materials manufactured after 1998. In addition, buildings built and plumbing materials manufactured after 2014 were required to have less than 0.25% lead by weight and have the lowest risk for contributing lead to the drinking water. It should be noted however that, although prohibited, some use of leaded solder or leaded components may have occurred after the prohibitions became effective."

All single family dwellings and other buildings are plumbed with PVC or CPVC piping.

Respectfully Submitted:

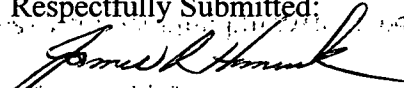

James R. Hemrick CGCS

RECEIVED

APR 24 2017

OHIO E.P.A.
N.W.D.O.

**VERIFICATION FORM FOR COMMUNITY PUBLIC WATER SYSTEMS
CLAIMING NO LEAD SERVICE LINES**

The owner or operator of all community public water systems must identify and map areas of their distribution system that are known or are likely to contain lead service lines. Systems must submit a copy of the applicable map to the Ohio Department of Health and the Ohio Department of Job and Family Services. Systems must also submit a report to the director containing at least both of the following: (1) The applicable map with narrative, and (2) A list of sampling locations used to collect samples as required by Ohio Revised Code (ORC) Section 6109.121 and any rules adopted thereunder, including contact information for the owner and occupant of each sampling site.

Should a water system determine no lead service lines exist in their distribution system, they must provide information stating they reviewed, at the minimum, historical permit records and local ordinances, distribution maintenance records and information pertaining to installation dates or materials for all services lines. This information must be verified below.

I HEREBY CERTIFY THAT THE FOLLOWING METHOD(S) WERE USED TO DETERMINE NO LEAD SERVICE LINES EXIST IN THIS WATER SYSTEM'S DISTRIBUTION SYSTEM, AS REQUIRED BY ORC 6109.121(F):

LEAD SERVICE LINE VERIFICATION	
This PWS states they have no lead service lines and has reviewed the following information (select one or more of the following):	
<input type="checkbox"/>	Historical permit records and/or local ordinances
<input type="checkbox"/>	Distribution maintenance records (i.e. meter replacement, waterline break repairs)
<input type="checkbox"/>	Information pertaining to installation dates for all service lines (i.e. after 1986 when lead services lines were banned)
<input checked="" type="checkbox"/>	Service line material of all service lines is known (i.e. all service lines are known to be PVC)

James R. Hemrick 4/20/17
Signature of Responsible Person Date

JAMES R. HERRICK
Printed Name and Title of Responsible Person


PWS NAME: COUNTRY ACRES GOLF CLUB
PWS ID: OH 6901412
COUNTY: PUTNAM

For Ohio EPA use only:
Date Verification Rec'd: _____



COUNTY ROAD J

ISOLATION VALVE

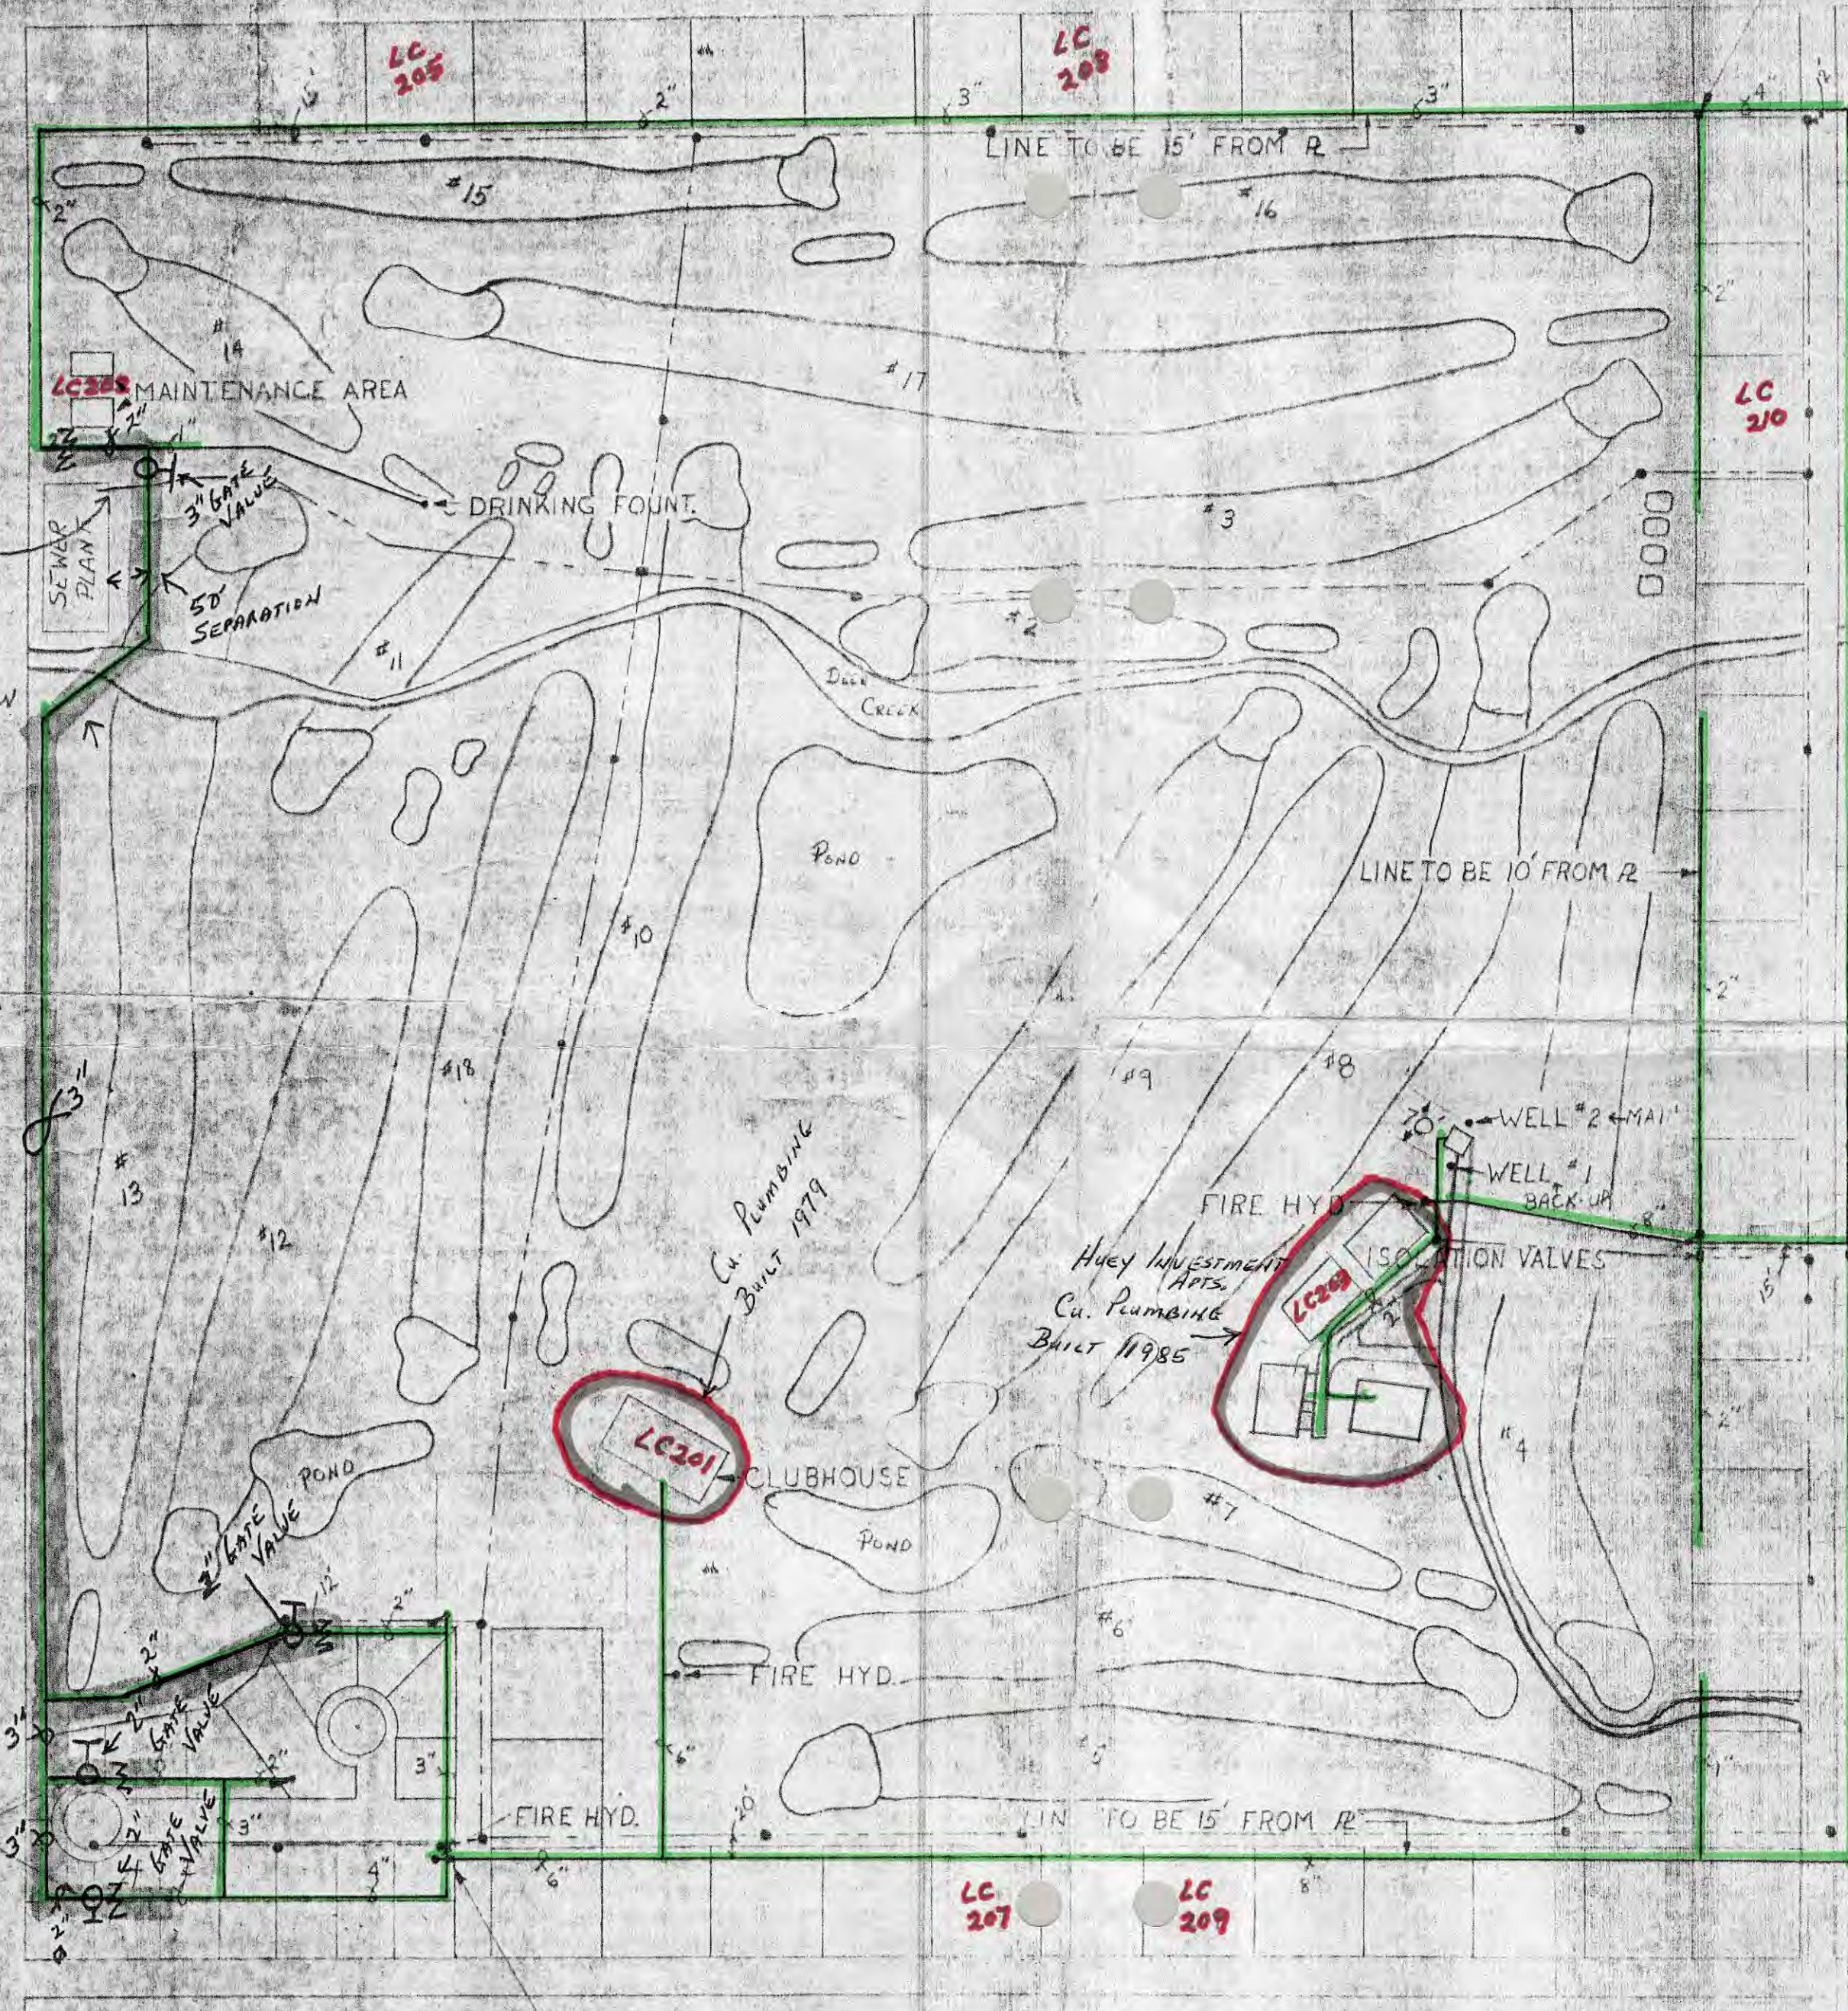

Proposed
 Addition

ALL SERVICE CONNECTIONS TO BE
 MADE WITH DRESSER STYLE
 Q294 QUICKTAP SYC. CONN.
 ALL LINES 4' DEEP
 MIN. 10' HORIZONTAL SEPARATION
 MAIN - SEWER
 MIN. 18" VERTICAL SEPARATION
 MAIN - SEWER CROSS ONLY
 ALL LINES TO BE PVC 5011 &
 NSF PW ASTM D-2241
 PRESSURE MAINTAINED

WATER SUPPLY
APPROVED
 OHIO ENVIRONMENTAL PROTECTION AGENCY
 AS EVIDENCED BY COPY OF
 LETTER OF APPROVAL
 HERETO ATTACHED

SCALE - 1" = 200'

ISOLATION VALVE

STATE ROUTE No. 694

RECEIVED
 FEB 15 2017
 OHIO E.P.A.
 N.W.D.O.

No-4981ws
 Amount \$ 112.00 Date 3/14/02
 Check # 2286 Date 3/12/02

RECEIVED
 MAR 14 2002
 OHIO E.P.A.
 N.W.D.O.