

RE: Old Fort High School  
Report  
Lead Mapping  
Drinking Water Program  
Seneca County  
PWS ID: OH7445212

Pb/Cu  
LOCATIONS

X well

RECEIVED


MAY 02 2017

DDAGW - NWDO

Old Fort High School

First Floor

OH 7445212

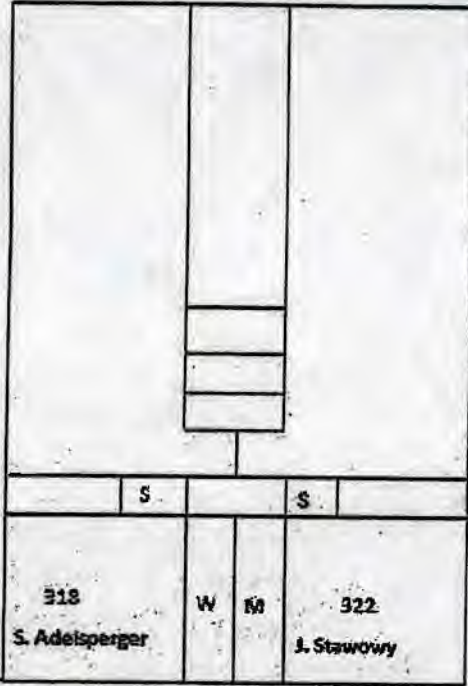


E. Wise - Transportation

Service Line  
Stack




J. Bilger - Maintenance

LC205

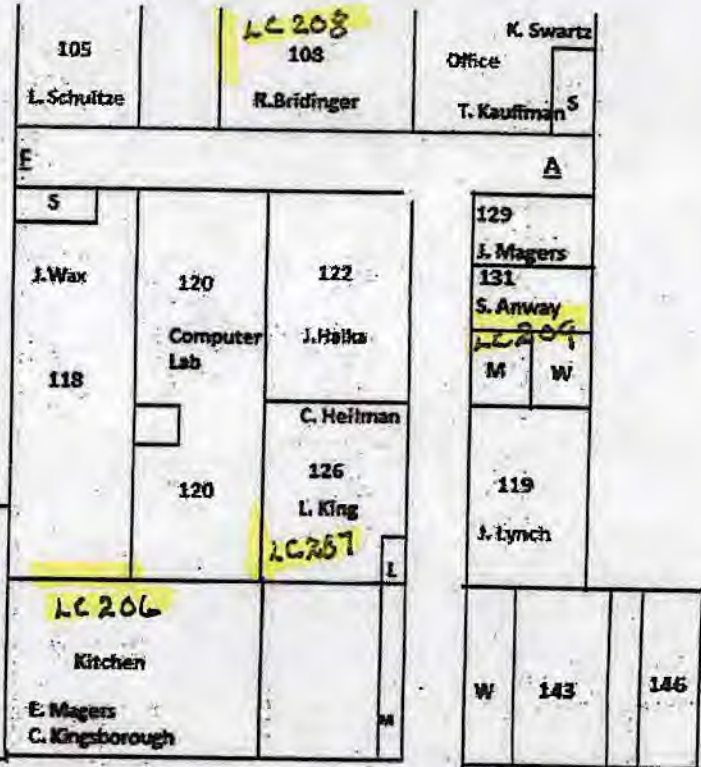


- Key
- Bold Letter = Exit
  - S stairway
  - L elevator
  - M men's restroom
  - W women's restroom


School Built  
1978  
Inside  
Plumbing - copper

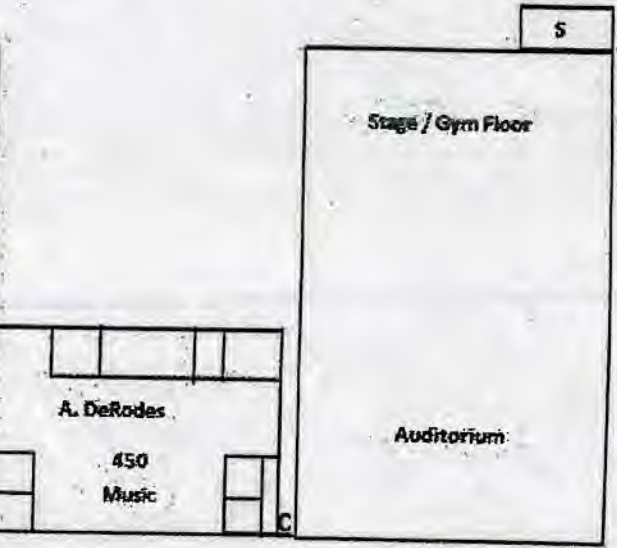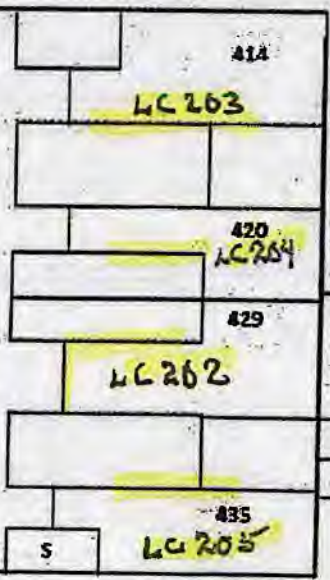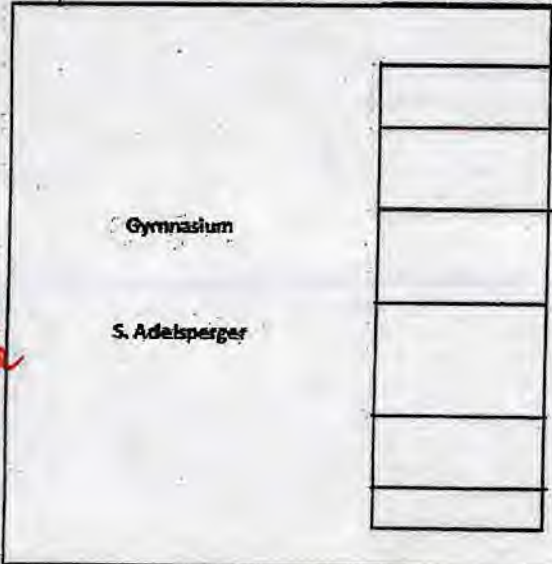

**Old Fort High School**  
**Second Floor**

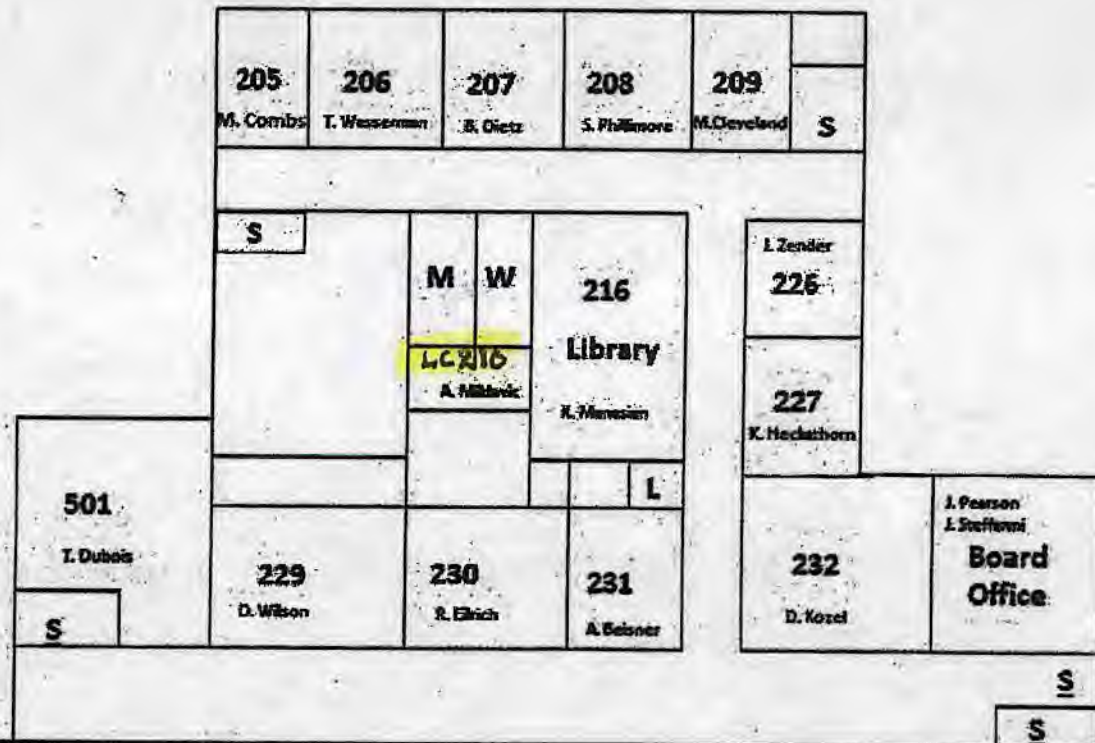

- Key
- Bold Letter = Exit
  - S stairway
  - L elevator
  - M men's restroom
  - W women's restroom

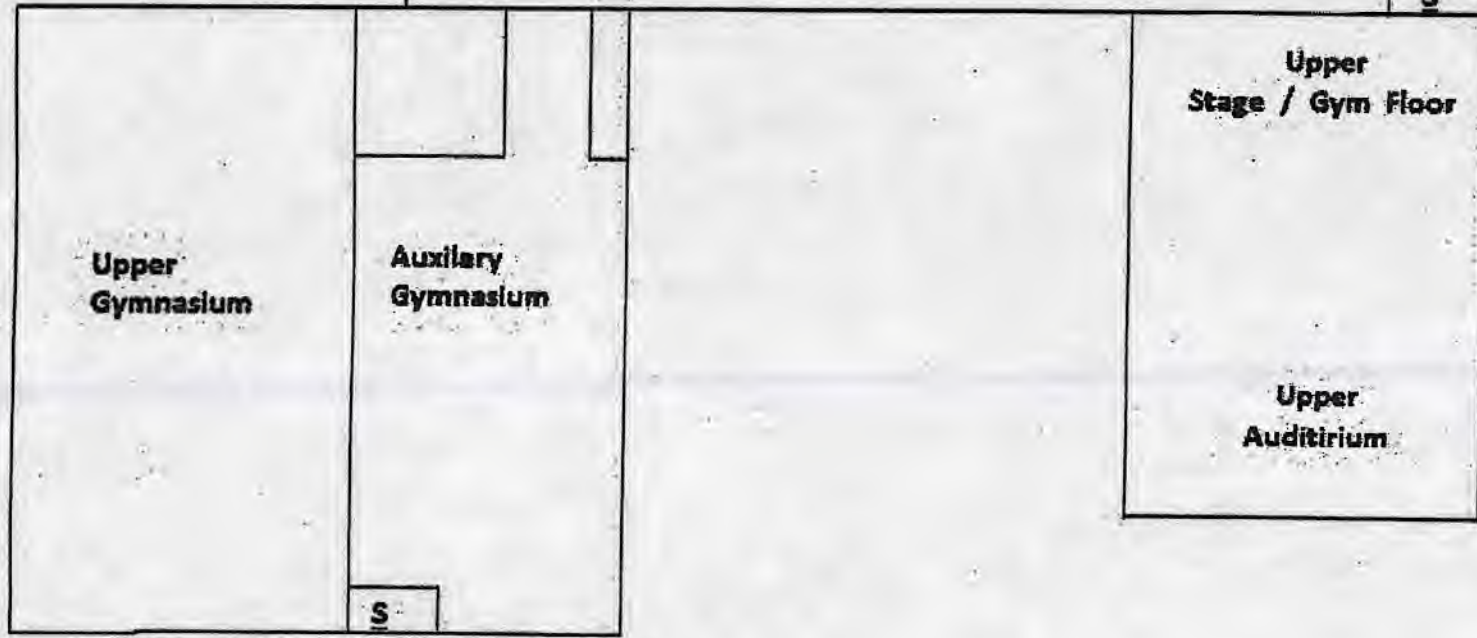


Pb/Cu Locations

X well

Old Fort High School


First Floor

OH 7445212

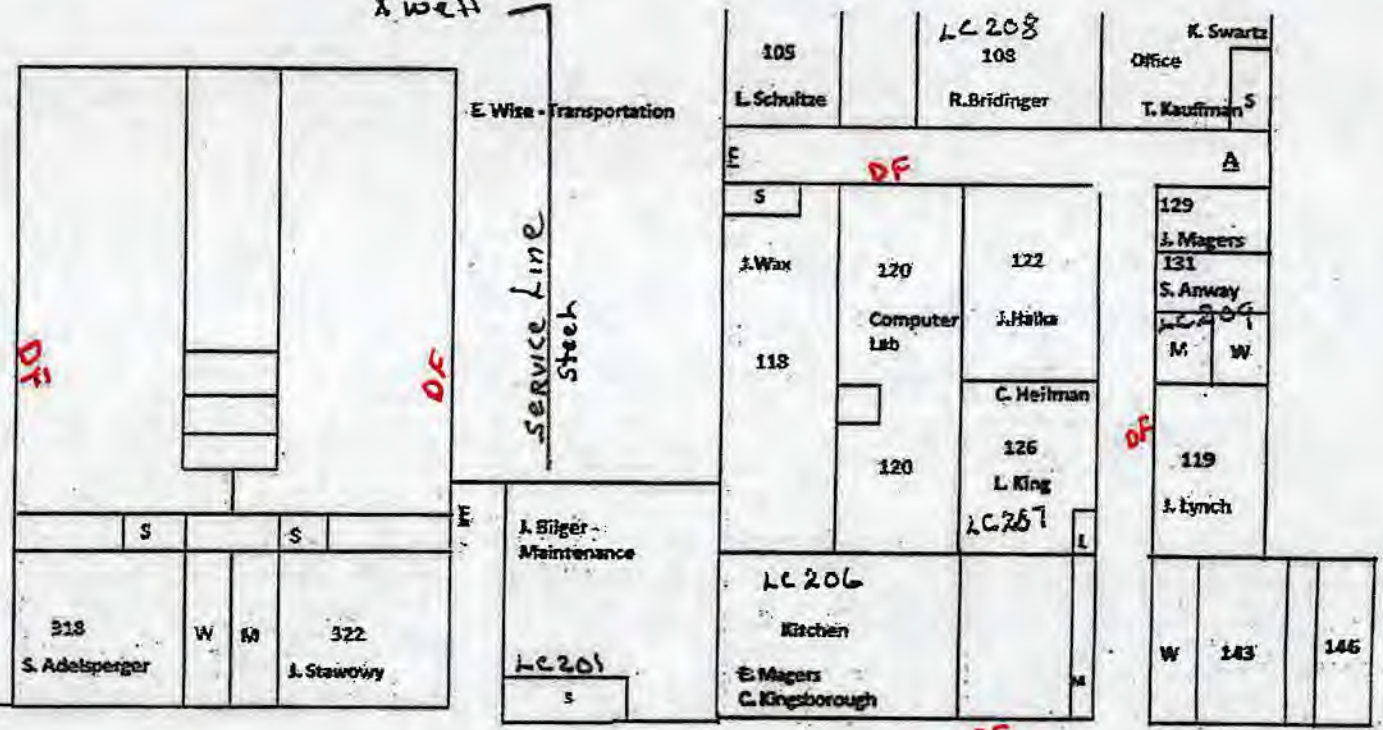

- Key
- Bold Letters = Exit
  - S stairway
  - L elevator
  - M men's restroom
  - W women's restroom

School Built 1978  
 Inside Plumbing - copper

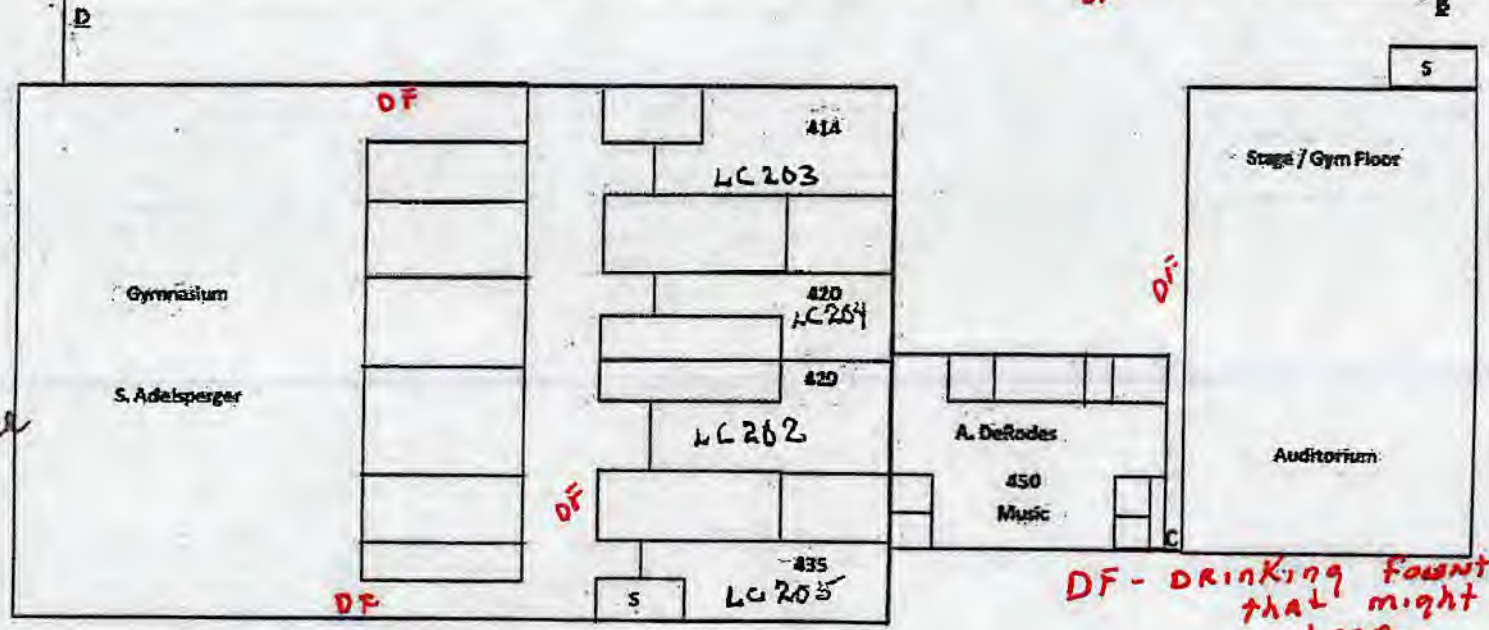

DF - DRINKING FOUNTAIN THAT MIGHT CONTAIN LEAD.