


→ Well

Lead Mapping

March 9, 2017

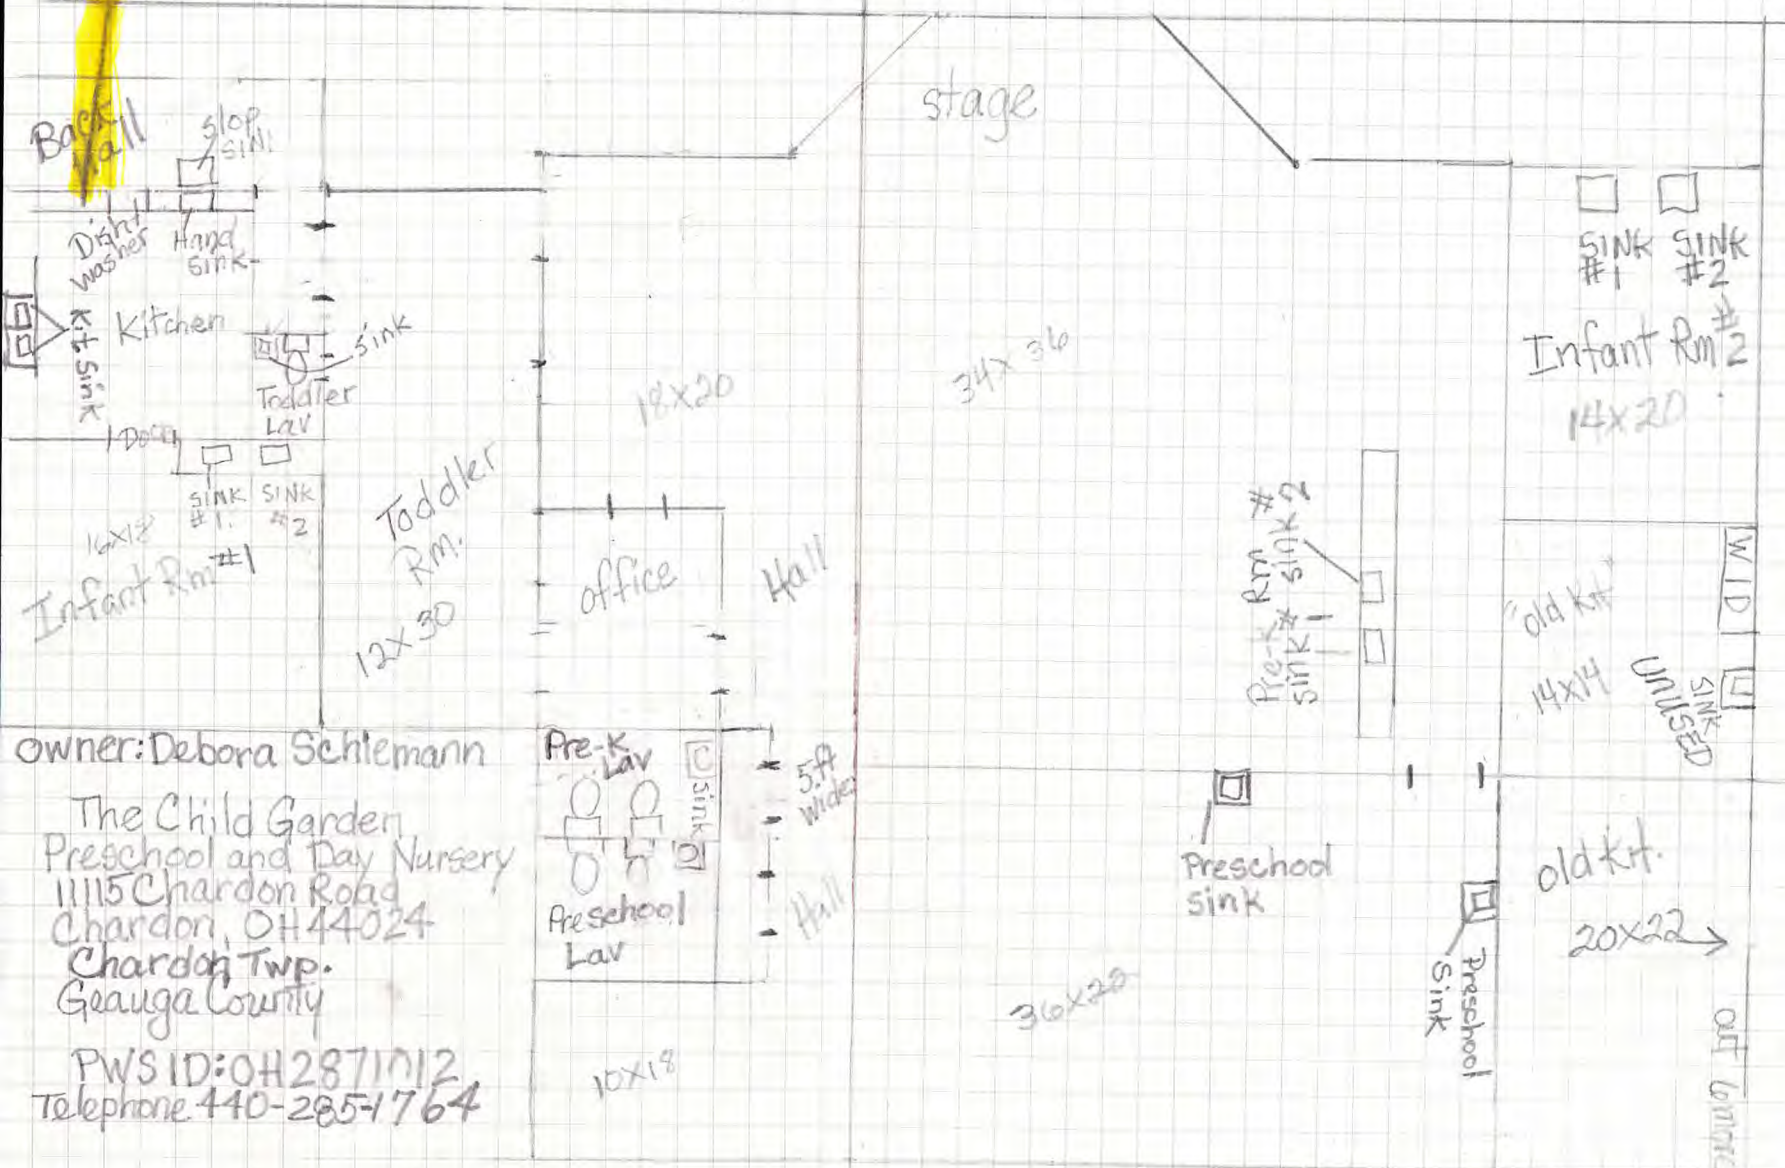

owner: Debora Schlemann
 The Child Garden
 Preschool and Day Nursery
 11115 Chardon Road
 Chardon, OH 44024
 Chardon Twp.
 Geauga County
 PWS ID: OH2871712
 Telephone: 440-285-1764

Building was built in the 1940s. We have added and replaced sinks but this was done in 2003. We assume the building contains lead in plumbing.

Lead Mapping March 9, 2017

Back
Storage Bldg.

Chardon Twp.
Geauga County

Owner: Debora Schiemann

The Child Garden Preschool and
Day Nursery

11115 Chardon Rd.
Chardon, Ohio 44024

Telephone: 440-285-1764

Child Garden
Daycare

11115 Chardon Rd.
Chardon, OH 44024

Chardon Rd. (Rt. 6)

Auburn Rd.