


Southeast Middle School

8540 Tallmadge Road
Diamond, Ohio 44412

Lead & Copper Testing Sites

PWSID: OH6784912

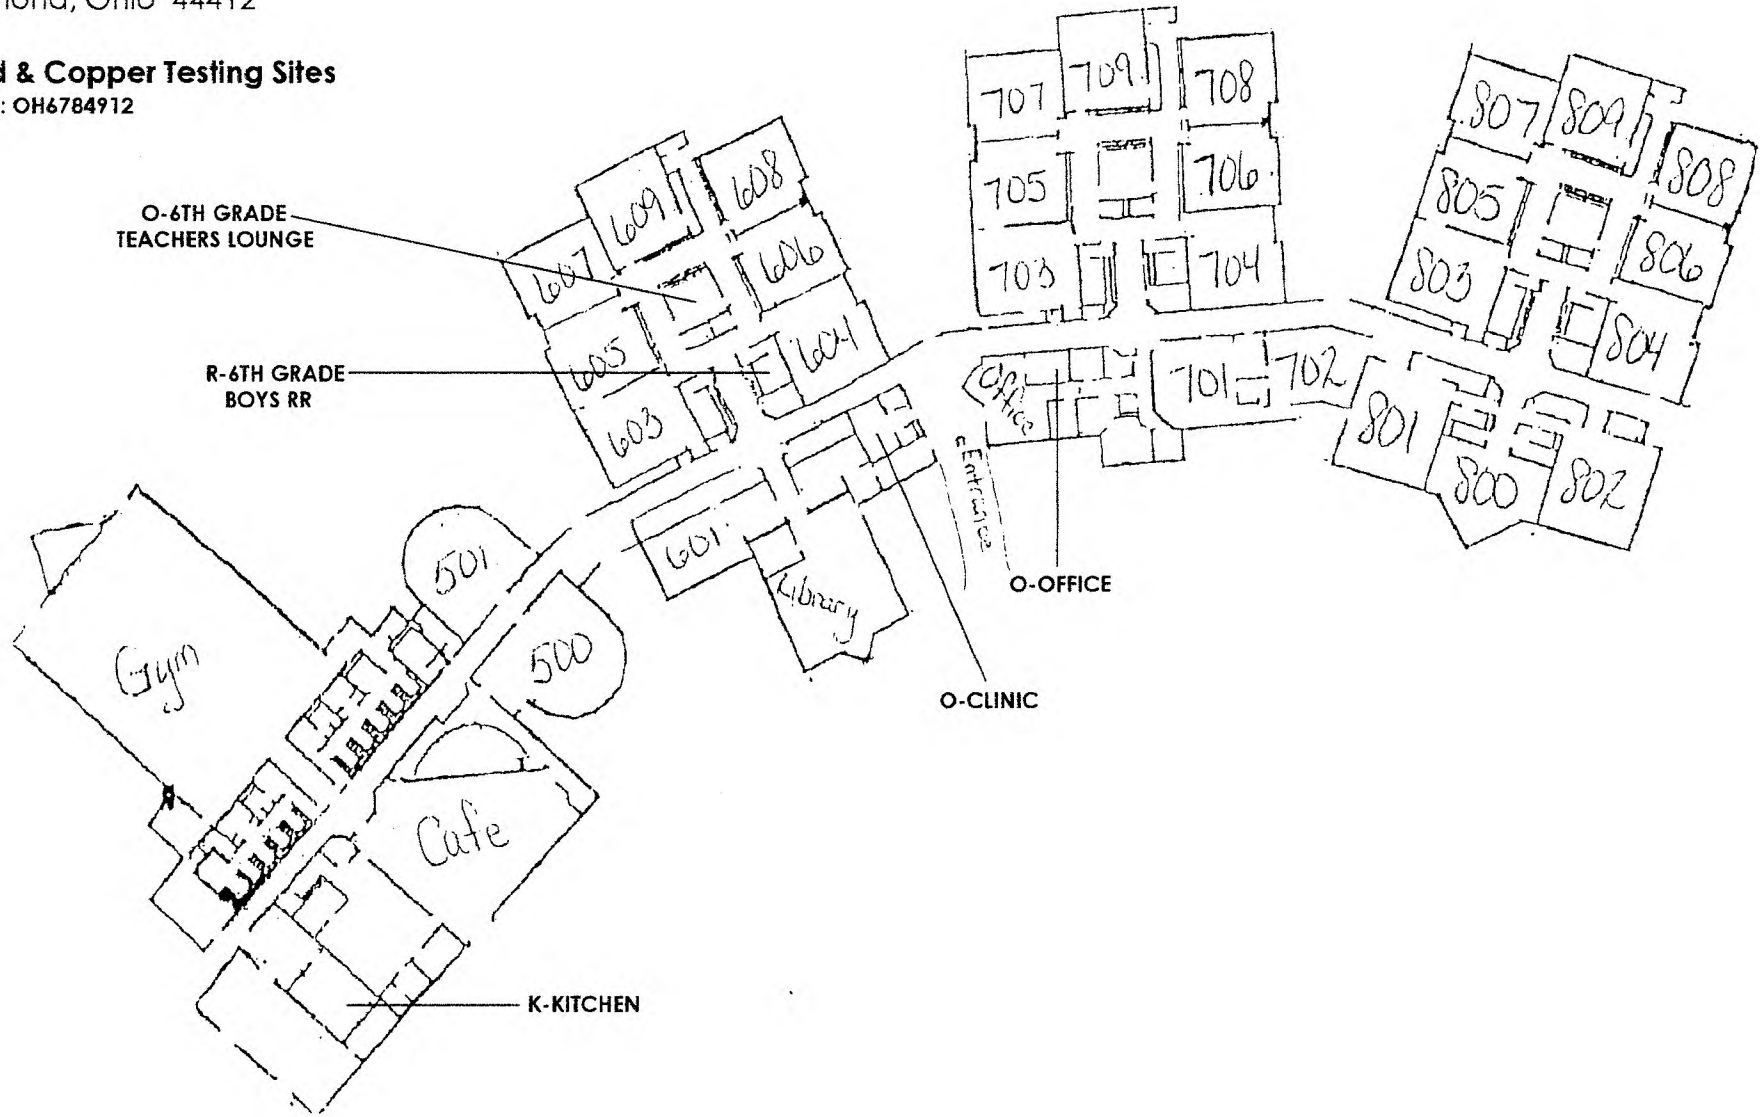

TAP TYPE CODES:
B-bathroom cold water tap
D-drinking fountain
K-kitchen sink cold water tap
R-restroom sink cold water tap
O-other