


SOUTHEAST ELEMENTARY SCHOOL

8301 TALLMADGE ROAD
RAVENNA, OHIO 44266

LEAD & COPPER TESTING SITES

PWSID: OH6753612

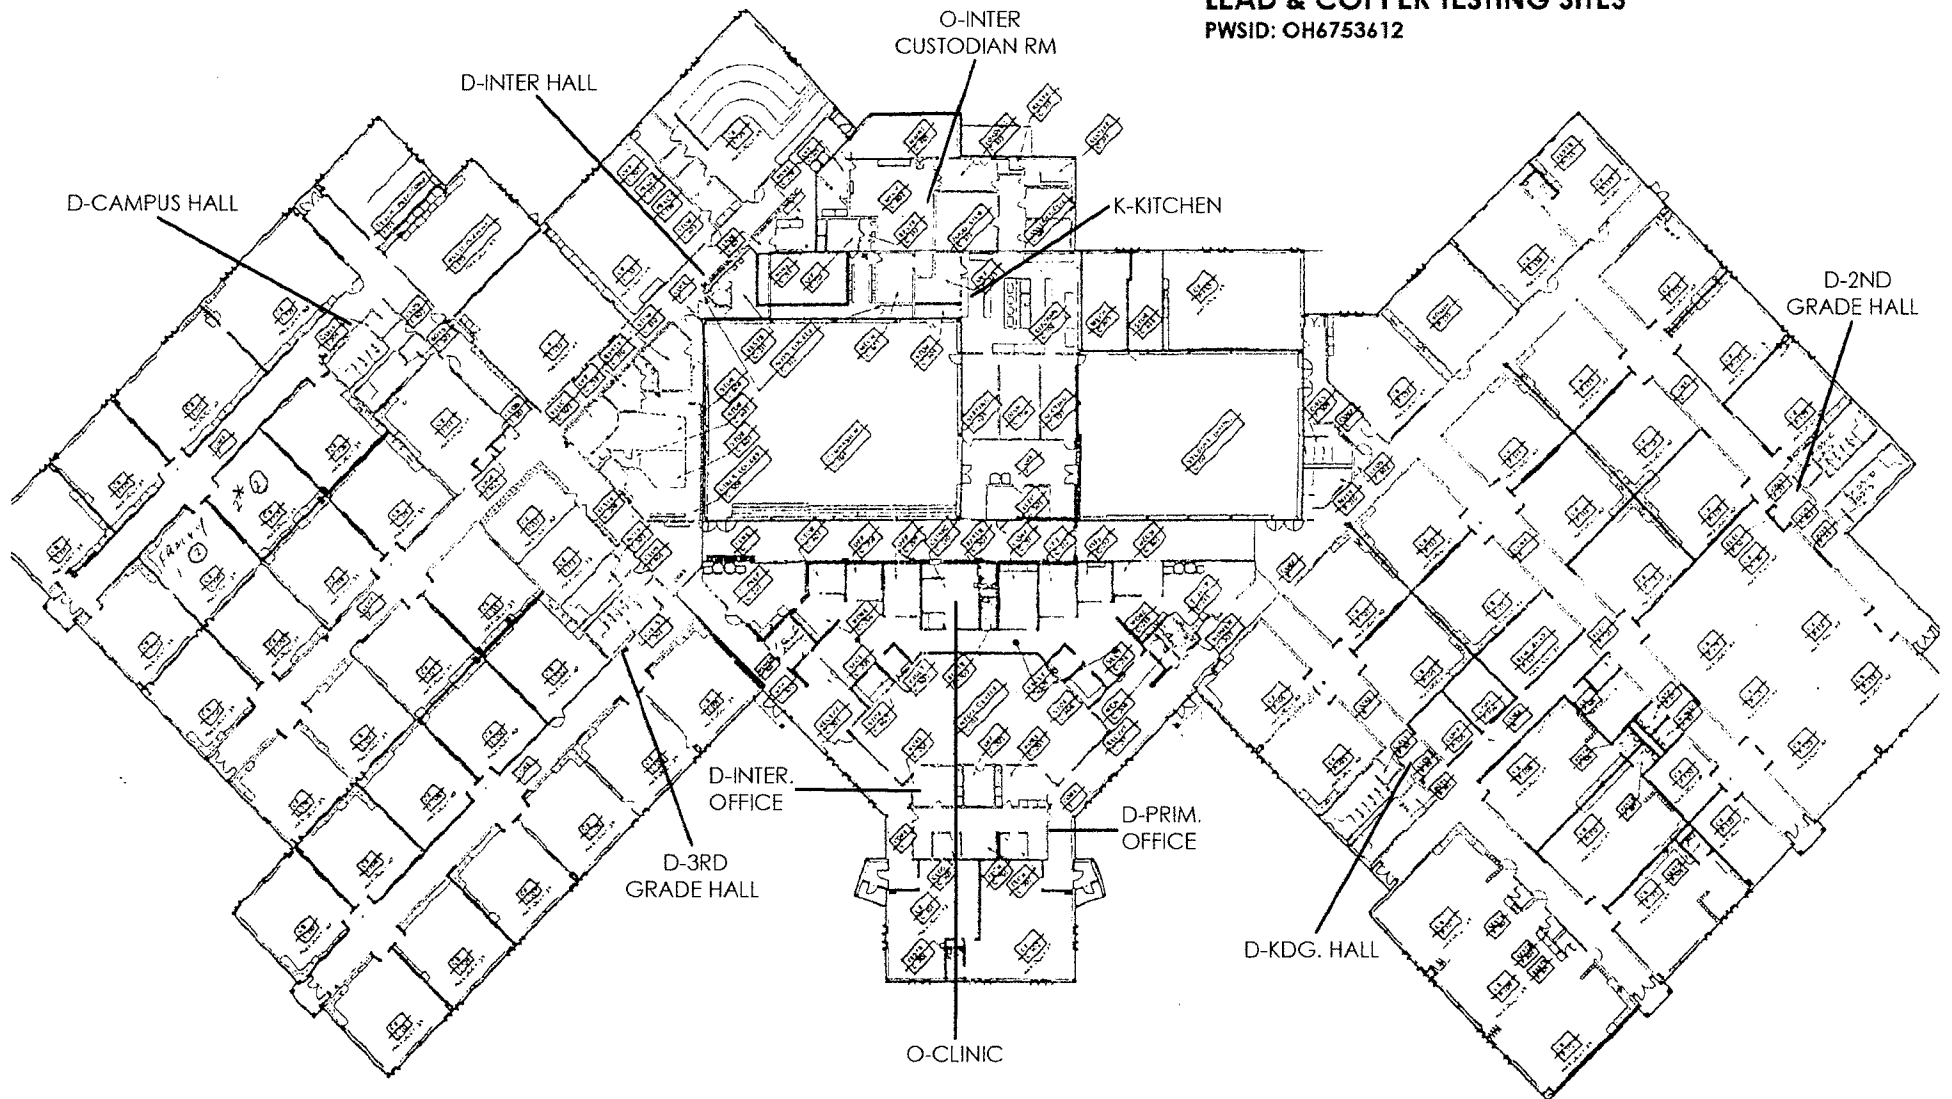

TAP TYPE CODES:

- B-bathroom cold water tap
- D-drinking fountain
- K-kitchen sink cold water tap
- R-restroom sink cold water tap
- O-other