

March 5, 2017

Ohio Department of Health – BEH@odh.ohio.gov

ATTN: Pamela L. Korenewych

RE: Ivystone Water Systems PWS 1501212

Jeff L. Dudley – Certification# LA1-1046679-04

Email: tonijeffdudley@aol.com

To Whom It May Concern:

Ivystone Water Systems is located in Columbiana County, Knox Township and is a community well system that serves 13 residential homes. The small well building was built in the early 1960's and is plumbed using 2" PVC pipes and the well casing is also an 8" PVC pipe.

All but two of the residential homes were built in the early 1960's and are plumbed in copper piping. I assume the solder used in these homes had lead content. The other two residential homes (Lots 1 & 2 and Lots 10 & 17) are both lead free and were built 1989 or after.

To the best of my knowledge, the Ivystone Water System plumbing to the individual residential taps is lead-free.

Samples are taken from the following residential homes:

1. Entry point 001 – Lot 19
2. Distribution system – Lot 10 (DS 001)
3. Distribution system – Lot 8 (DS 002)
4. Distribution system – Lot 23 (DS 003)
5. Distribution system – Lot 4 (DS 004)


I have been a resident of this community since April, 1989 and have been maintaining the well system since that time. I take pride in our well system and do my very best maintaining our well supply for our community.

If you have any questions, please do not hesitate to contact me at 330-238-0543 or tonijeffdudley@aol.com.


Thank you,

Jeff L. Dudley, 4020 S. Mahoning Avenue, Alliance, Ohio

Mahoning Ave North →

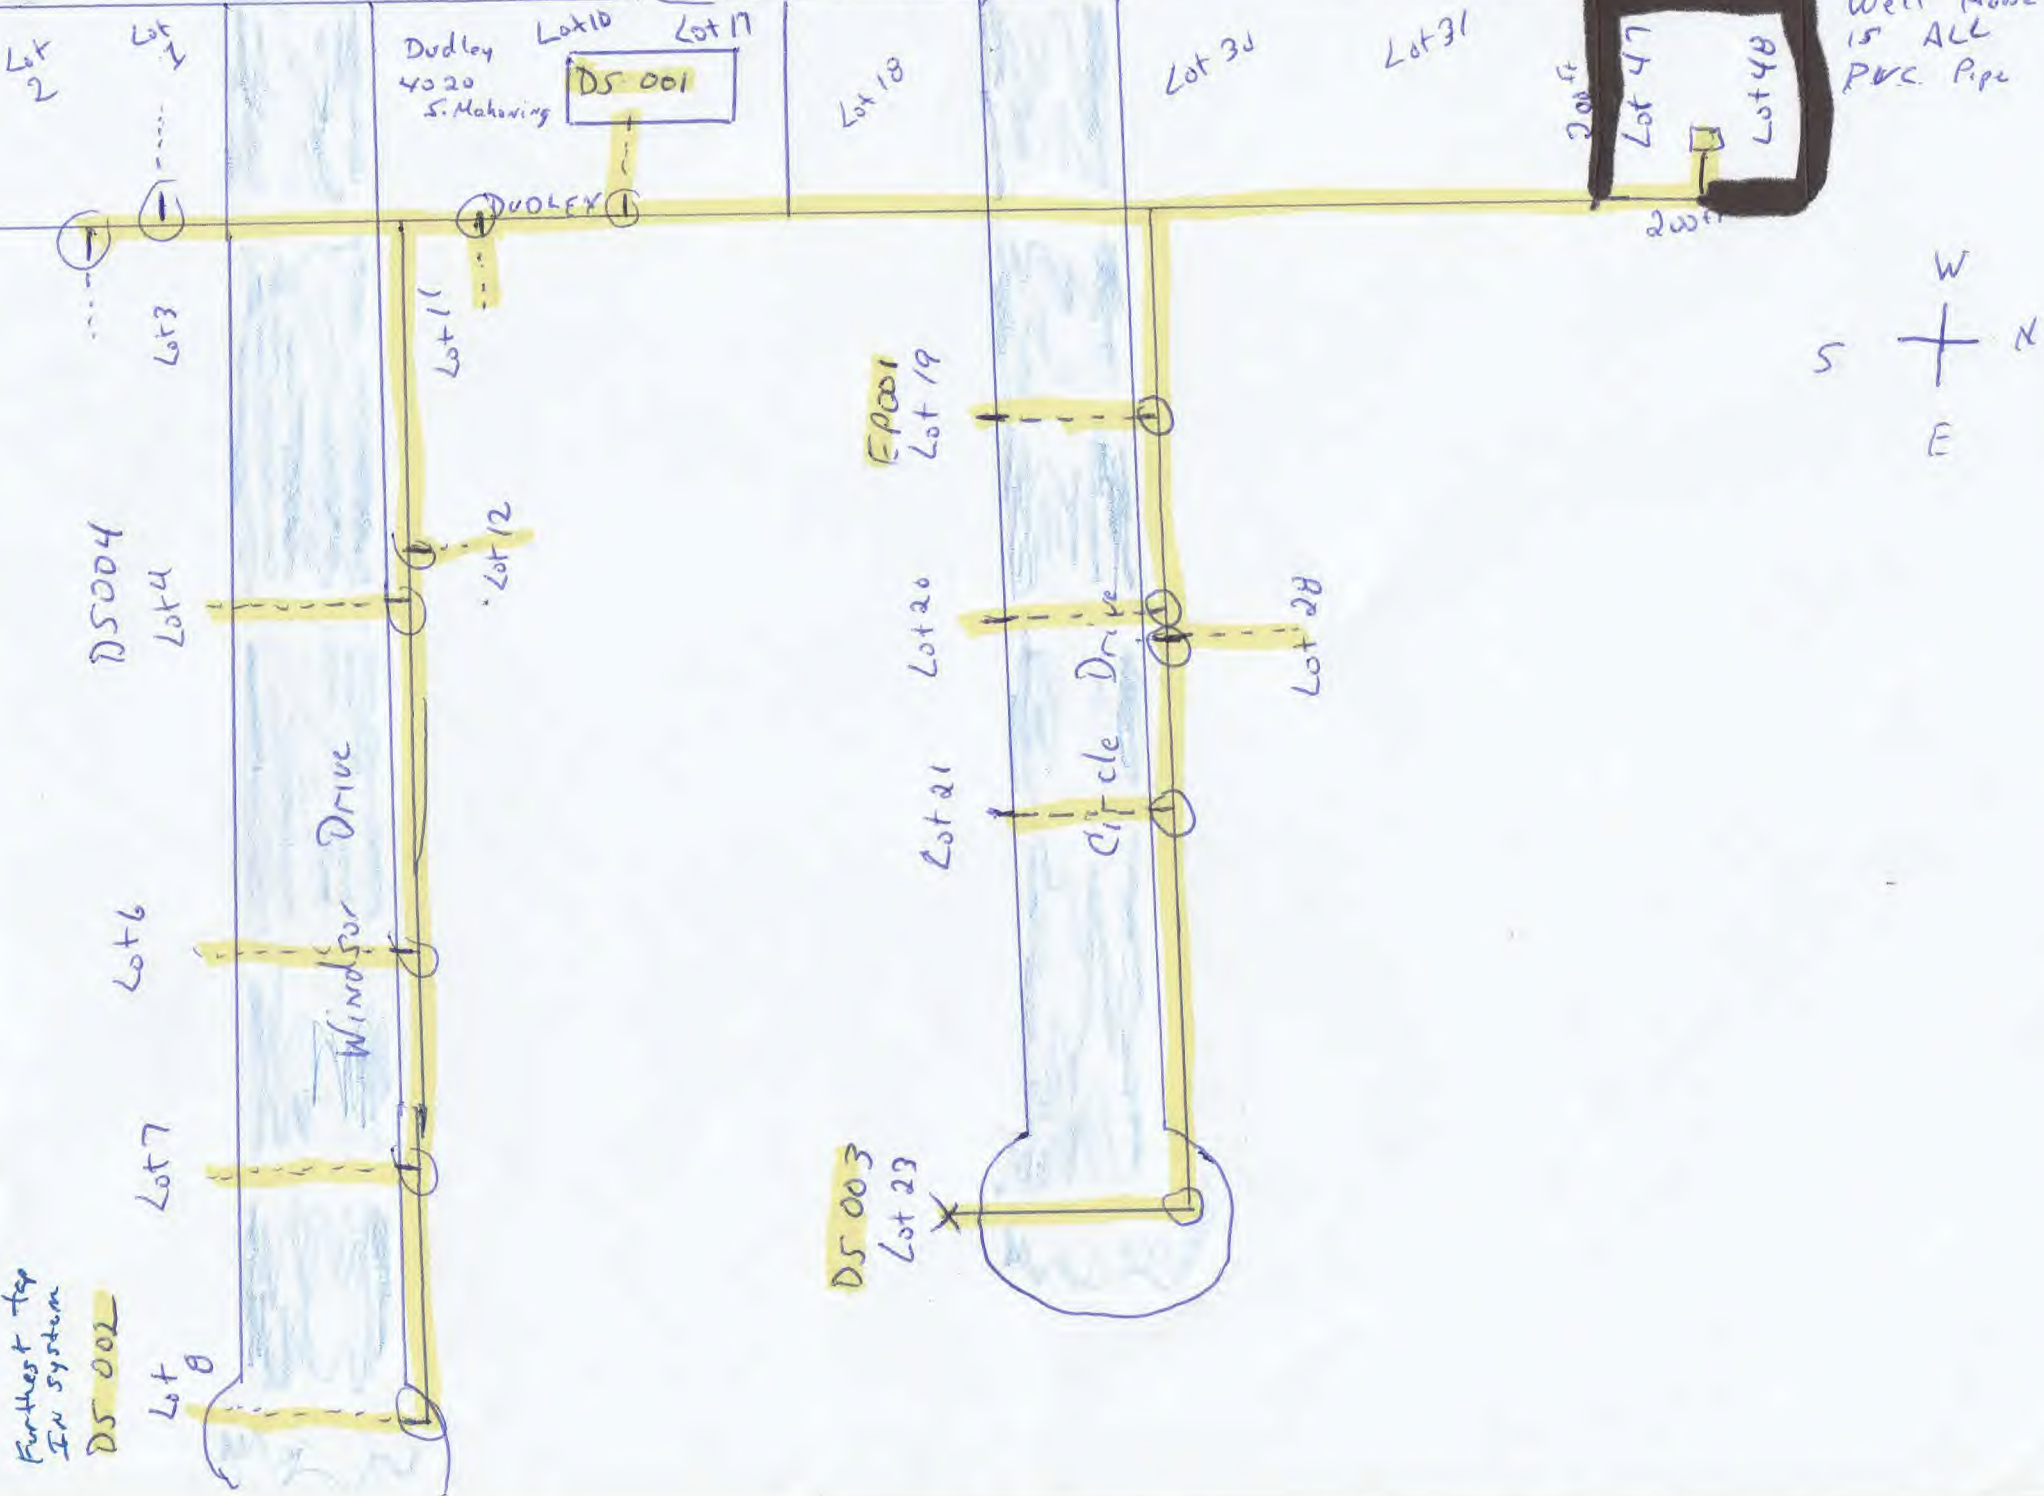

Furthest top IN system DS 002

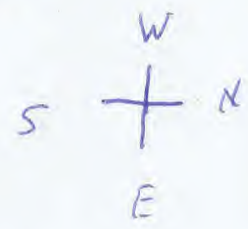

Well House 15 ALL PVC Pipe

Dudley 40 20 S. Mahoning DS 001

DS 003 Lot 23

EP001 Lot 19

DS 004 Lot 4

Windsor Drive

Circle Drive

Lot 47

Lot 48

Lot 30

North →

Lot 2

Lot 1

Lot 3

Lot 11

Lot 12

Lot 6

Lot 7

Lot 8

Lot 20

Lot 21

Lot 28

Lot 18

Lot 30

200ft

200ft

W

S

E

N