

5/30/17

DEAR SIR:

I bought Louisville M/H/P 1/1/83.

TO MY KNOWLEDGE, NO INTERIOR
LINES OF MOBILE HOMES OR
BUILDINGS HAVE LEAD, SOLDERED
COPPER WATER LINES

Phil Brul

Nick Brod, owner

LEAD MAPPING PROGRAM

- LOUISVILLE M/H/P
CANTON, OHIO 44705

RECEIVED

MAR 08 2017

OH7602512

OHIO EPA NEDO

I'VE OWNED THE PARK SINCE JAN. 1983.
I NEVER HAD BLUE PRINTS AND LEARNED
THE WATER SYSTEM THRU TRIAL AND ERROR.
FROM REPAIRS, I'VE FOUND IN GROUND LINES
ARE ALL GALVANIZED IN SIZES 2", 1 1/2", 1", 3/4" & 1/2"
FIFTEEN HOMES SERVICE LINES HAVE BEEN
REPLACED BY PLASTIC, ABANDONING THE
GALVANIZED. ALL LEAD AND COPPER EPA TESTS HAVE
RESULTED IN NEGLIGIBLE AMOUNTS IN THE WATER. IN
34 YEARS I HAVE NOT FOUND ANY LEAD PIPES OR SOLDER

MAP INFORMATION

- 6 X INDICATES GALVANIZED SERVICE LINES.
- INDICATES PLASTIC SERVICE LINES.

2. Lots 5, 19, 53, 28, 33, 41, 51 contain mobile homes, but are abandoned, they are not hooked up to the service.
3. The apartment building has some galvanized lines in the basement. All 3 apartments have been converted to plastic.
4. A few mobile homes still have a combination of galvanized & copper "flared", but the vast majority have been replumbed in plastic.

This is a true and honest report.


Entity: Louisville MHP
Doc Type: Report
Doc Subtype: _____
Program: DDAGW
County: Stark
Secondary ID: OH7602512

Nick Brod, OWNER
LOUISVILLE M/H/P
4519 LOUISVILLE ST. N.E.
CANTON, OHIO 44705



330-456-293

LOUIS VALLE FENCE STREET

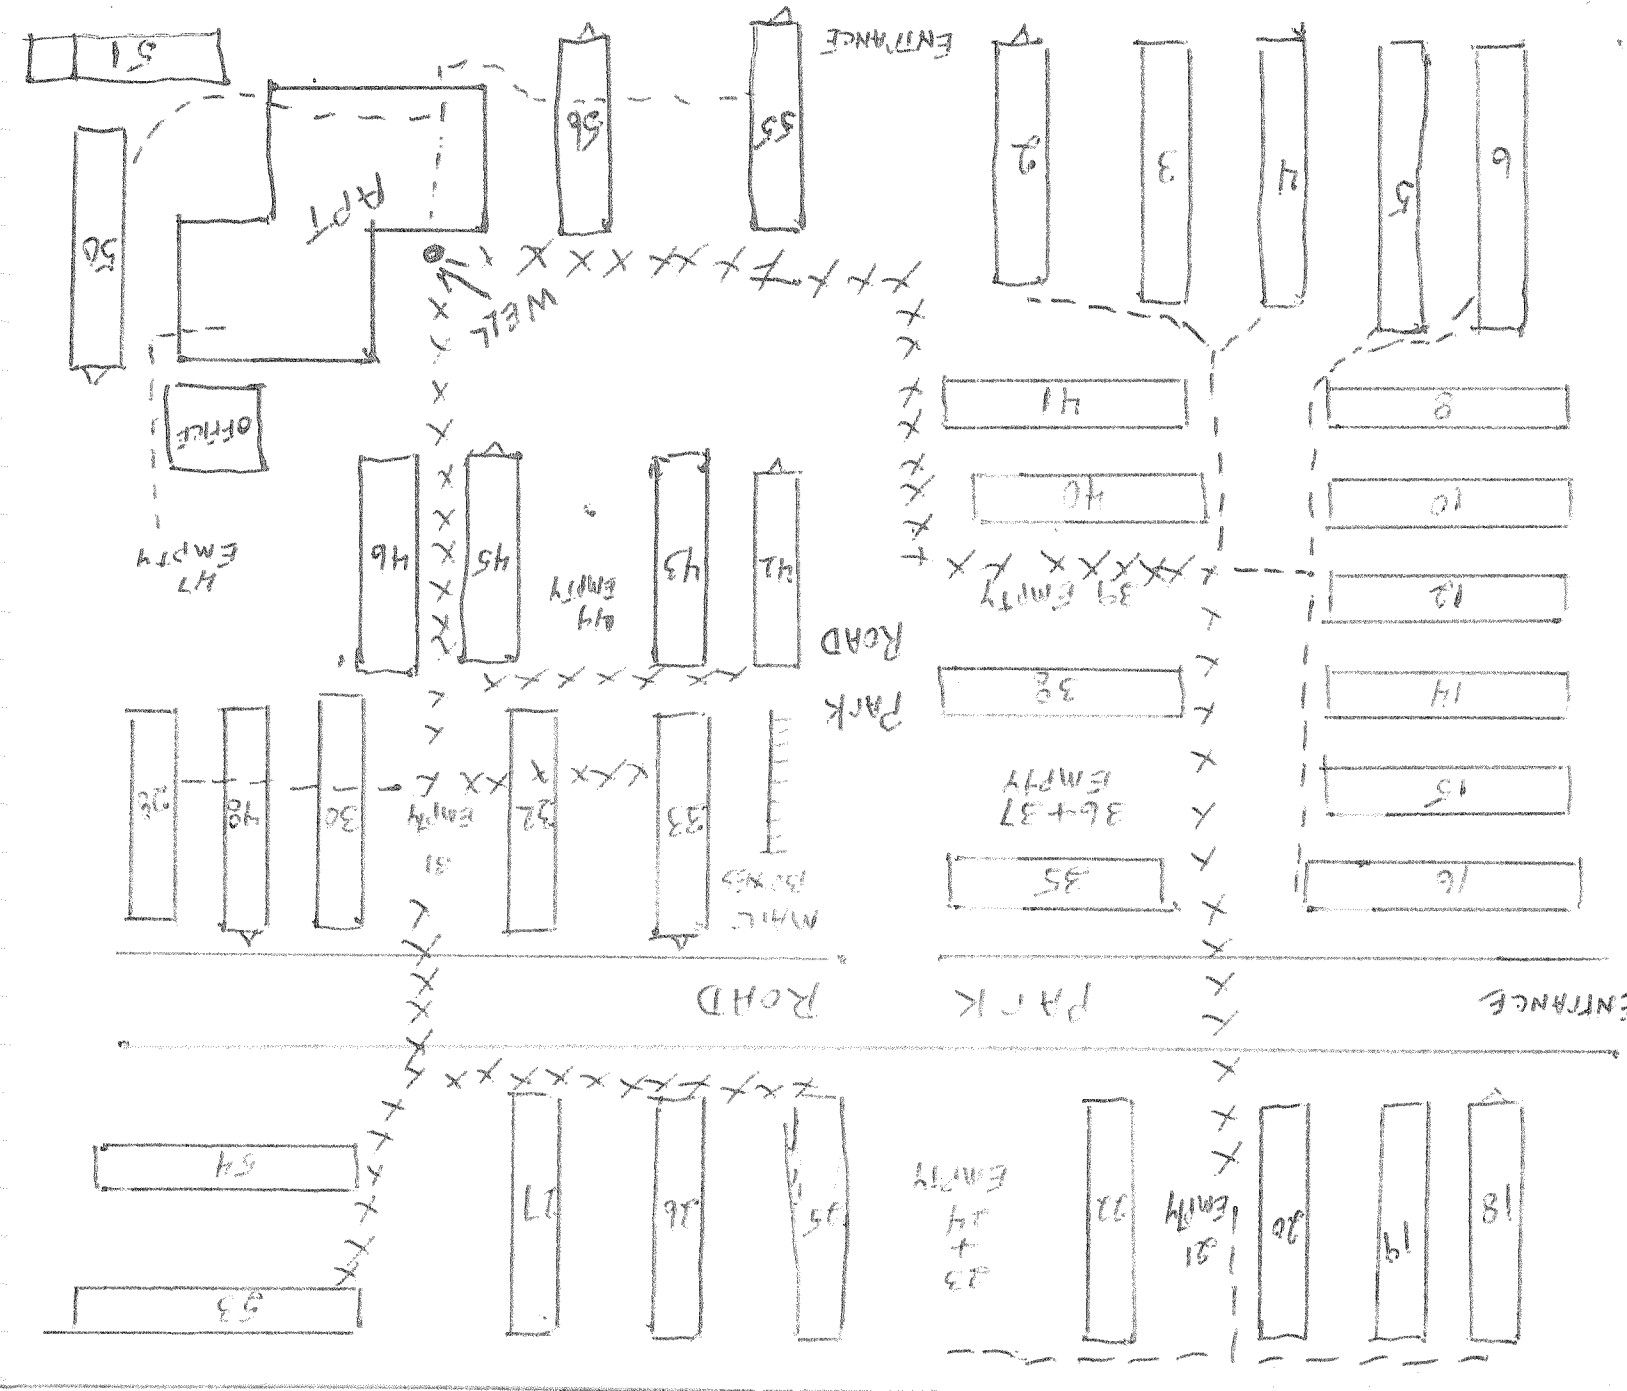

CANTON, OHIO

LOUISVILLE M/H/P

MILLVALE ST.

N

FENCE

ENTRANCE

PARK

ROAD

WHITE BORDS

PARK ROAD

EMPTY

EMPTY

EMPTY

EMPTY

RPT

WEL

ENTRANCE

ENTRANCE

PARK ROAD

FENCE

FENCE