

OH7603412

Whispering Oaks MHP

The water system at Whispering Oaks MHP was completely replaced in 2000,2001. All underground lines are plastic. Valves at every connection point are brass. The only exception is the copper pipes connecting the tanks in the pump house. No lead is in the system.

The individual mobile homes in the park are mostly plastic PVC. Some older ones still have galvanized iron pipes. The only ones using copper are using tubing with brass fittings. As far as I can determine there is no lead used anywhere in Whispering Oaks MHP.

RECEIVED  
JUN 14 2017


BY: .....

Entity: \_\_\_\_\_  
Doc Type: Report  
Doc Subtype: Lead Mapping  
Program: \_\_\_\_\_  
County: \_\_\_\_\_  
Secondary ID: OH 7603412  
add to eDOC 599466





NAVARRE ROAD

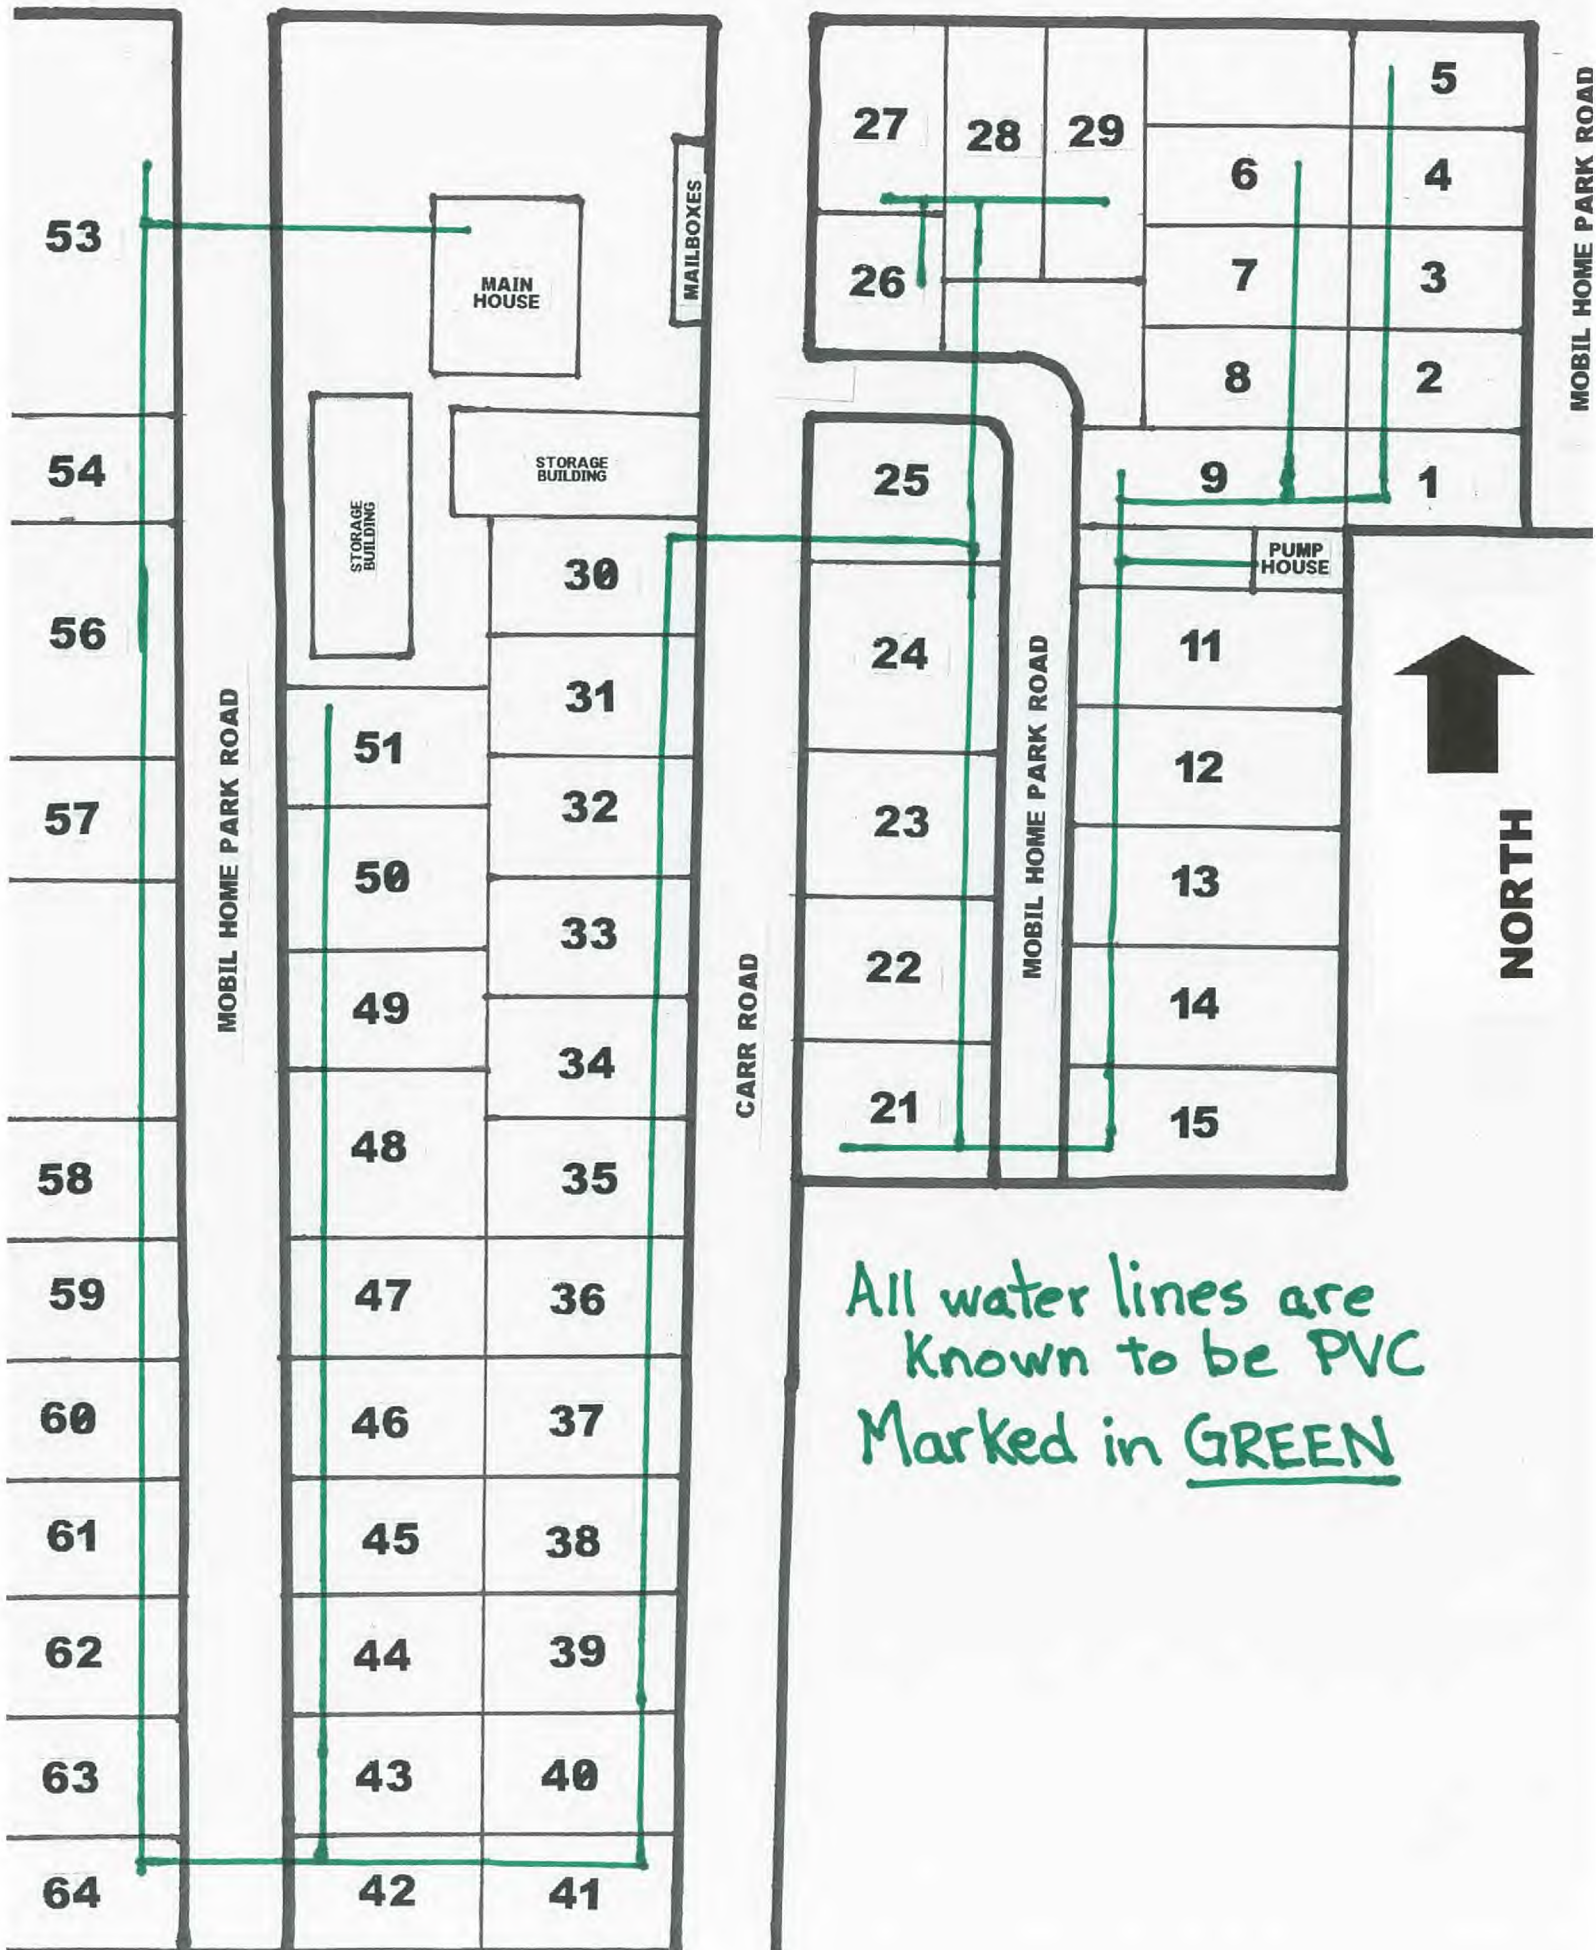

All water lines are known to be PVC Marked in GREEN