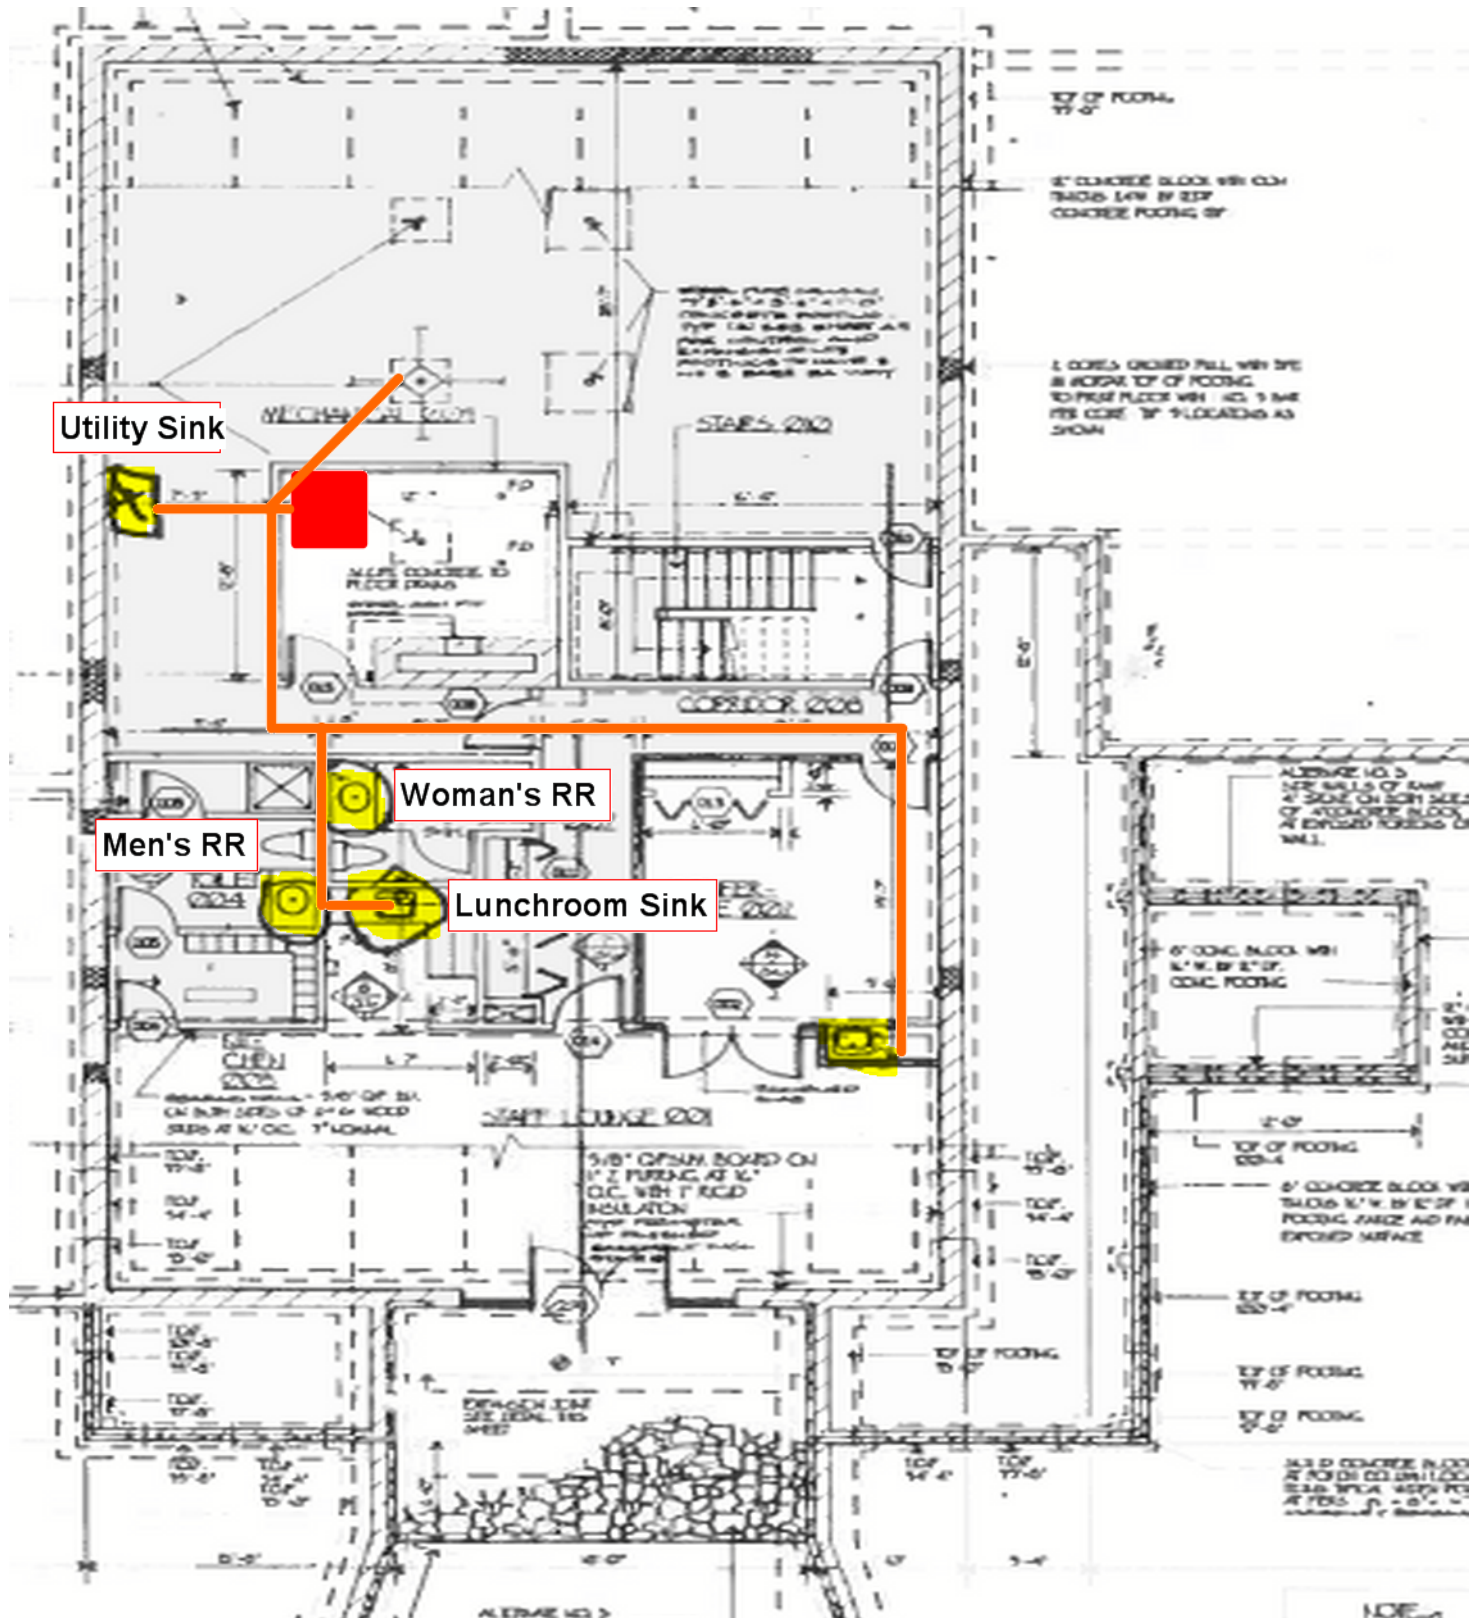

Yellow Highlights Fixtures



Ground Floor

