




Notre Dame Preschool  
PWS 0H2841112  
March 2016

N

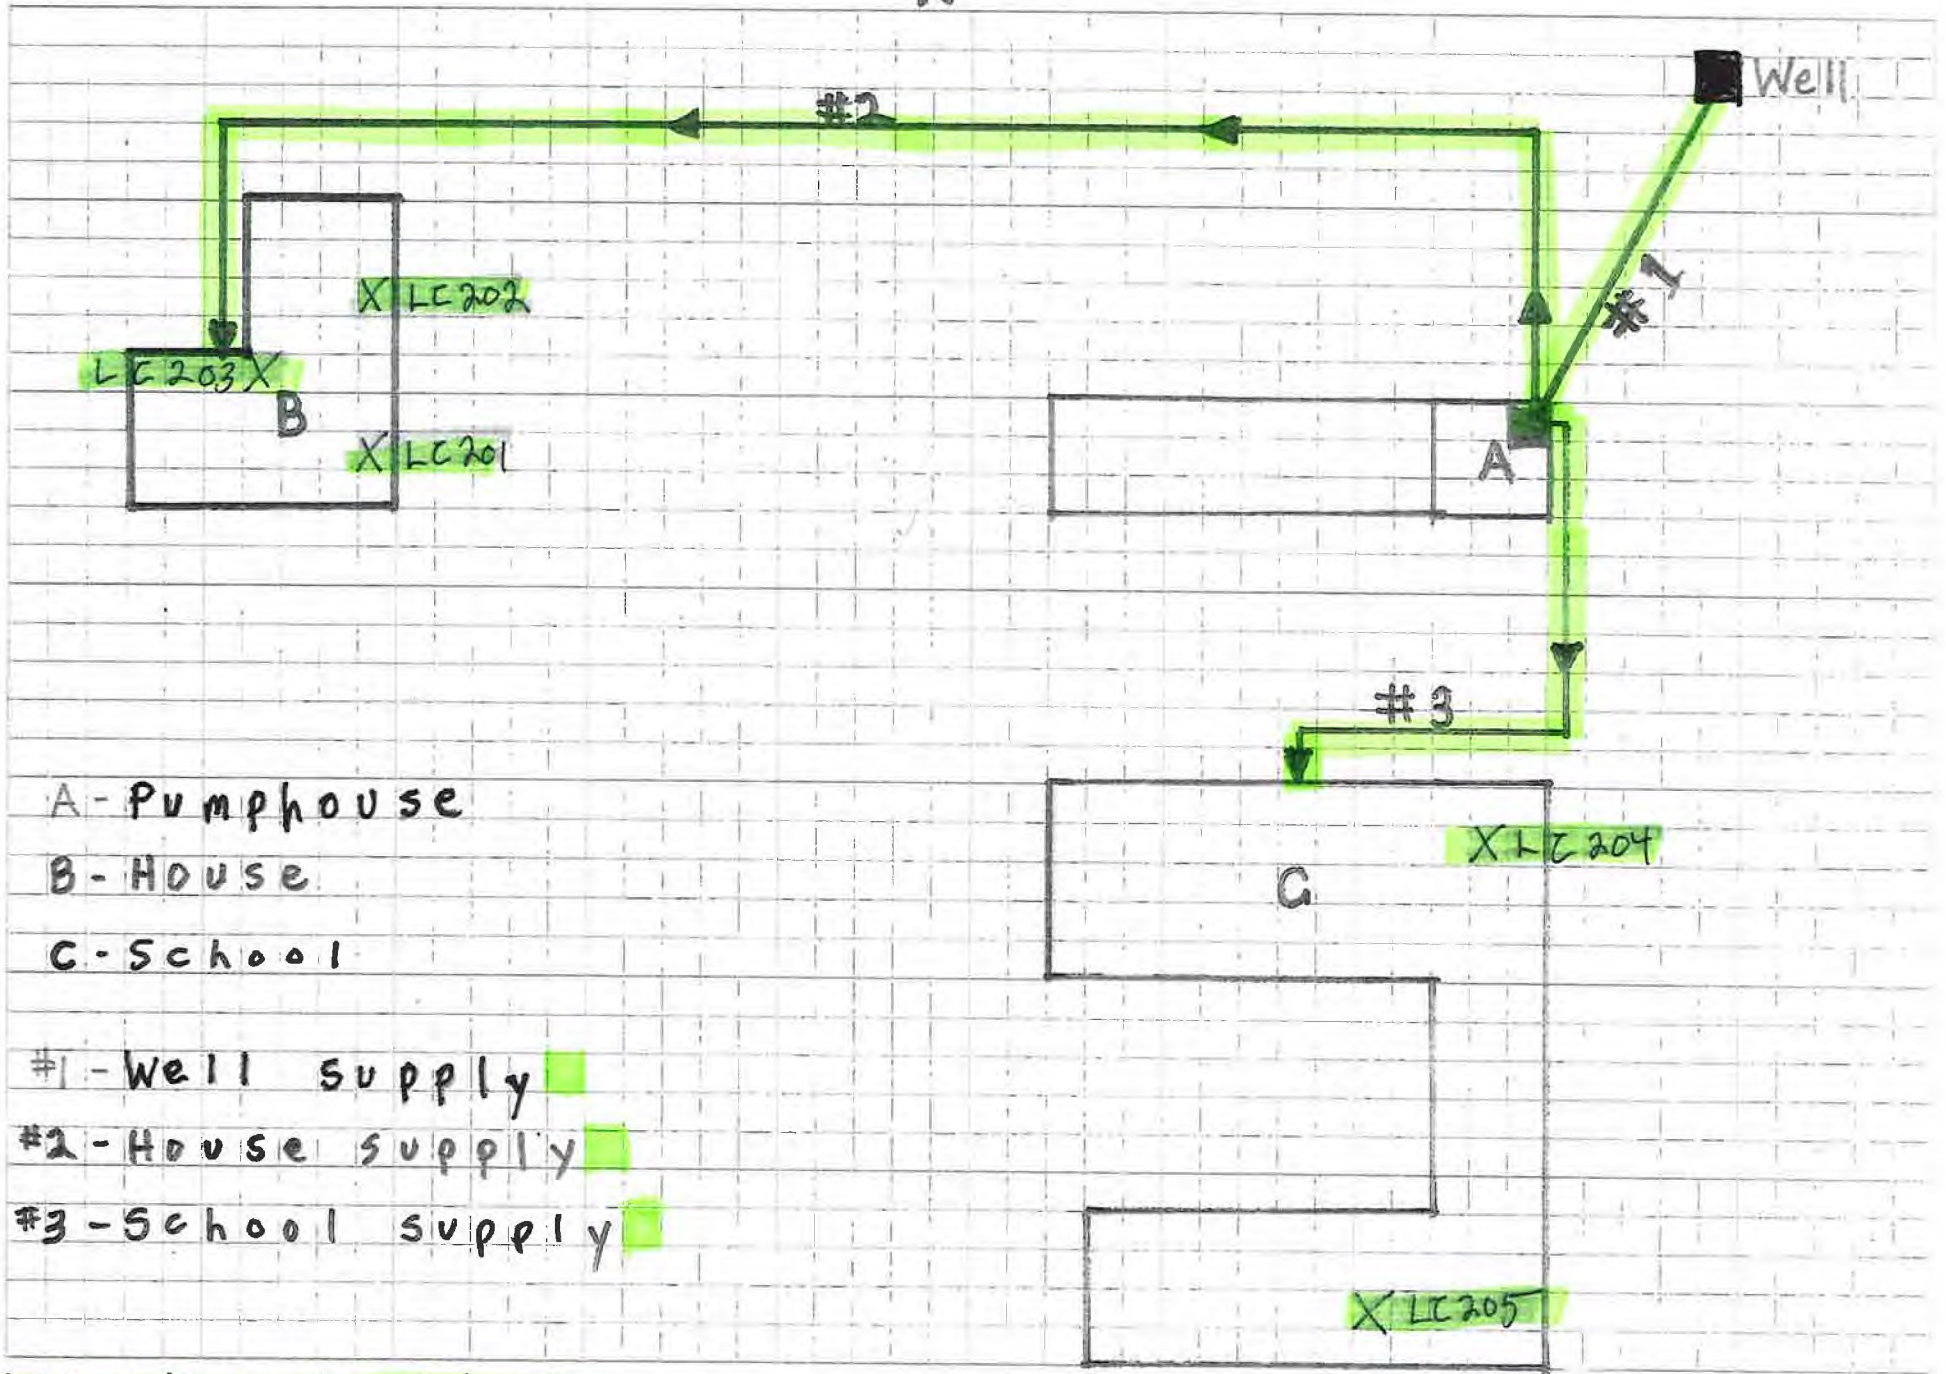

\*All water supply - sch. 80