


CHILlicoTHE RD. - CHESTER TOWN CENTER

2ND FLOOR OFFICES - ALL VACANT

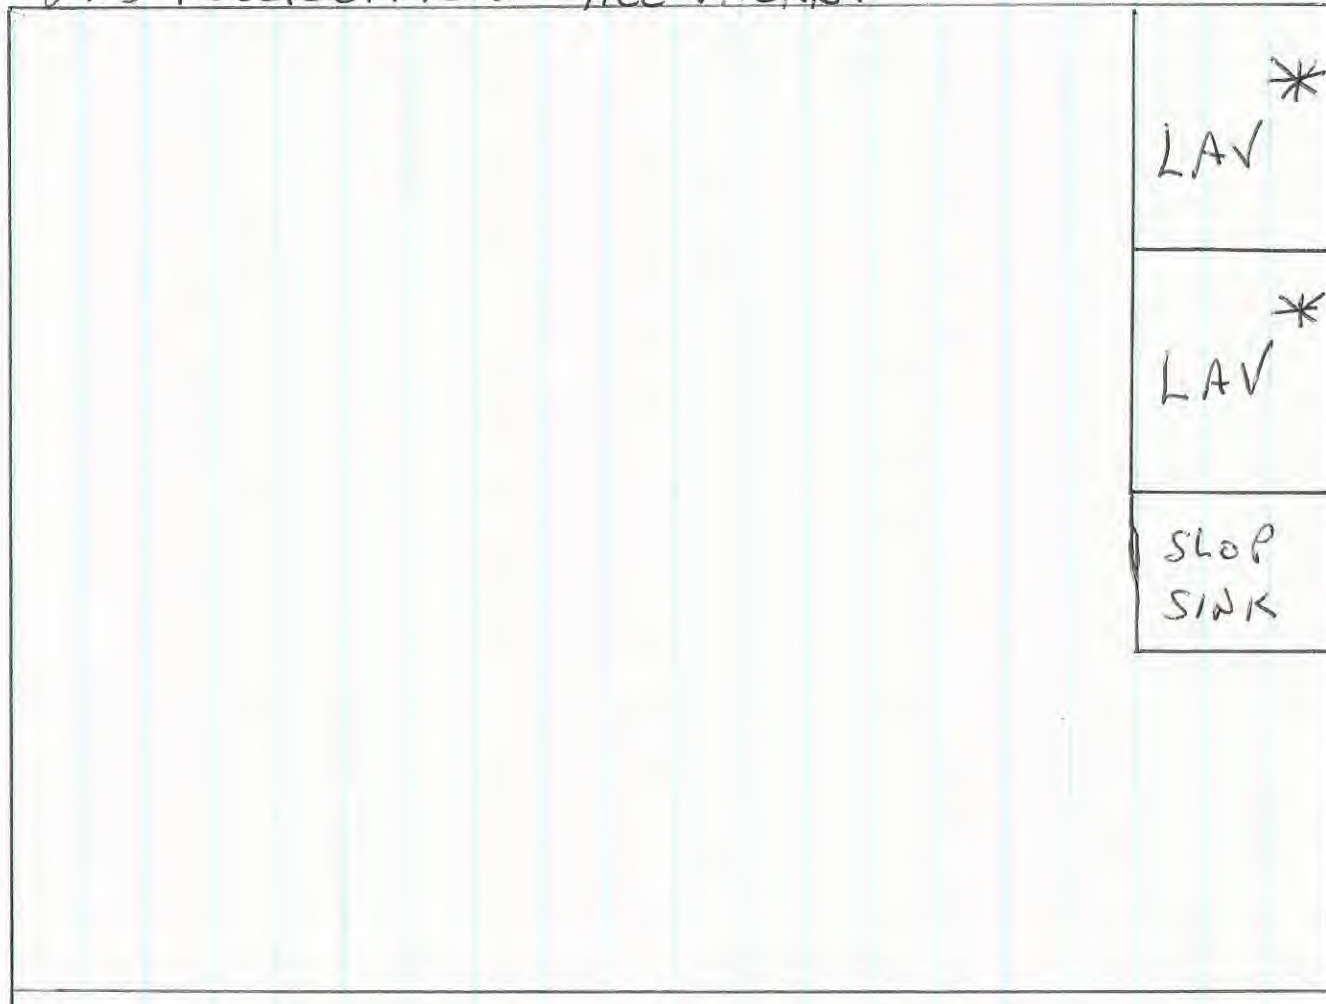

CHILLICOTHE RD. CHESTER TOWN CENTER