


PWS ID: 048560612

Lehman's Hardware
4779 Kidron Rd
Kidron, Ohio 44636

330 857 5757

3/6/2017

MEETING LOCATION

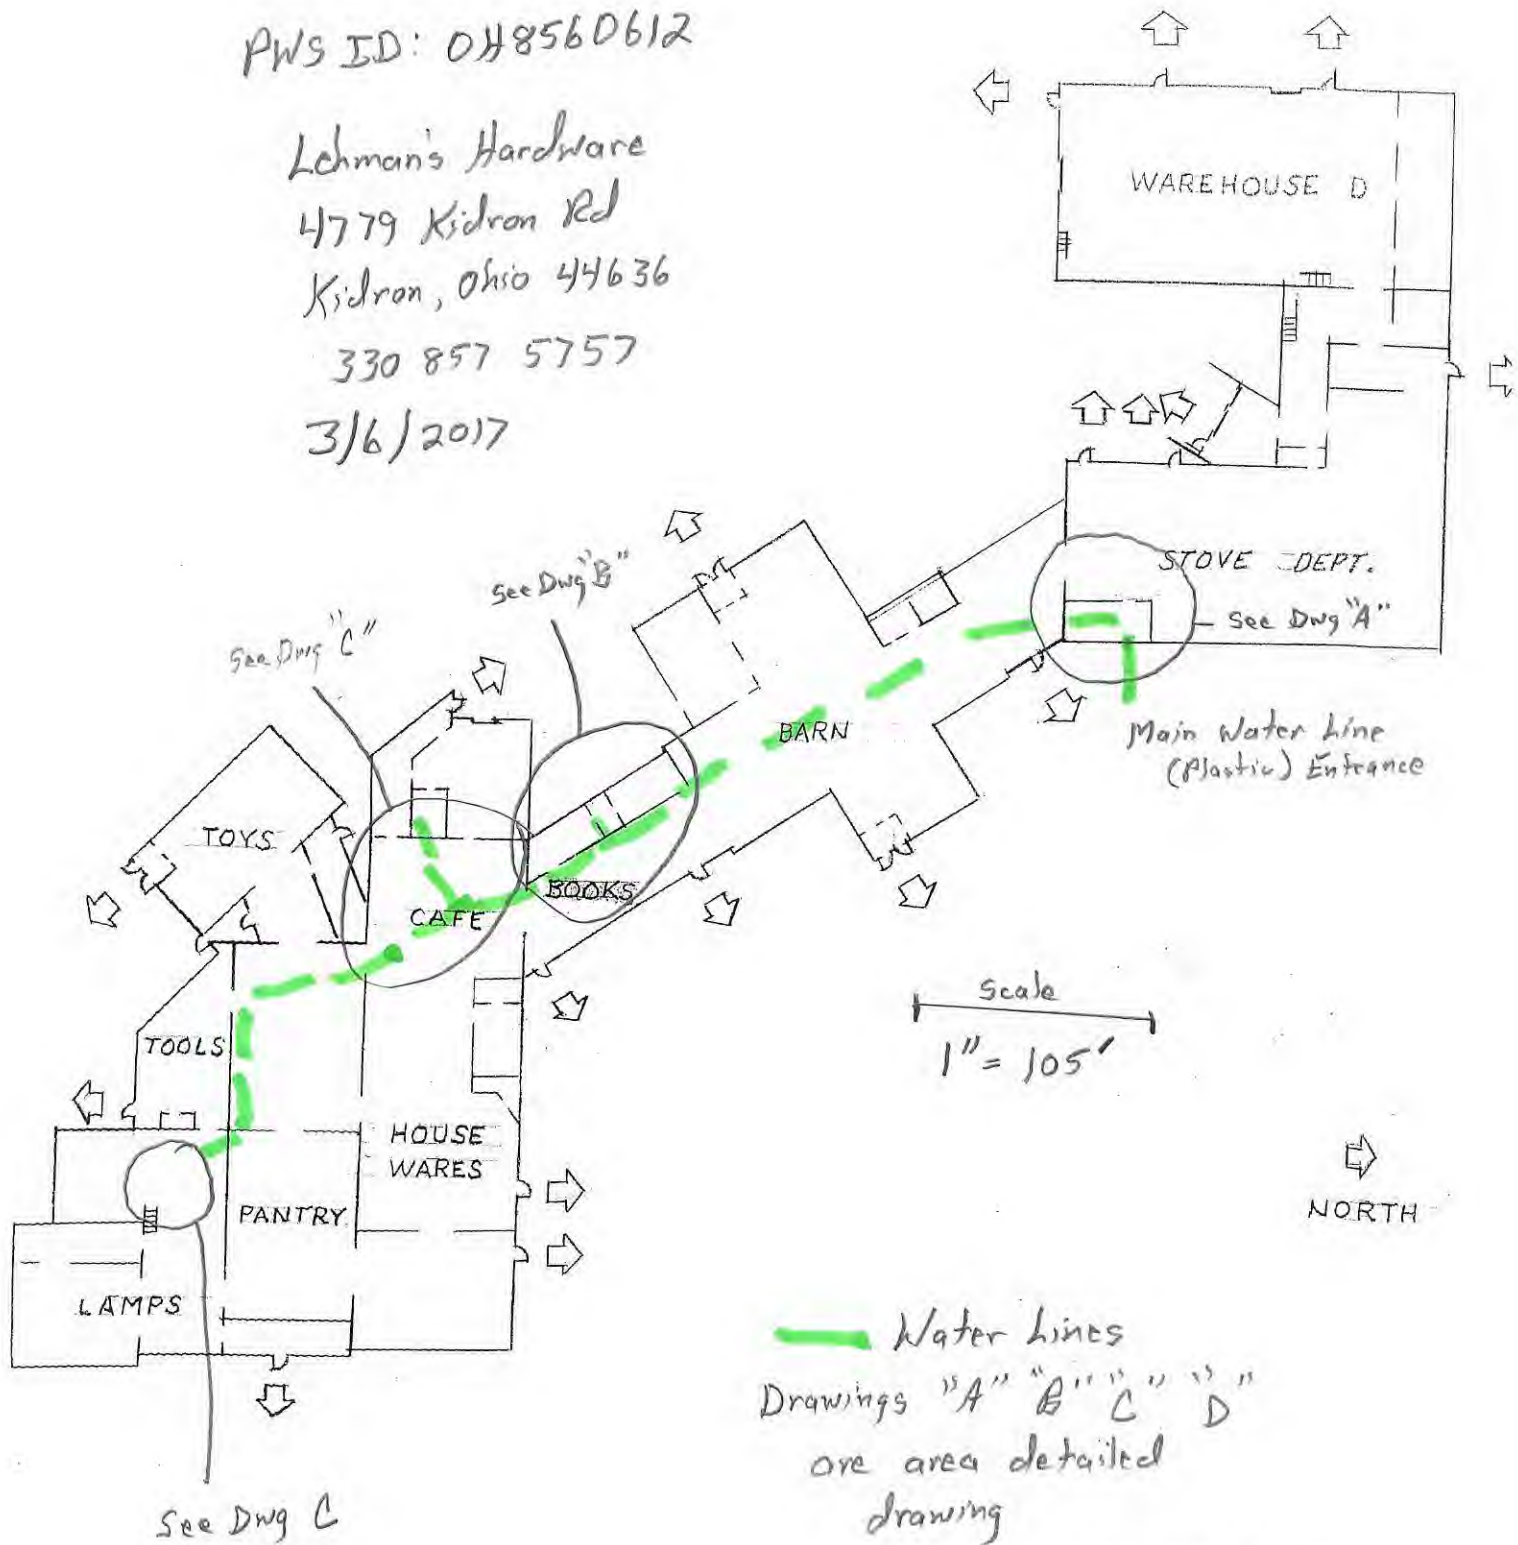

ALL WATERLINES INSTALLED IN 2007

KIDRON STORE
5-3-11

W


(A)

Water Softener

Room

Plastic

Hall

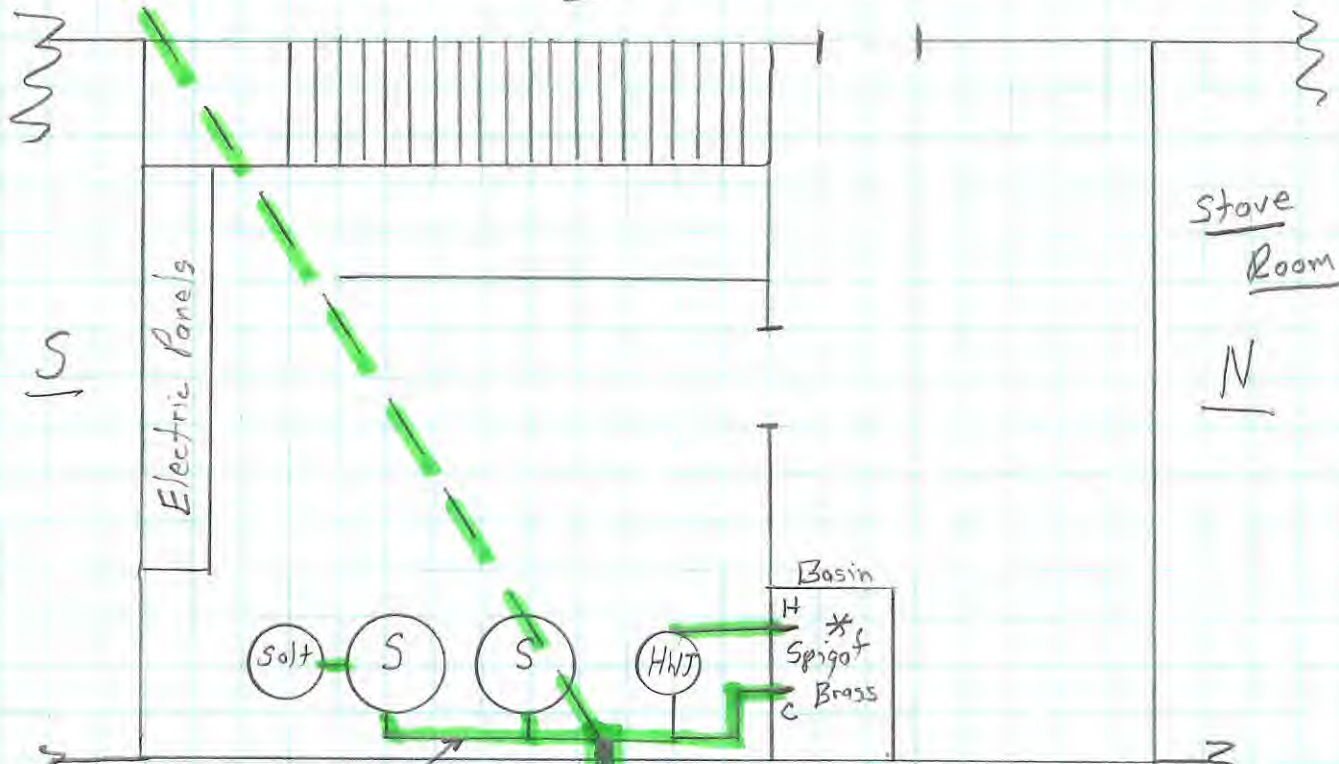

S

Electric Panels

Stove Room

N

Basin

H
*
Spigot
C
Brass

Salt

S

S

HNT

Main Water Line

Entrance


(Plastic)

Plastic

E

(B)

W

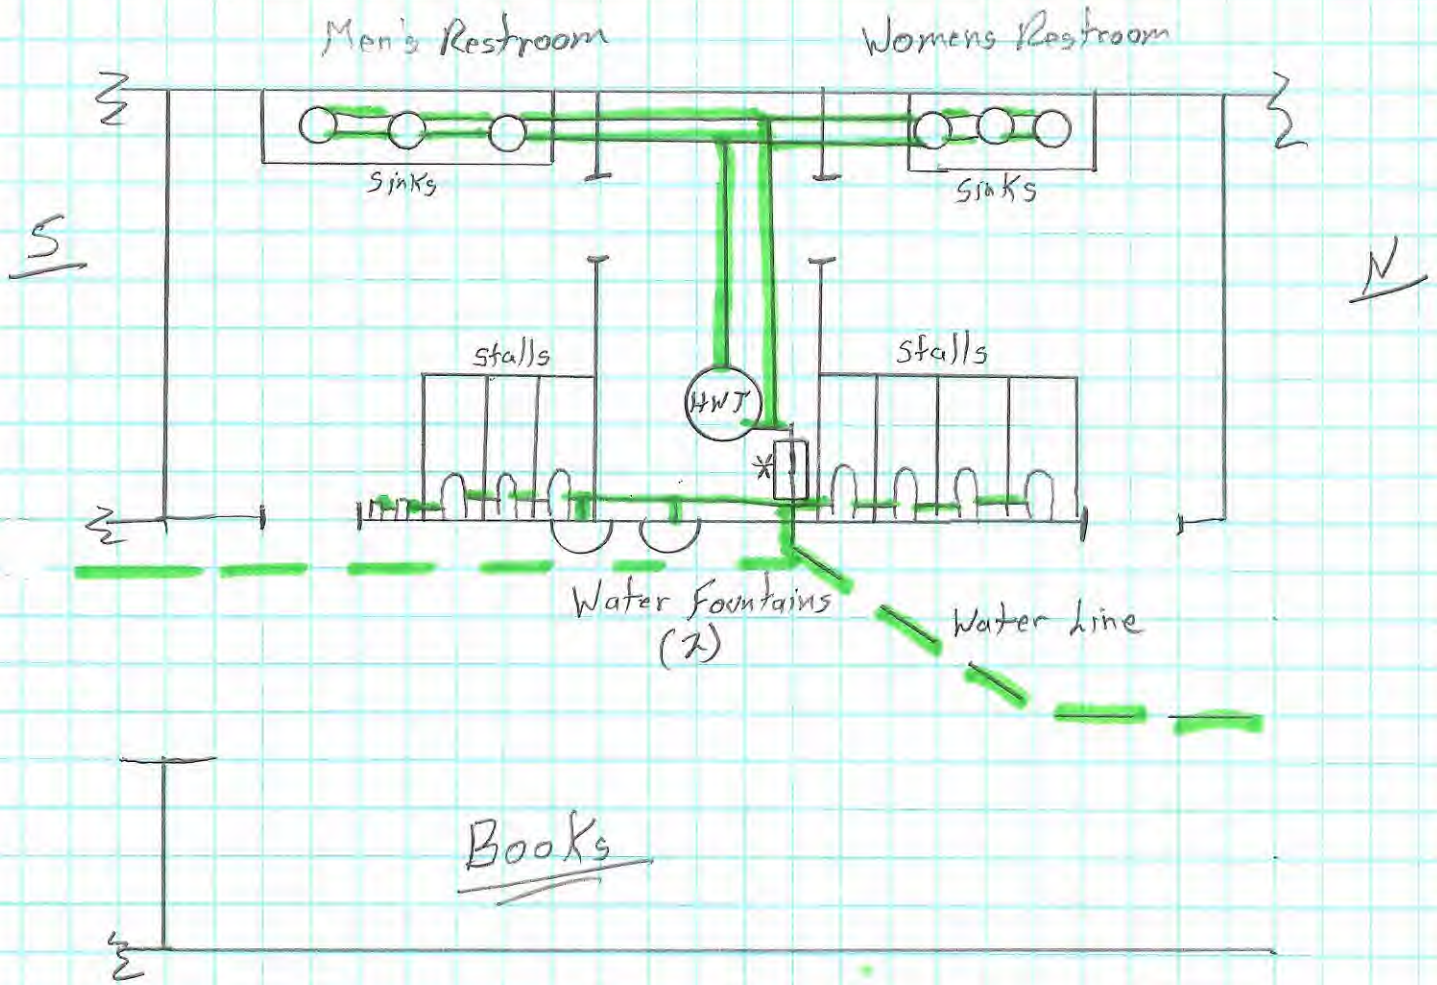


- Fixtures for sinks
and water fountain
are brass

* Copper/solder water lines
by Hot Water Tank.
Other water lines plastic.

(C)


W Parking Lot

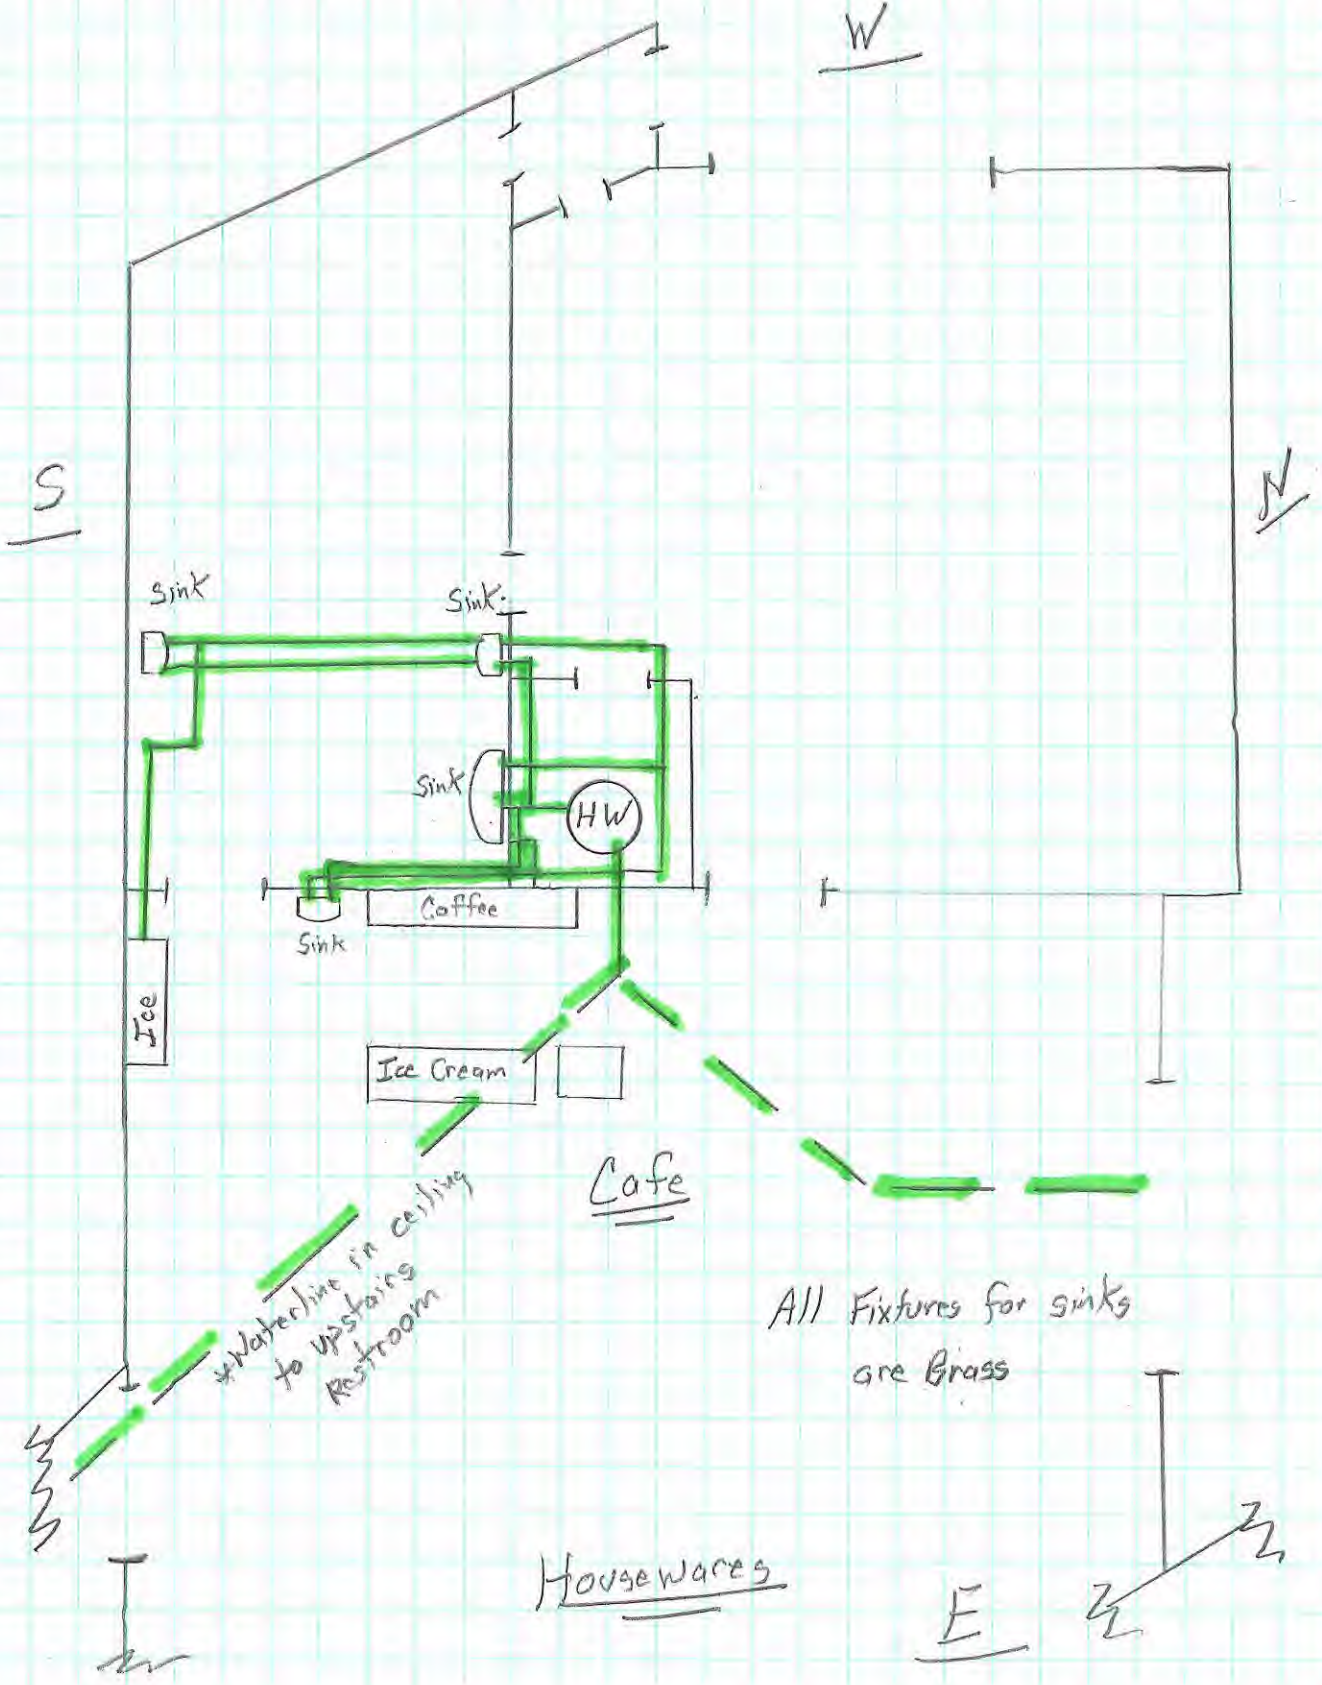

(D)

W

Upstairs Restroom

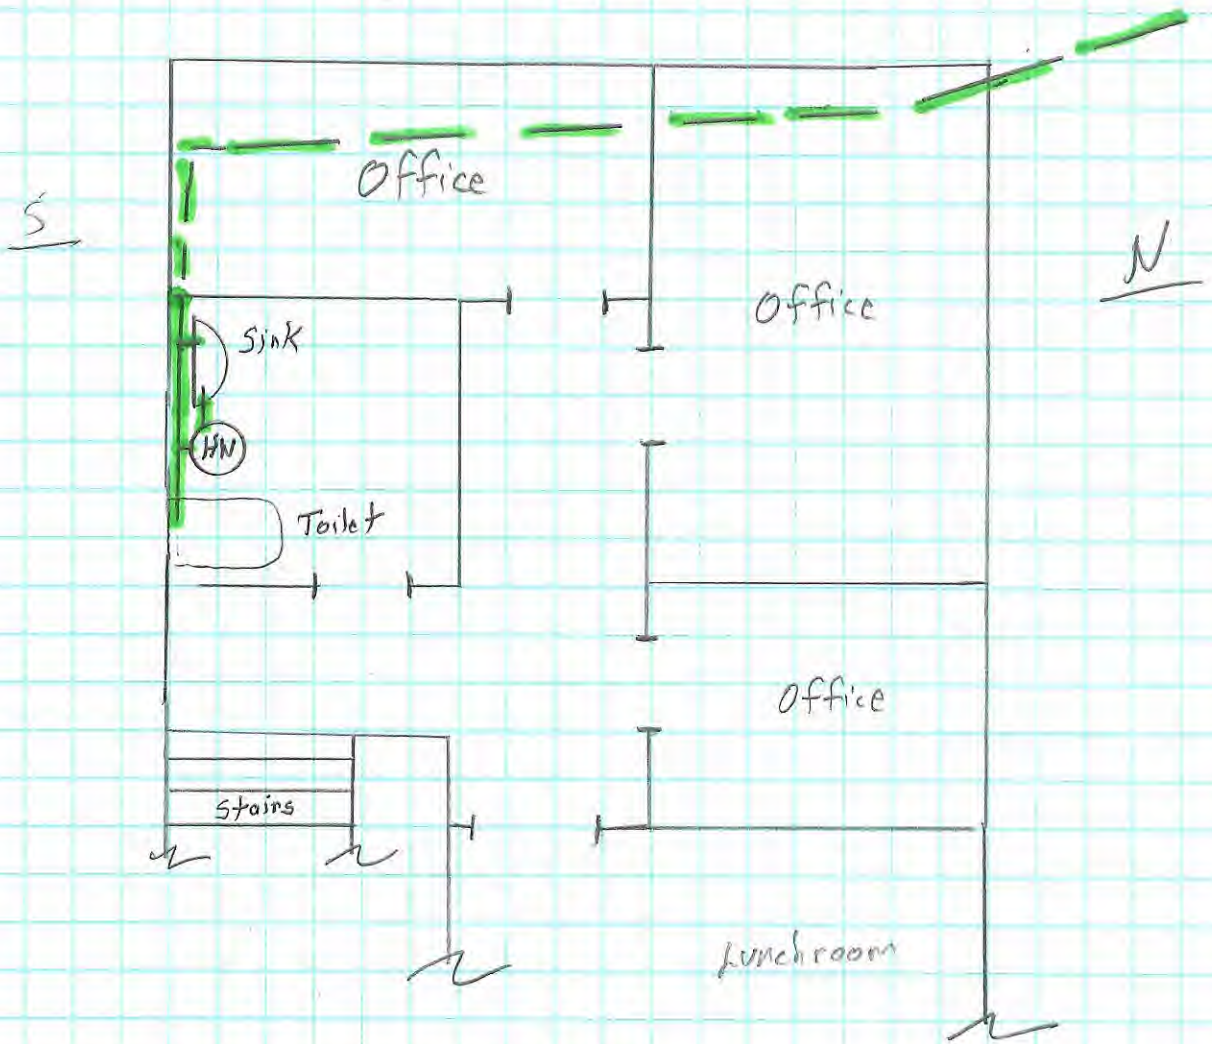

*Sink fixture

is brass

E