


# Kiddie Kingdom, LLC

1075 Jasper Rd.  
Xenia, OH 45385  
937-372-4986  
PWS ID 2941912



Jasper Rd.

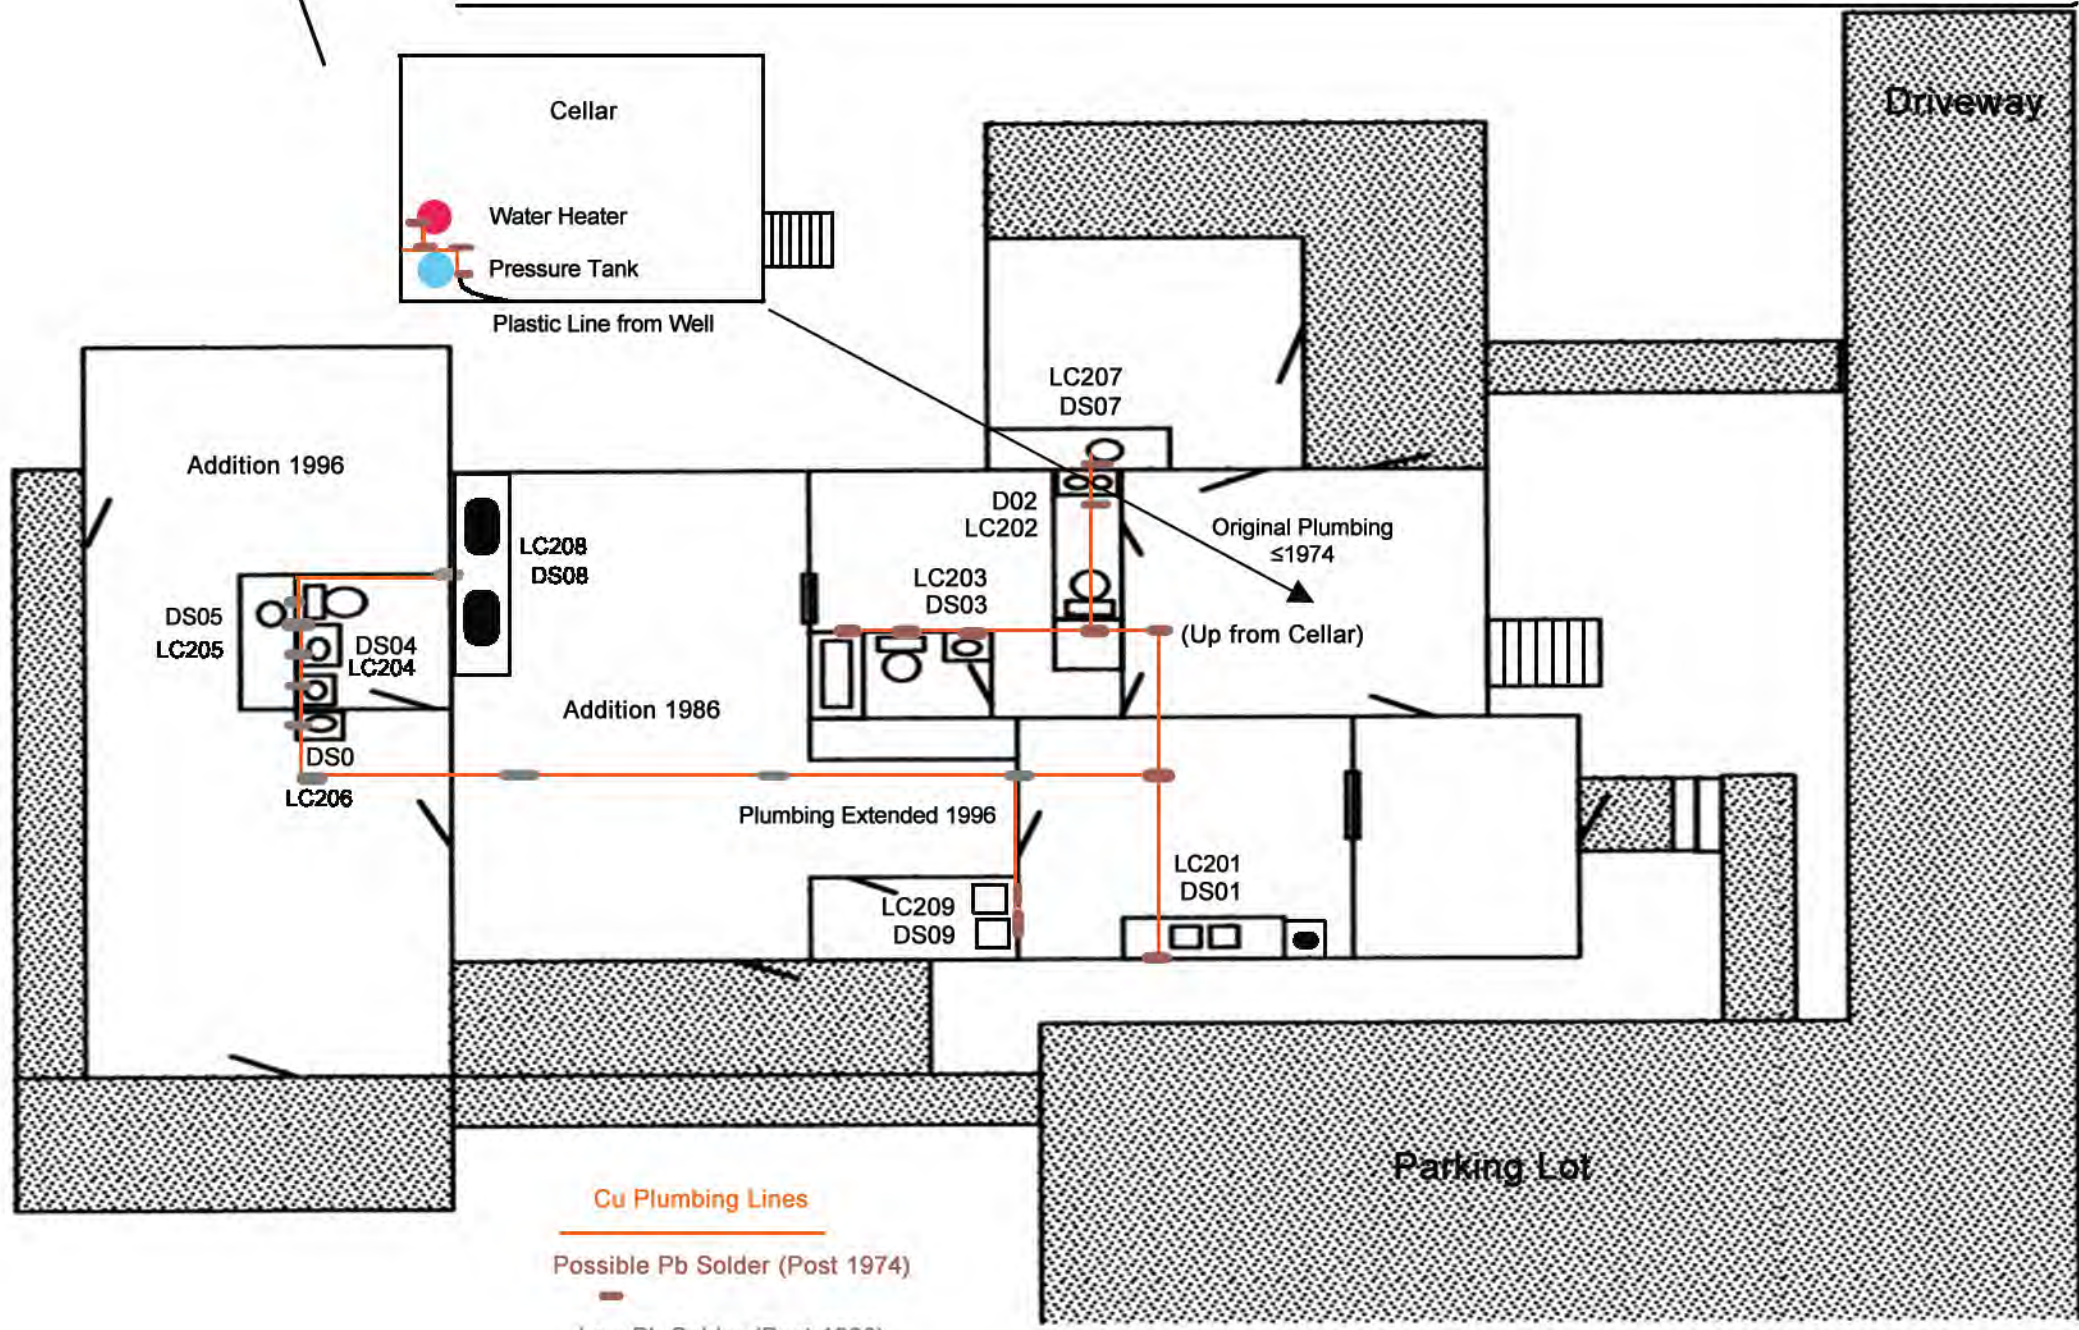

Cu Plumbing Lines

Possible Pb Solder (Post 1974)



Low Pb Solder (Post 1986)

