


COLUMBUS DPU Customer Lead Map

updated on 1/22/19

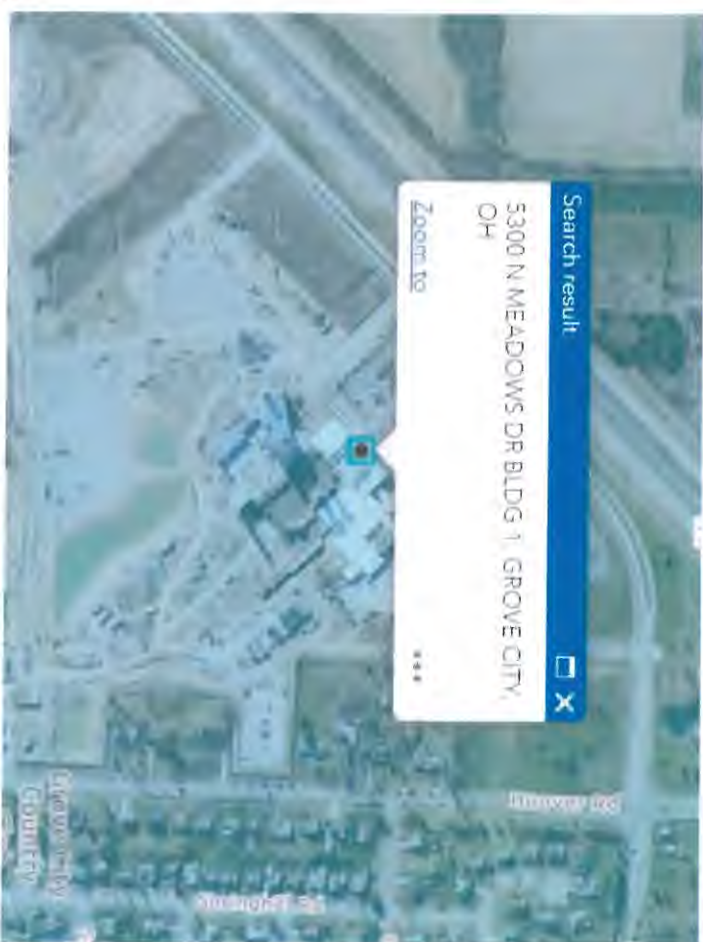

Mount Carmel Grove City
PWSID: OH2570730
5300 N. Meadows Dr.
Grove City, OH, 43123
614-663-5000

Map Details

Possible Publicly Owned Lead Service Line

Publicly Owned Lead Service Line has either been removed or is not in use

Other Public Water System (contact your provider for supply information)


City of Columbus Water Service Area


1. Enter your address in the upper left corner or zoom to your home/building.
2. If there is no symbol (blue dot or red 'X'), then our records indicated no public side lead service.
3. If there is a blue dot or red 'X', click on the symbol for additional information;

City of Columbus determined Service line was not a lead service line because there is no blue dot or red X. Mount Carmel Grove City personnel determined the service lines were stainless steel



Mount Carmel Grove City
 5300 N. Meadows Dr.
 Grove City, OH, 43123
 614-663-5000

 Indicates not treated by chloraminated water; all other parts of hospital are treated

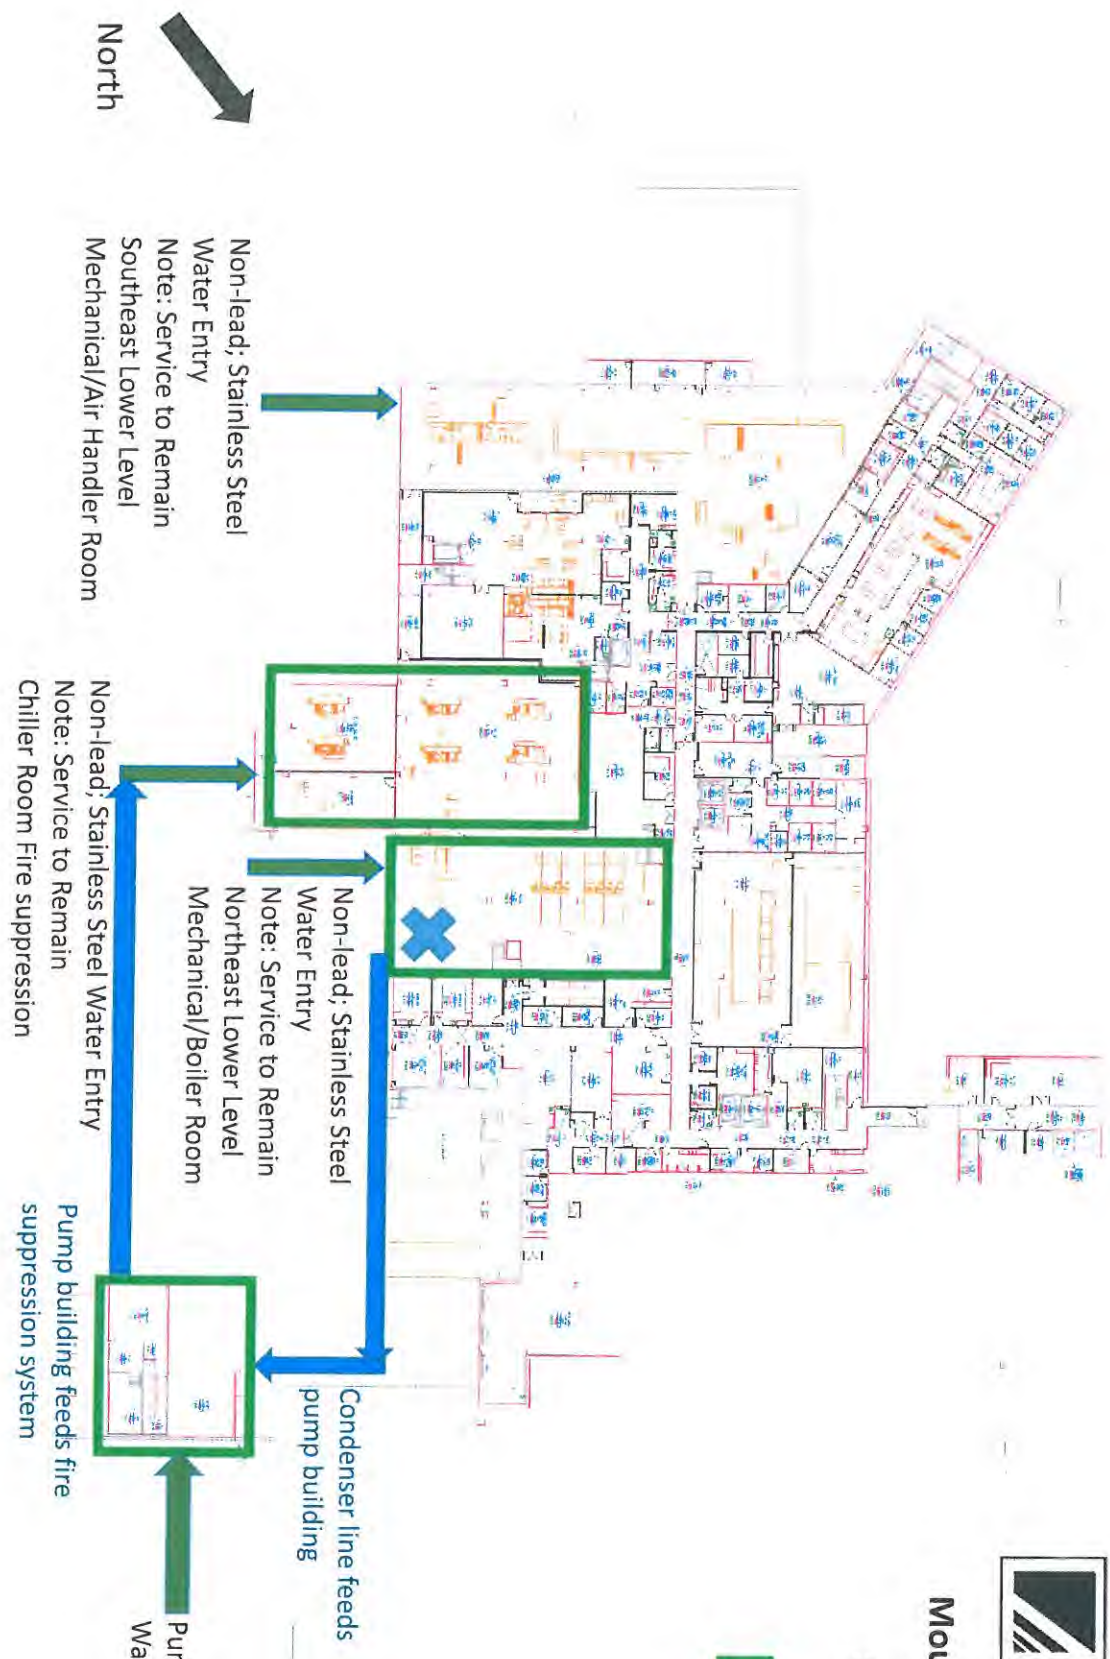


MT. CARMEL HEALTH
GROVE CITY
FIRST FLOOR



Non-lead, Stainless Steel
Water Entry
Note: Service to be severed



North

Mount Carmel Grove City
5300 N. Meadows Dr.
Grove City, OH, 43123
614-663-5000



PWS Name: Mount Carmel Grove City
 PWS ID: OH2570730
 PWS Type: MTMC

Spreadsheet for lead and copper sample sites

* = Required field † = Required for Tier Determination

Please return to your Ohio EPA District Office

SMP ID*	Tier Site (Amended)	Street Address*	City*	State* Zip*	Tap Location*	Resident Name*	Resident (Home) Phone #*	Resident (Cell) Phone #*	Resident Email	Plumbing Age Year	Plumbing Age**	Type of Interior Plumbing*†	Service Line Material*†	Structure Type**†

Spreadsheet for lead and copper sample sites

* = Required field + = Required for Tier Determination


Please return to your Ohio EPA District Office

SMP ID*	Tier Site (Automatic)	Street Address*	City*	State*	Zip*	Tap Location*
LC201	Other	5300 N. Meadows Dr.	Grove City	OH	43123	Floor 7, next to room 7113, hand wash sink in medication station in hallway
LC202	Other	5301 N. Meadows Dr.	Grove City	OH	43123	Floor 7 kitchenette sink in room 7033
LC203	Other	5302 N. Meadows Dr.	Grove City	OH	43123	Floor 7, next to room 7009, hand wash sink in medication station in hallway
LC204	Other	5303 N. Meadows Dr.	Grove City	OH	43123	Floor 7, next to room 7204, hand wash sink in medication station in hallway
LC205	Other	5304 N. Meadows Dr.	Grove City	OH	43123	Floor 5, next to room 5105, hand wash sink in medication station in hallway
LC206	Other	5305 N. Meadows Dr.	Grove City	OH	43123	Floor 5, next to room 5113, hand wash sink in medication station in hallway
LC207	Other	5306 N. Meadows Dr.	Grove City	OH	43123	Floor 5, Nourishment room 5030, kitchenette sink
LC208	Other	5307 N. Meadows Dr.	Grove City	OH	43123	Floor 5, next to room 5009, hand wash sink in medication station in hallway
LC209	Other	5308 N. Meadows Dr.	Grove City	OH	43123	Floor 5, next to room 5229, hand wash sink in nurse's station
LC210	Other	5309 N. Meadows Dr.	Grove City	OH	43123	Floor 4, next to room 4105, hand wash sink in medication station in hallway
LC211	Other	5310 N. Meadows Dr.	Grove City	OH	43123	Floor 4, next to room 4113, hand wash sink in medication station in hallway
LC212	Other	5311 N. Meadows Dr.	Grove City	OH	43123	Floor 4, Nourishment room 4037, kitchenette sink
LC213	Other	5312 N. Meadows Dr.	Grove City	OH	43123	Floor 4, next to room 4009, hand wash sink in medication station in hallway
LC214	Other	5313 N. Meadows Dr.	Grove City	OH	43123	Floor 2, In Prep Recovery 26-30 hand wash sink between 20 and 21
LC215	Other	5314 N. Meadows Dr.	Grove City	OH	43123	Floor 2, In Prep Recovery 26-30 hand wash sink between 22 and 23
LC216	Other	5315 N. Meadows Dr.	Grove City	OH	43123	Floor 1, Emergency Dept, nurse's station hand wash sink near room 1E23
LC217	Other	5316 N. Meadows Dr.	Grove City	OH	43123	Floor 1, Emergency Dept, hand wash sink in restroom 1E21.01T next to Results Lounge
LC218	Other	5317 N. Meadows Dr.	Grove City	OH	43123	Floor 1, kitchenette sink in room 1444M
LC219	Other	5318 N. Meadows Dr.	Grove City	OH	43123	Floor LL, hand wash sink in facilities
LC220	Other	5319 N. Meadows Dr.	Grove City	OH	43123	

Mount Carmel Grove City

PWSID: OH2570730

5300 N. Meadows Dr.
Grove City, OH, 43123

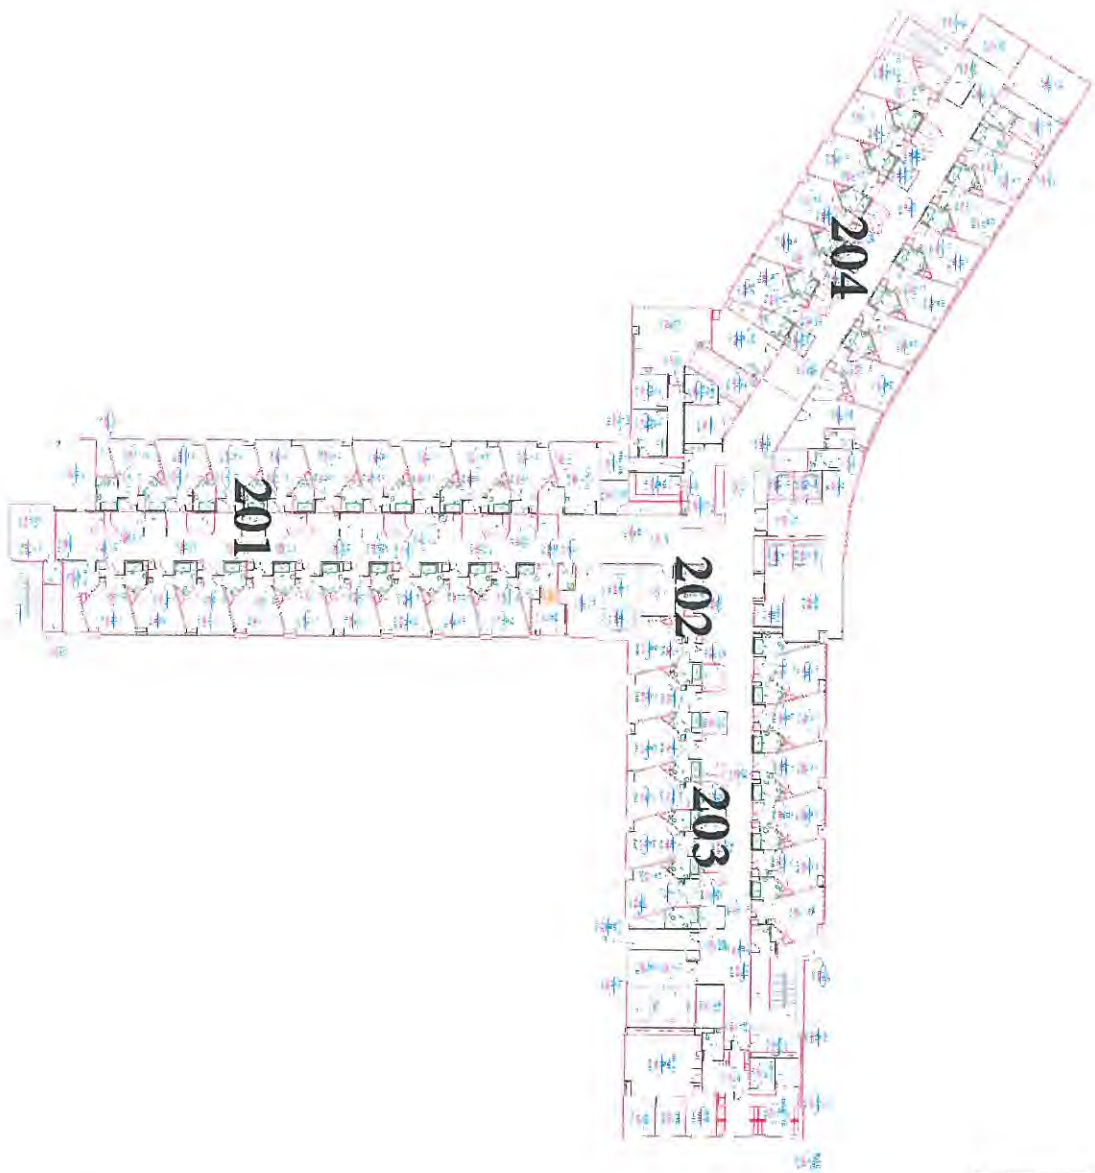



MT. CARMEL HEALTH
GROVE CITY
SEVENTH FLOOR

Building Constructed in
 2019 except old section of
 Emergency Department in
 2014; All sample site fixture
 lead content is unknown

Mount Carmel Grove City
 5300 N. Meadows Dr.
 Grove City, OH, 43123
 614-663-5000


MT. CARMEL HEALTH
 GROVE CITY
 FIFTH FLOOR

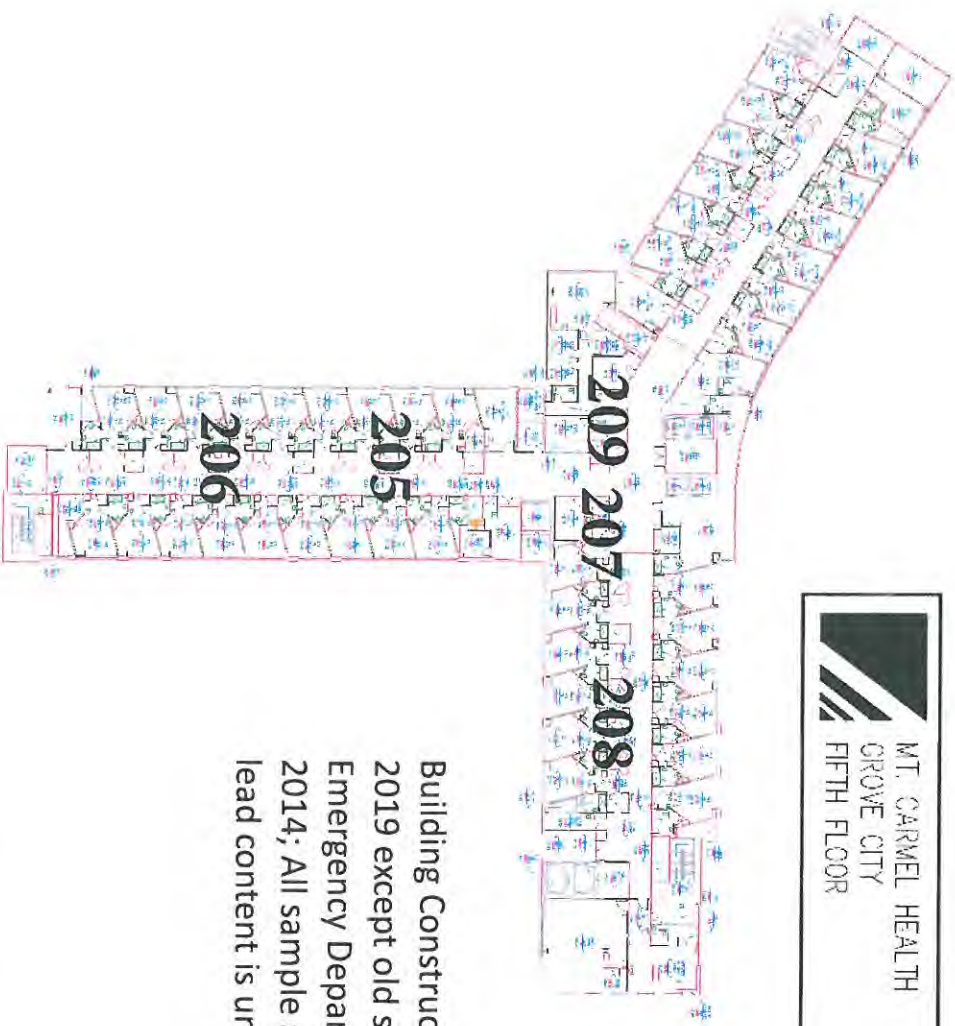

Building Constructed in
 2019 except old section of
 Emergency Department in
 2014. All sample site fixture
 lead content is unknown

Mount Carmel Grove City
 5300 N. Meadows Dr.
 Grove City, OH, 43123
 614-663-5000




North





MT. CARMEL HEALTH
GROVE CITY
FOURTH FLOOR

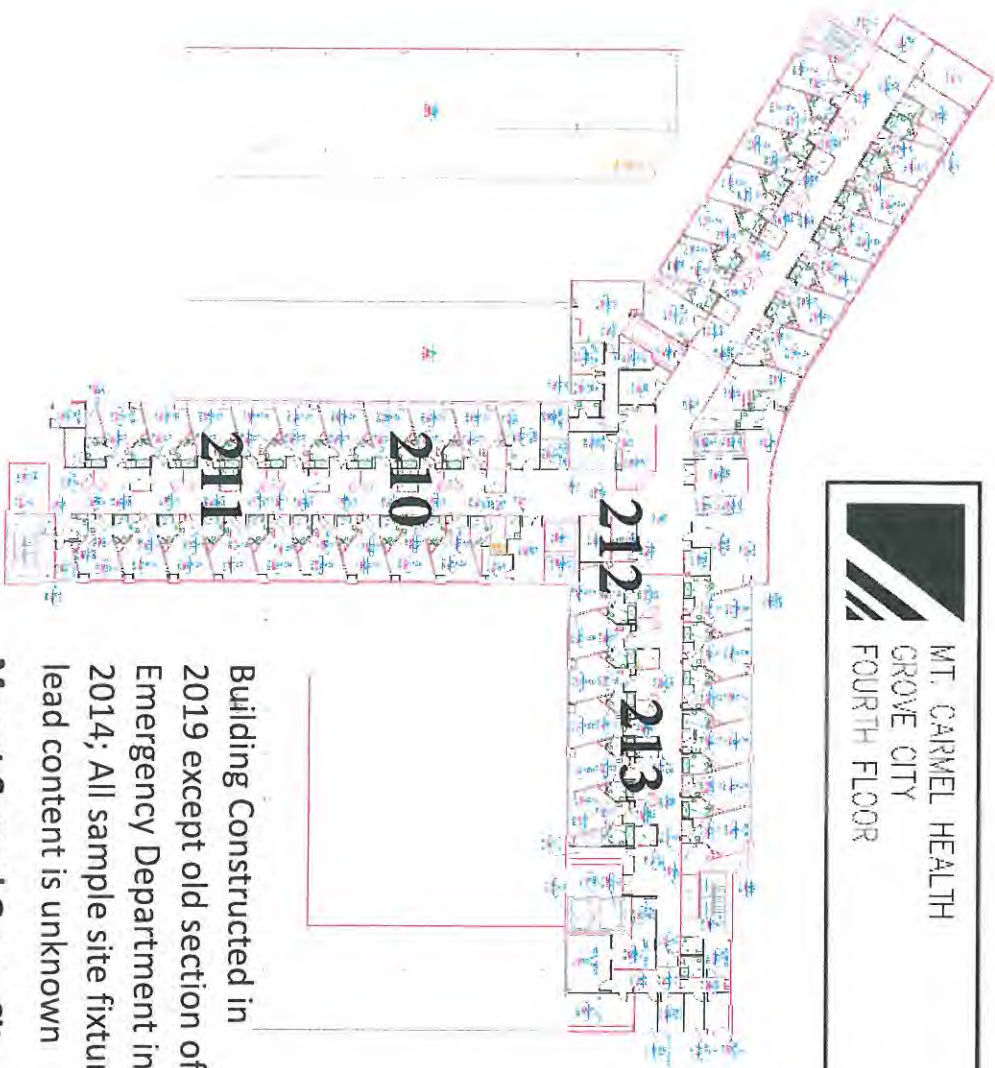

Building Constructed in
2019 except old section of
Emergency Department in
2014; All sample site fixture
lead content is unknown

Mount Carmel Grove City

5300 N. Meadows Dr.
Grove City, OH, 43123
614-663-5000


MT. CARMEL HEALTH
GROVE CITY
SECOND FLOOR



Building Constructed in
2019 except old section of
Emergency-Department in
2014; All sample site fixture
lead content is unknown

Mount Carmel Grove City
5300 N. Meadows Dr.
Grove City, OH, 43123
614-663-5000



MT. CARMEL HEALTH
GROVE CITY
FIRST FLOOR

Site 217 and 218 in 2014
ED building



Building Constructed in 2019 except old
section of Emergency Department in 2014; All
sample site fixture lead content is unknown

Mount Carmel Grove City
5300 N. Meadows Dr.
Grove City, OH, 43123
614-663-5000



Building Constructed in
2019 except old section of
Emergency Department in
2014; All sample site fixture
lead content is unknown



North



Mount Carmel Grove City
5300 N. Meadows Dr.
Grove City, OH, 43123
614-663-5000