

BASEMENT FRESH WATER PLAN
SCALE: 1/8" = 1'-0"

1ST FLOOR FRESH WATER PLAN
SCALE: 1/8" = 1'-0"

PWS ID OH1938712


LEGEND

- = COPPER INSTALLED 1962 (POSSIBLE LEAD)
- = COPPER INSTALLED 2020 (NO LEAD)
- = PLASTIC INSTALLED 2020 (NO LEAD)


Buildings in Ohio built prior to 1998 or that use plumbing material or solder manufactured before 1998 may have materials with greater than 8% lead and are at a higher risk of contributing lead to the drinking water than materials manufactured after 1998. In addition, buildings built and plumbing materials manufactured after 2014 were required to have less than 0.25% lead by weight and have the lowest risk for contributing lead to the drinking water. It should be noted however that, although prohibited, some use of leaded solder or leaded components may have occurred after the prohibitions became effective.

- HCW - HARD COLD WATER
- SCW - SOFT COLD WATER
- HW - HOT WATER SOFT
- HWR - HOT WATER RETURN
- RO - REVERSE OSMOSIS WATER

REVISIONS:	
A	REVISION #1 11/4/19
B	
C	
D	05-23-2019 REGAL PLUMBING 9503-9519 OH-29 SIDNEY, OHIO 45385 (937) 497-2006
E	
F	NEW ADDITION TO: OSGOOD STATE BANK 275 WEST MAIN STREET OSGOOD, OH
G	
H	
I	The concepts, ideas, designs, plans, and details as shown on this document are the sole property of Regal Plumbing & Heating, Inc., and were created, developed and presented for use on this specific project. None of the concepts, ideas, designs, plans, and details shall be used by any person, firm, or corporation for any purpose whatsoever, without the expressed written consent of Regal Plumbing & Heating, Inc.
J	
K	DRAWING INFO: DRAWN BY: L.A.C. CHECKED BY: R.B. DATE: 05-23-2019 JOB NUMBER: 75-01735 SCALE: SEE DWG
L	P3.1

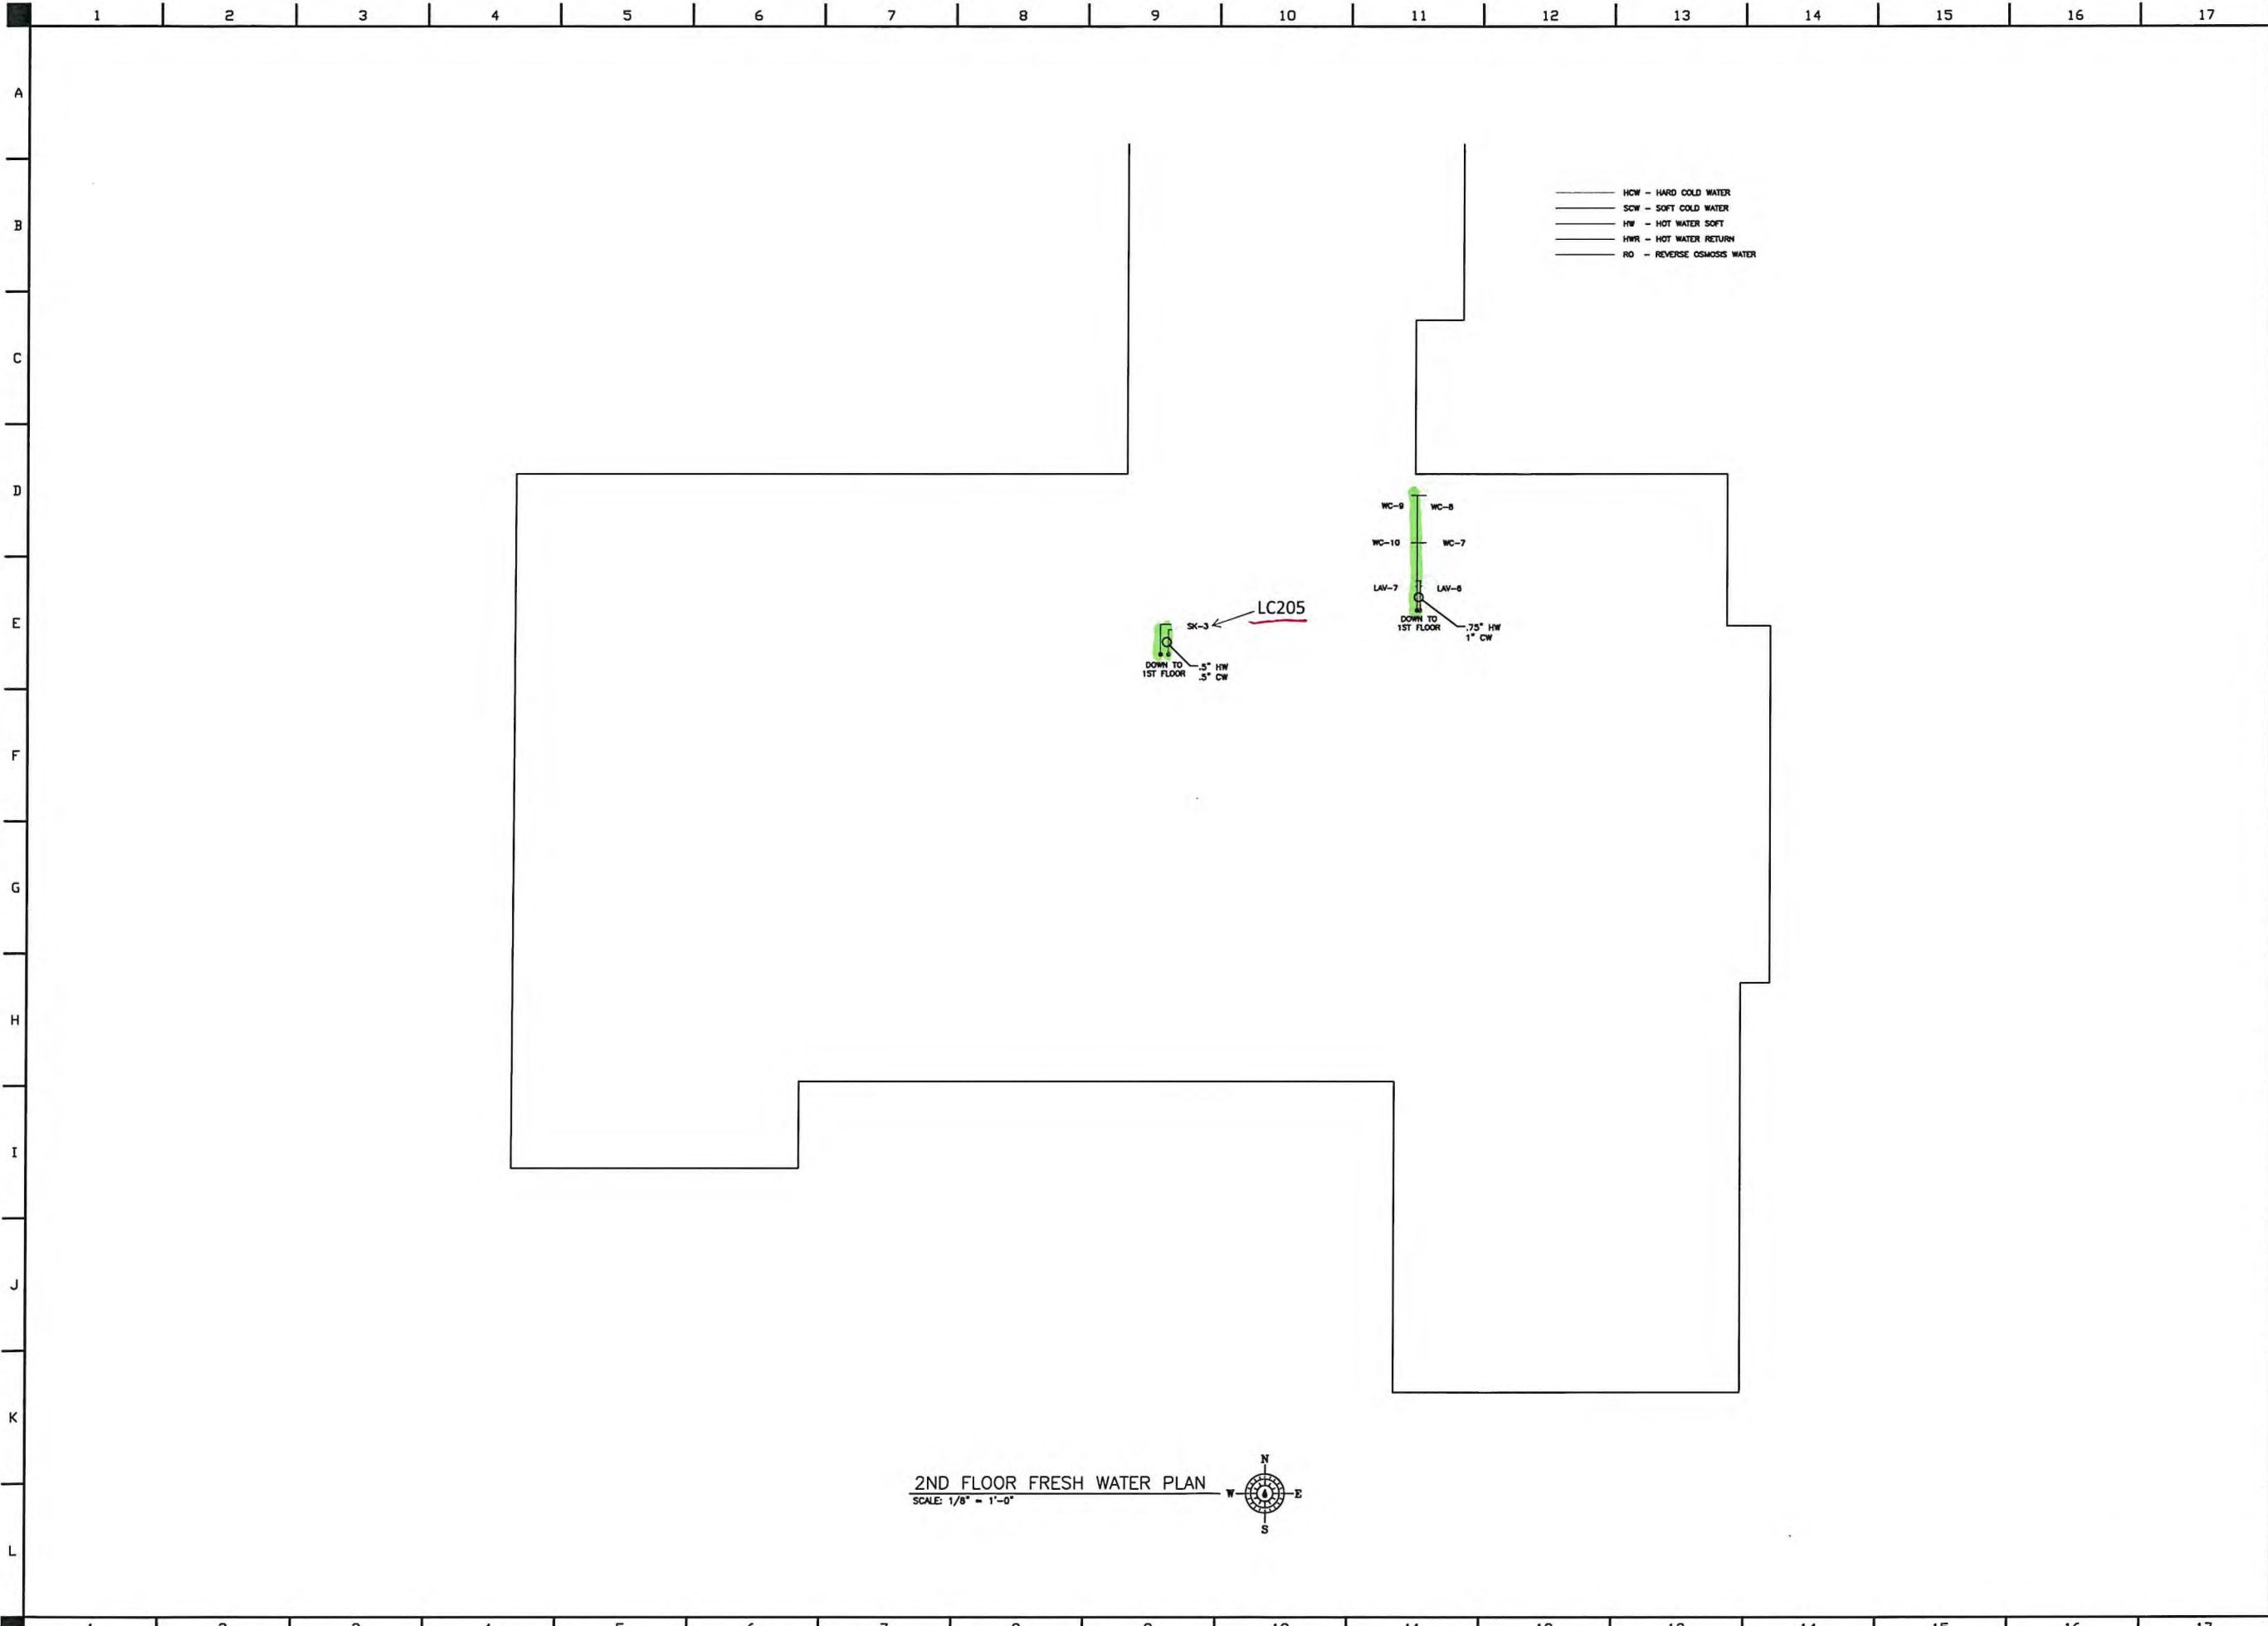

2ND FLOOR FRESH WATER PLAN
 SCALE: 1/8" = 1'-0"

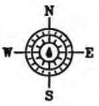

REVISIONS:	
A	
B	
C	
D	
E	
F	
G	
H	
I	
J	
K	
L	

05-23-2019
 REGAL PLUMBING
 9503-9519 OH-29
 SIDNEY, OHIO 45365
 (937) 497-2006

NEW ADDITION TO:
**OSGOOD
 STATE BANK**
 275 WEST MAIN STREET
 OSGOOD, OH

The concepts, ideas, designs, plans, and details as shown on this document are the sole property of Regal Plumbing & Heating, Inc., and were created, developed and presented for use on this specific project. None of the concepts, ideas, designs, plans, and details shall be used by any person, firm, or corporation for any purpose whatsoever, without the expressed written consent of Regal Plumbing & Heating, Inc.

DRAWING INFO:
DRAWN BY: L.A.C.
CHECKED BY: R.B.
DATE: 05-23-2019
JOB NUMBER: 70-015795
SCALE: SEE DWG

DRAWING NUMBER:

P3.2