


ART SENSE 388 ST. RT. 571  
UNION CITY, OHIO 45390

PWS# 1950624

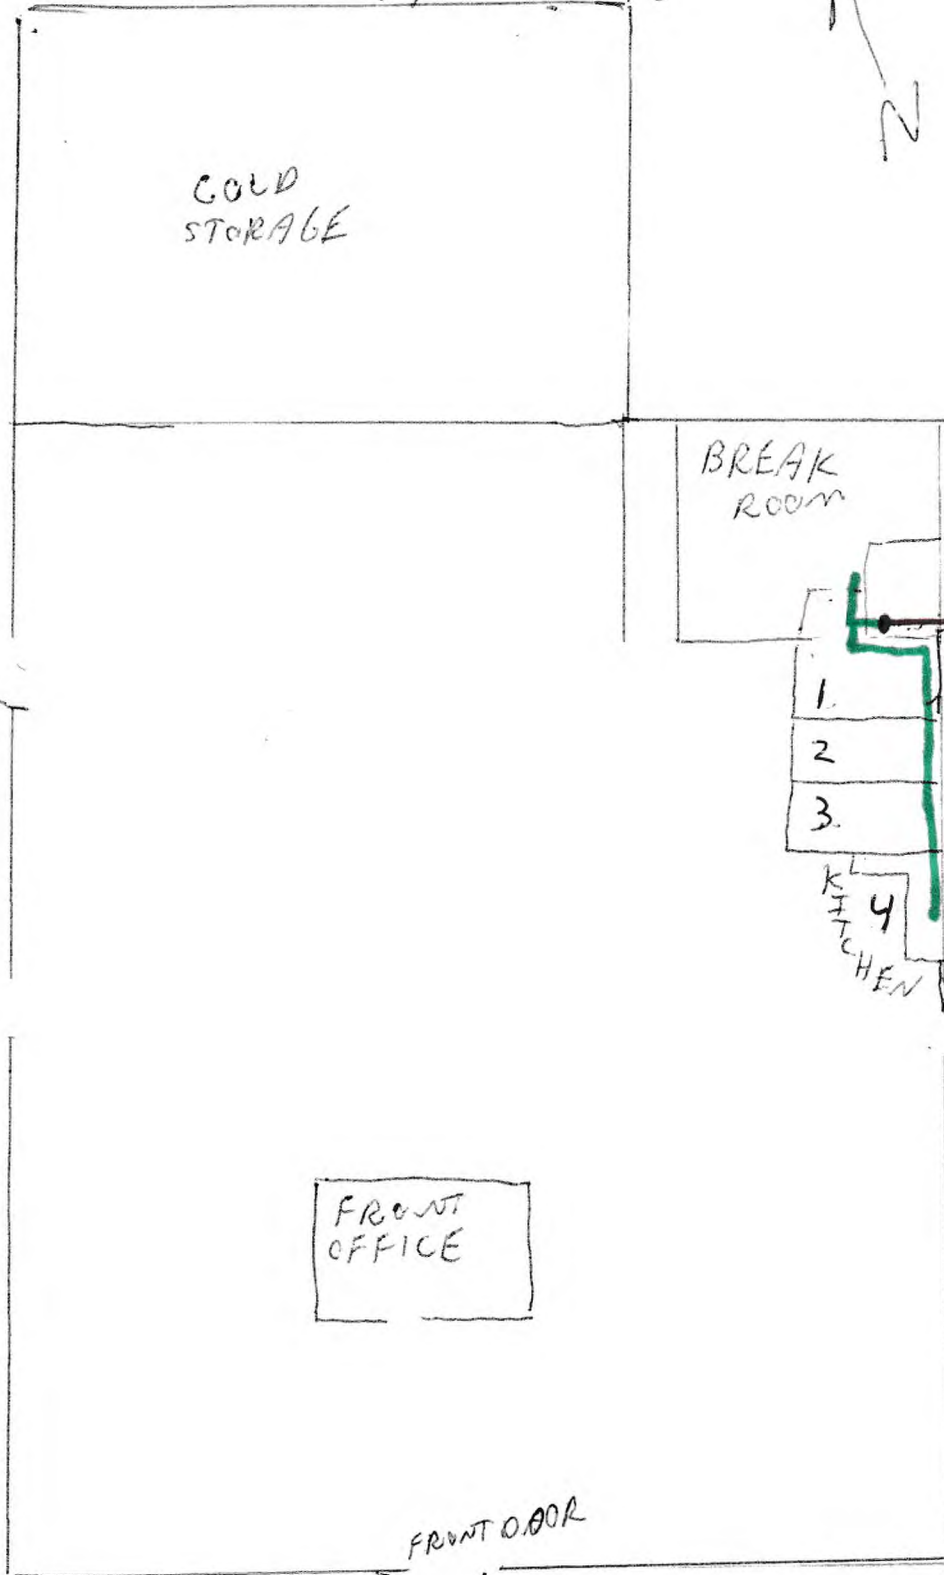

- 1. LC201 WOMEN'S R.R.
- 2. LC202 MEN'S R.R.
- 3. LC203 STAFF R.R.
- 4. LC204 KITCHEN SINK

PARKING LOT

388 STATE ROUTE 571