



LEGEND
 ——— PIPE IS COPPER WITH POTENTIAL LEAD CONTAINING SOLDER USED AT JOINTS
 - - - - PIPE IS PLASTIC AND CONTAINS NO LEAD

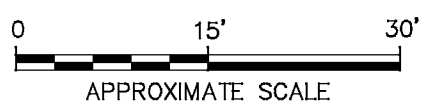


UPS RICHFIELD FREIGHT 3495 BRECKSVILLE ROAD, RICHFIELD, OHIO	
WATER LINE MAP WITH LEAD IN PIPES (BASEMENT)	
	FIGURE 1

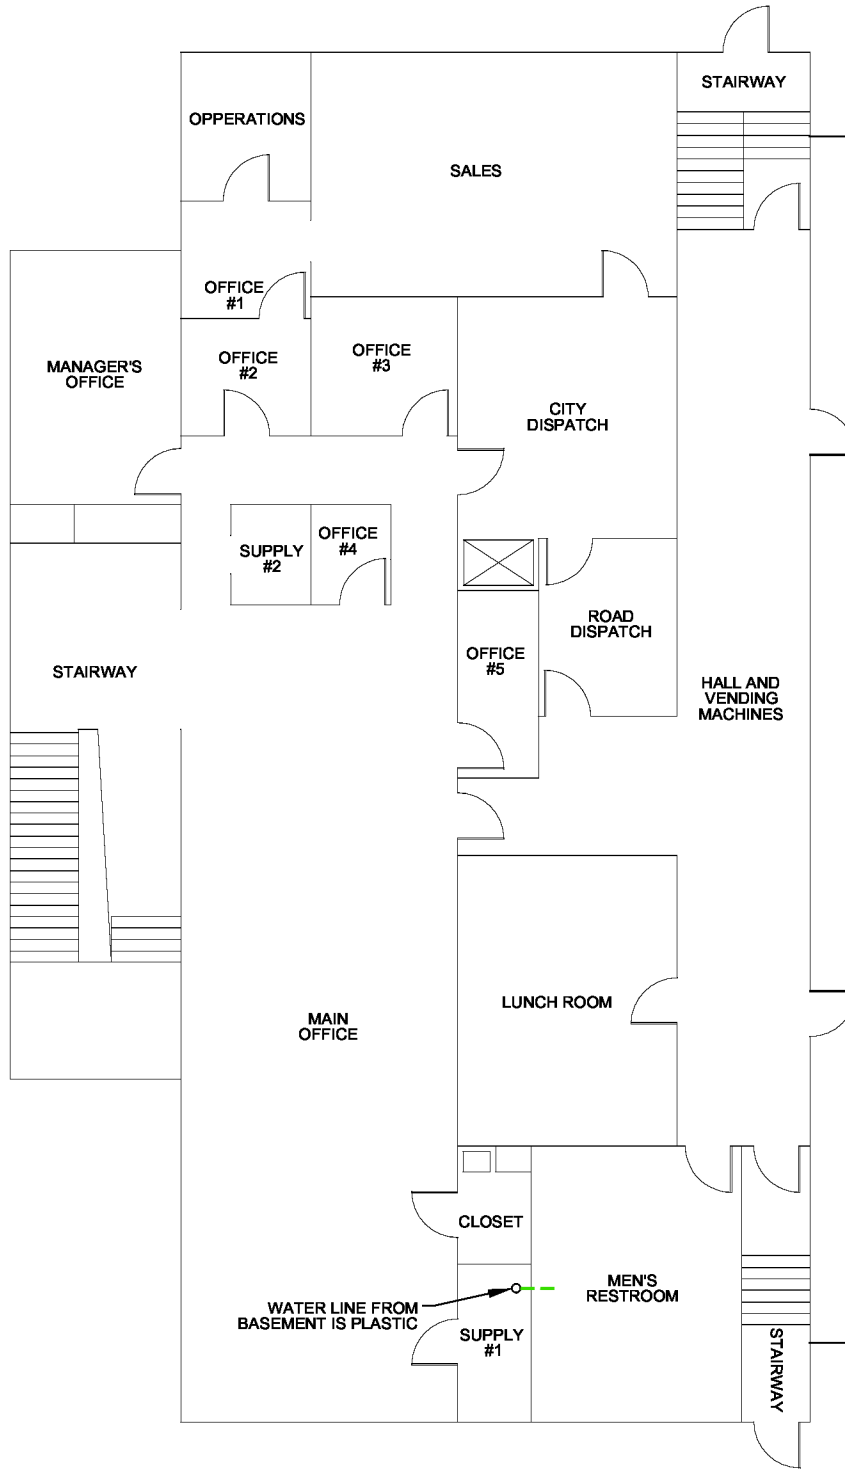

LEGEND

--- PIPE IS PLASTIC AND CONTAINS NO LEAD

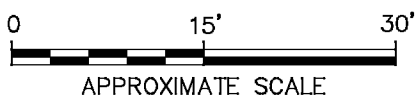

UPS RICHFIELD FREIGHT
3495 BRECKSVILLE ROAD, RICHFIELD, OHIO

**WATER LINE MAP WITH LEAD IN PIPES
(1st FLOOR)**



FIGURE
2