


LEAP

FLOOR: / EVACUATION PLAN

Copper pipe mapping.

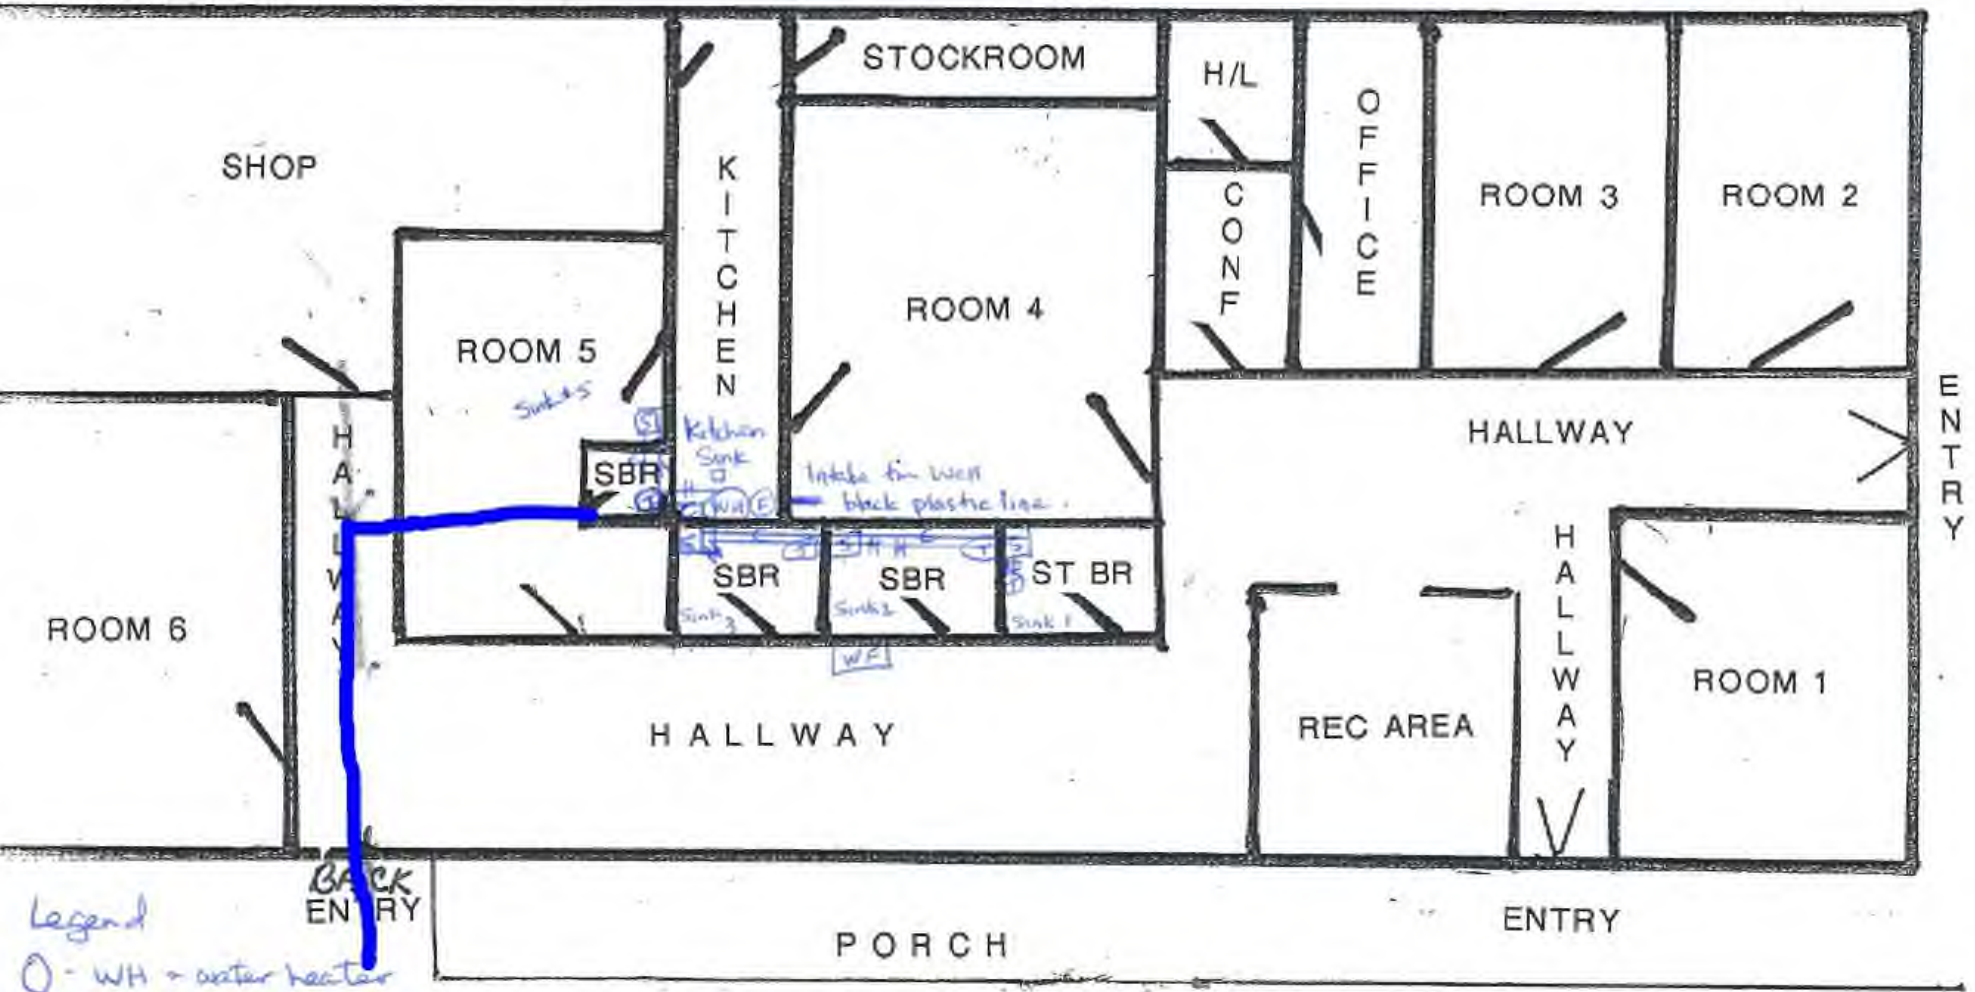

- Legend
- - WH - water heater
 - - F - inline water filter
 - - Sink
 - ⊗ - Toilet
 - ← - cold water line
 - ⊕ - hot water line } all copper
 - ⊞ - water fountain - not used

- LC201 - Staff bathroom (sink 1)
- LC202 - North student bathroom (sink 2)
- LC203 - South student bathroom (sink 3)
- LC204 - Kitchen sink
- LC205 - Utility sink (sink #5)

PARKING

PARKING