


RE: Southwood Estates
Report
Drinking Water Program
Ashland County
PWS ID: OH0301512

RECEIVED

JAN 23 2017

DDAGW - NWDO

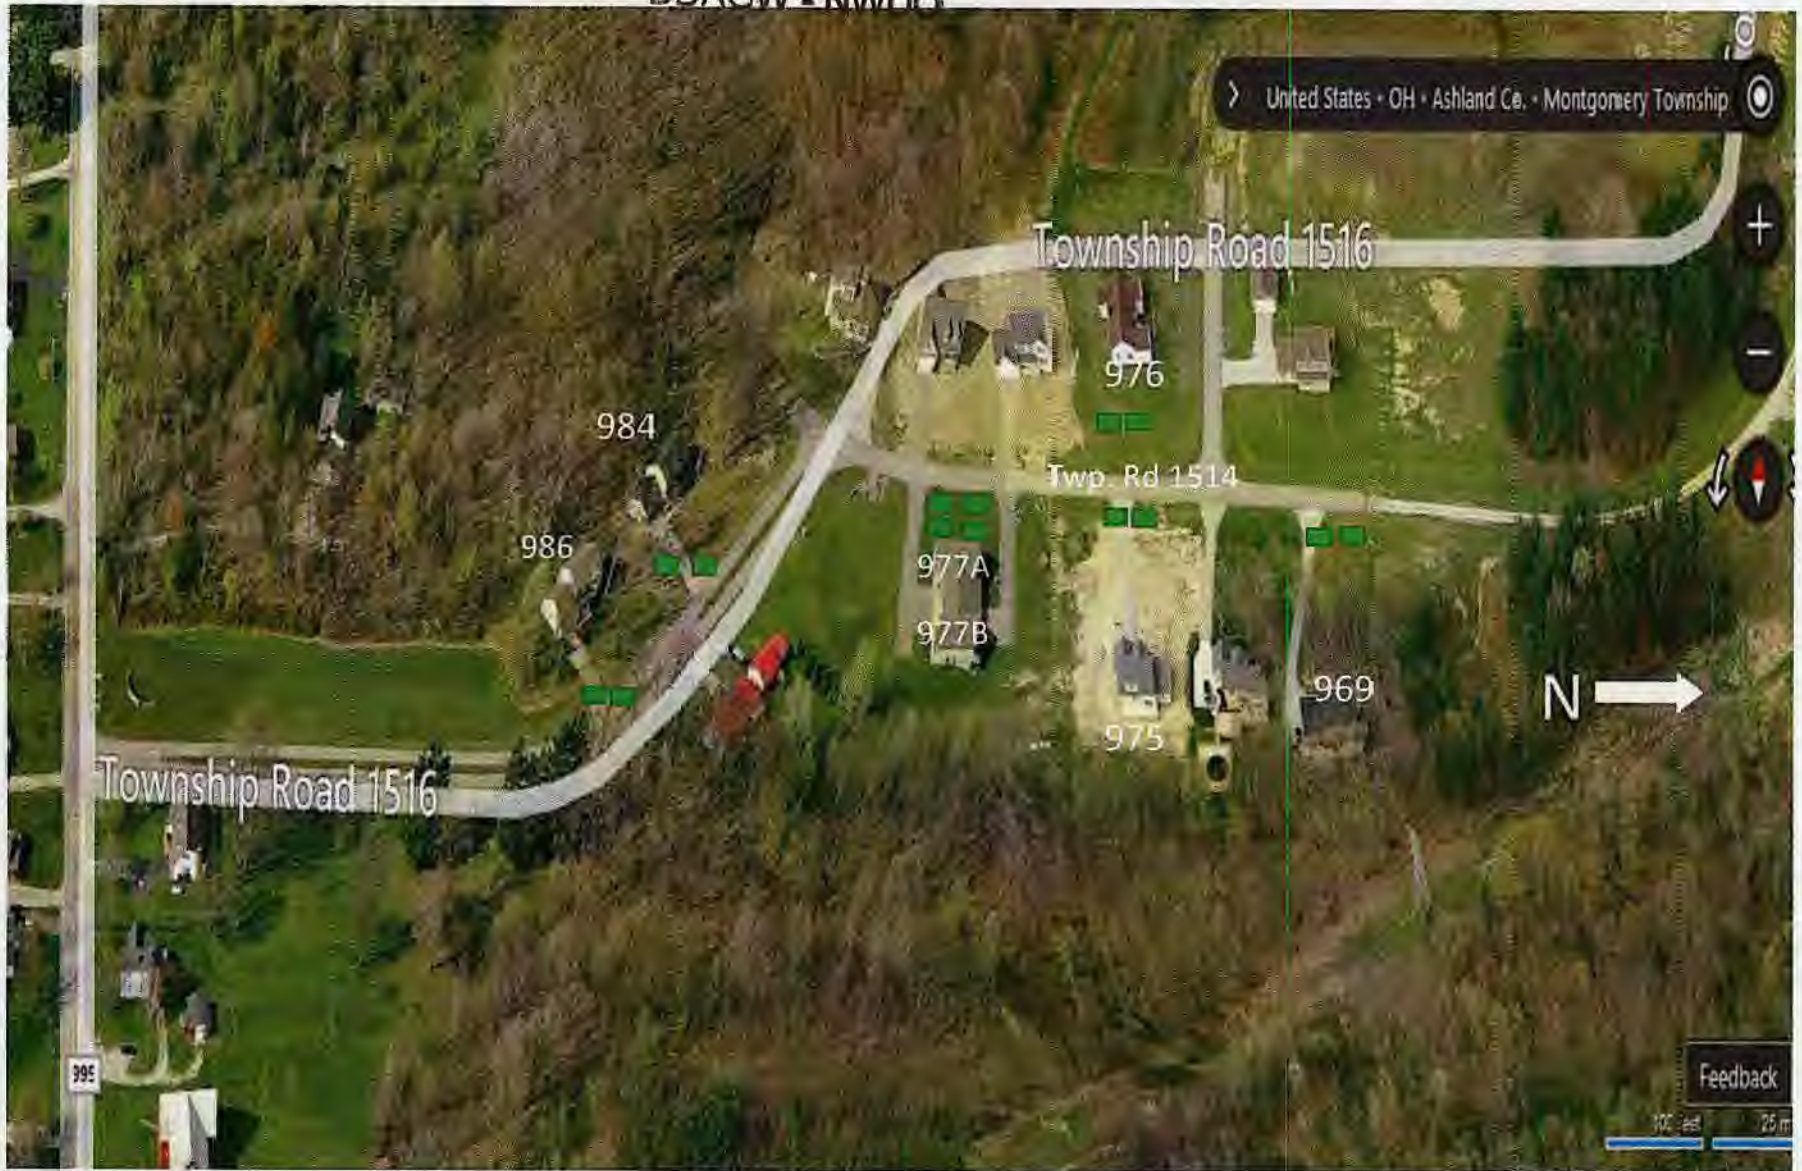

All connections lead free public side / home side

Southwood Estates