

RE: Marion Local High School  
Report  
Drinking Water Program  
Mercer County  
PWS ID: OH5433512

RECEIVED

FEB 01 2017

DCAGW - NWDO

Marion Local High School

• Hot water

2" plastic feed in  
stalled - 99-2001 - with  
Copper feeding Sinks  
~~with~~ with new  
fixtures installed

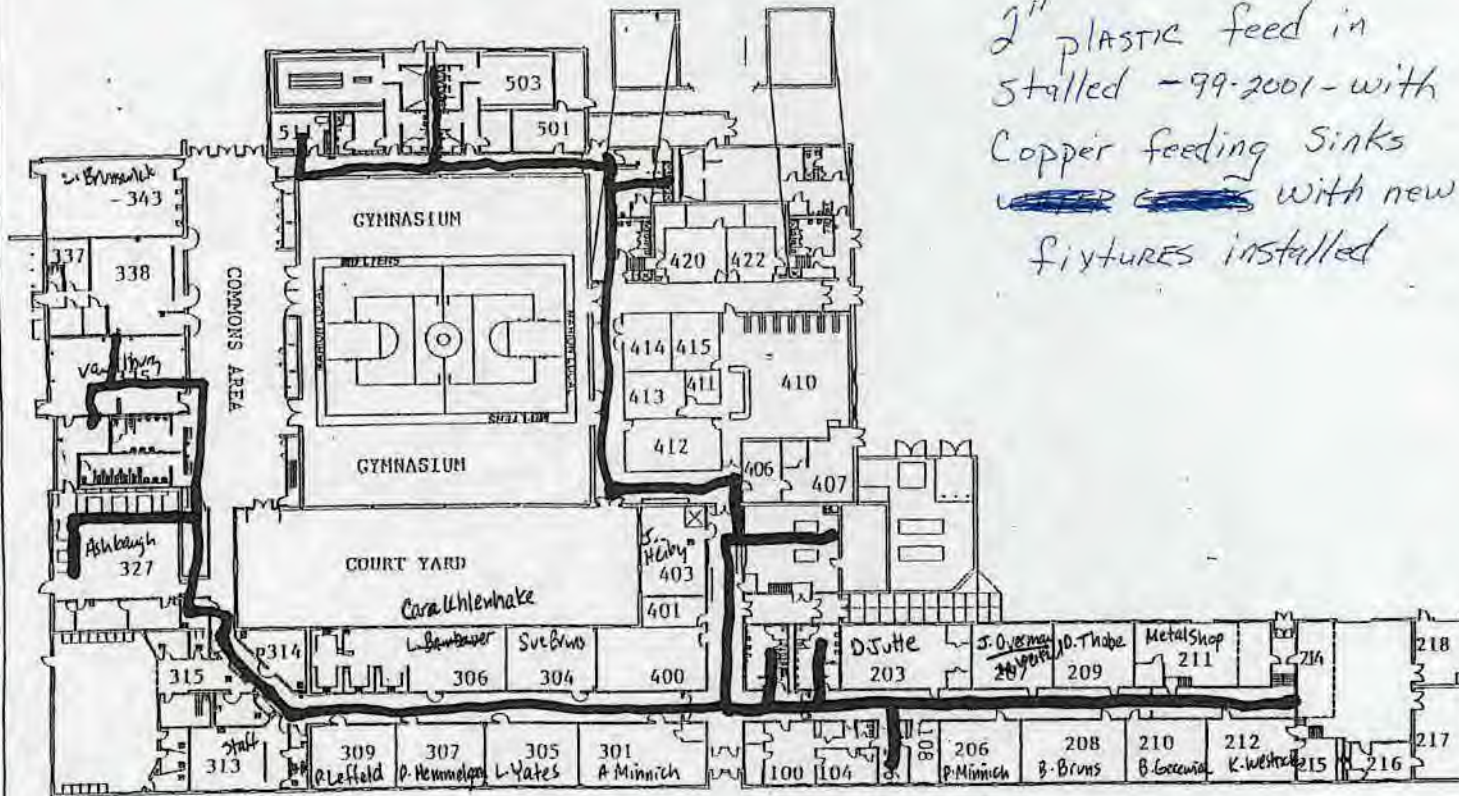


EXHIBIT:	1
COMM. NO.	8940
DATE:	AUGUST 10, 2002

MARION LOCAL HIGH SCHOOL  
MARION LOCAL SCHOOLS  
STATE ROUTE 716  


**MILLER**  

**GARMANN**



RECEIVED

FEB 01 2017

DDAGW - NWDO


Marion Local High School <sup>WEST</sup>

**Copper**

2" MAIN LINE  
Copper  
well drilled  
1964 + cleaned in

SOUTH

NORTH

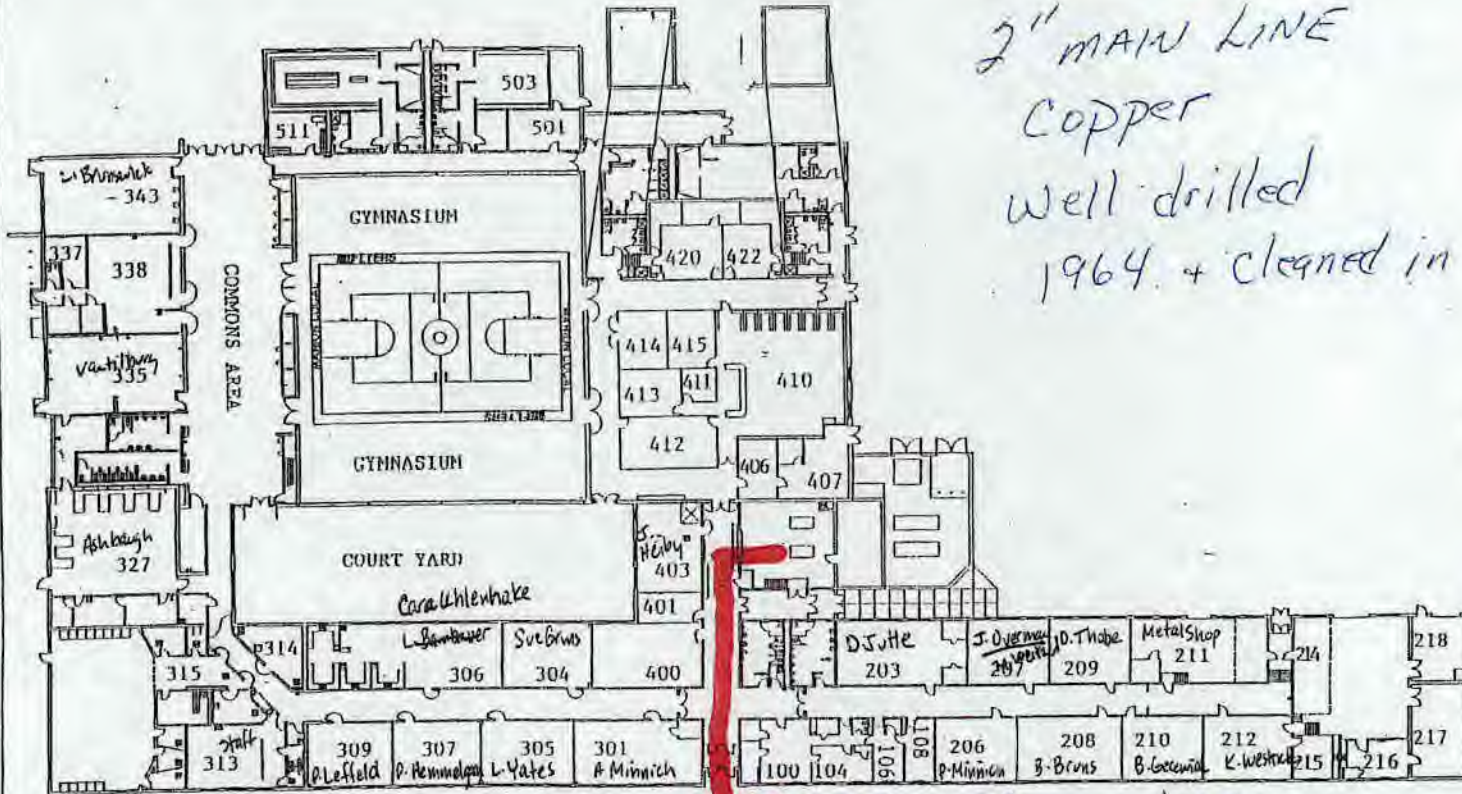

Well 2" copper line  
ST R 716

EXHIBIT:	1
COMM. NO.	0948
DATE:	AUGUST 19, 2002

MARION LOCAL HIGH SCHOOL  
MARION LOCAL SCHOOLS  
STATE ROUTE 716  
MARIA STEEP, OHIO

MILLER ENGINEERS  
GARMANN  

EAST



RECEIVED

FEB 01 2017

DDAGW - NWC


MARION LOCAL High School

Cold water

Fixtures put in 2000-2001

2" plastic with 3/4"

1/2" copper feeds

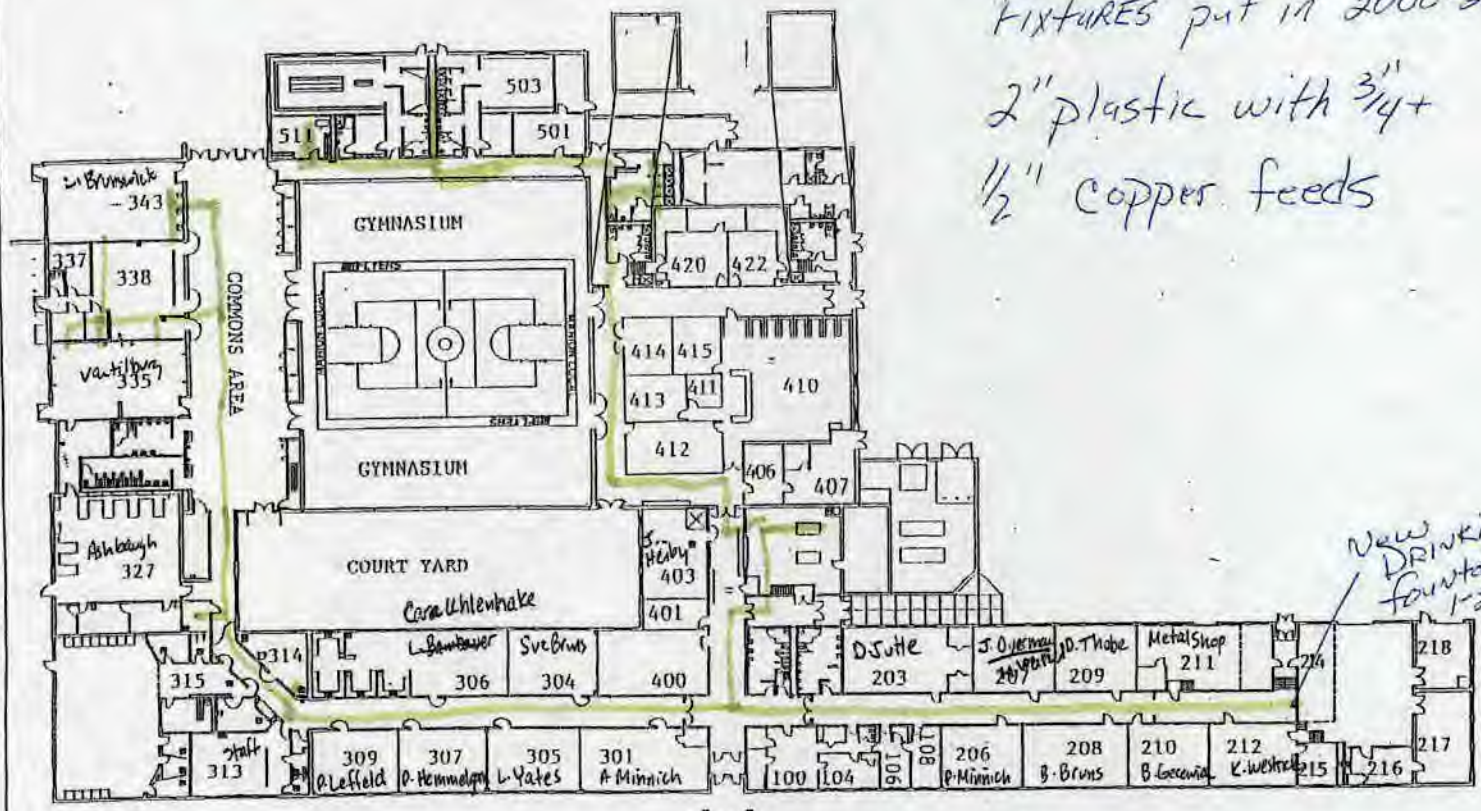

New Drinking Fountain 1-2020

EXHIBIT:	1
COMM. NO.	0948
DATE:	AUGUST 10, 2002

MARION LOCAL HIGH SCHOOL  
 MARION LOCAL SCHOOLS  
 STATE ROUTE 718  
 MARIA STEIN, 0000

MILLER  
 ROSSIGNOL  
 GARMANN








RECEIVED

FEB 01 2007

DDAGW - NWDO

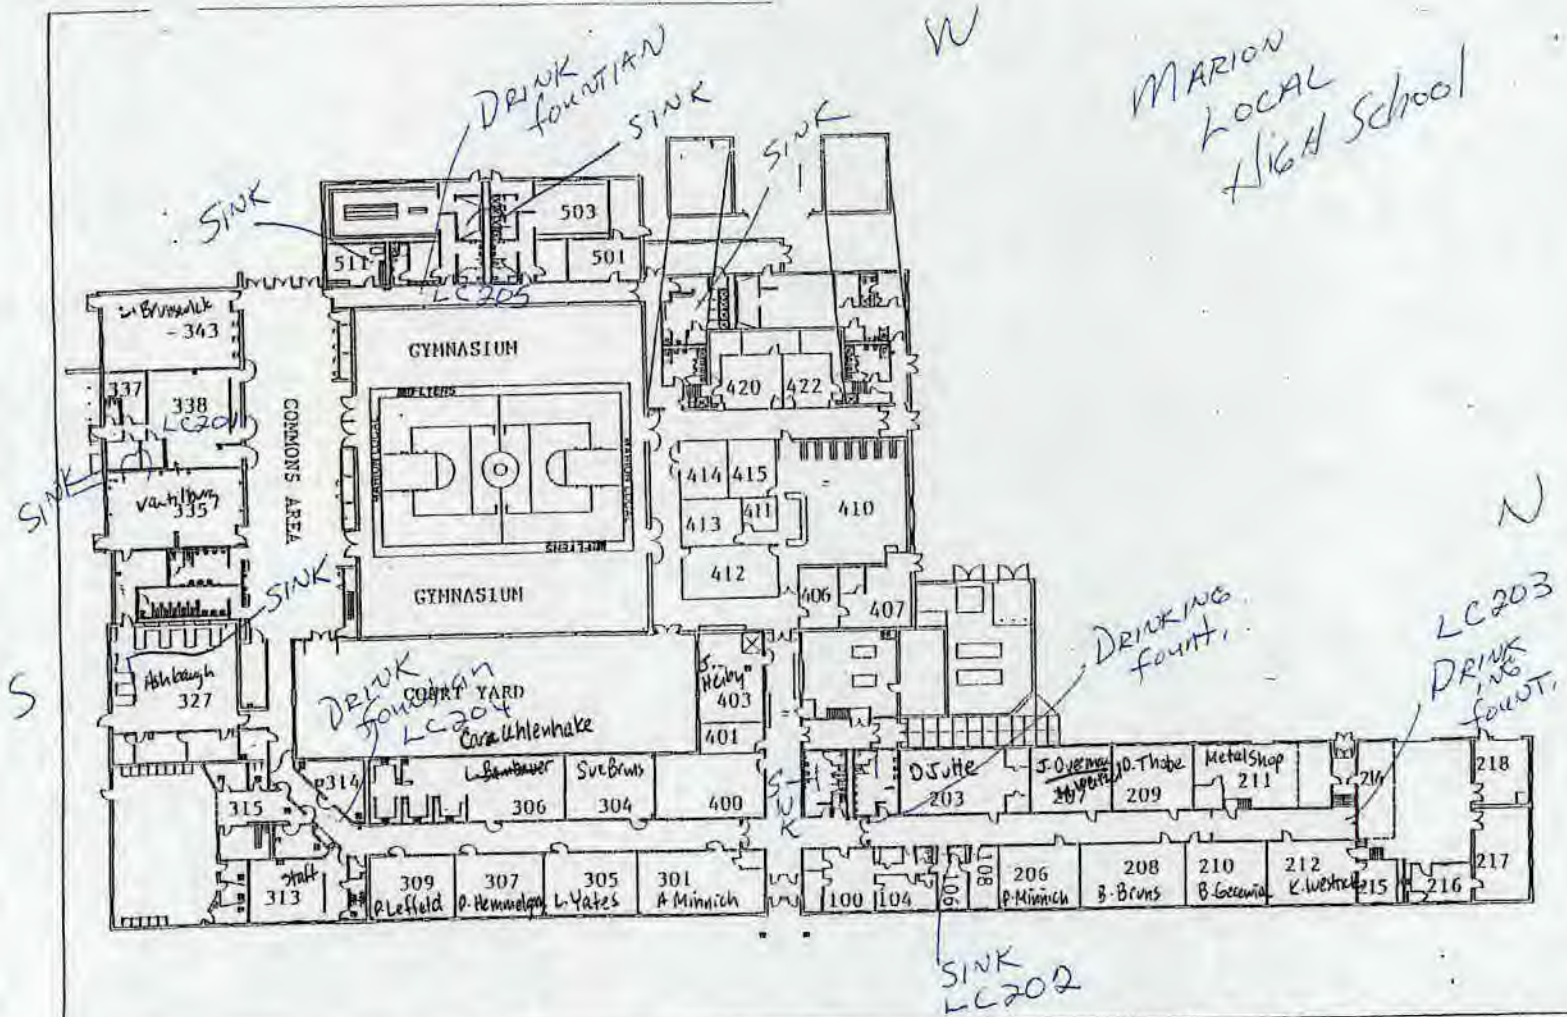

MARION LOCAL HIGH School

EXHIBIT: 1  
 COMM. NO: 994R  
 DATE: AUGUST 19, 2002

MARION LOCAL HIGH SCHOOL  
 MARION LOCAL SCHOOLS  
 STATE ROUTE 719  

MILLER  
 ROSEBUSH  
 GARMANN

