




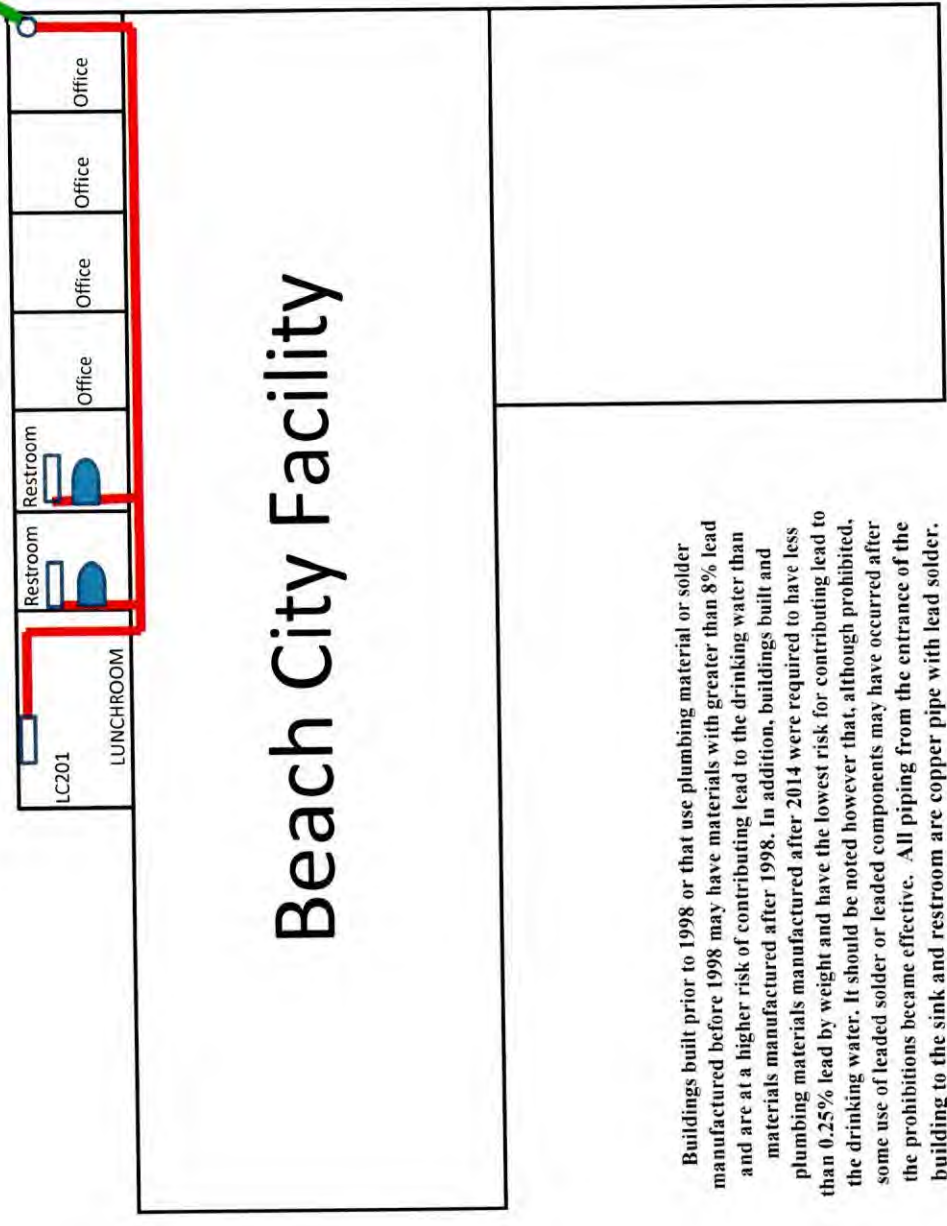
	Toilet
	Copper Lines with Lead Solder
	Sink
	PVC Line
	Pressure Tank
	Sample Gather Point



# Beach City Facility

Buildings built prior to 1998 or that use plumbing material or solder manufactured before 1998 may have materials with greater than 8% lead and are at a higher risk of contributing lead to the drinking water than materials manufactured after 1998. In addition, buildings built and plumbing materials manufactured after 2014 were required to have less than 0.25% lead by weight and have the lowest risk for contributing lead to the drinking water. It should be noted however that, although prohibited, some use of leaded solder or leaded components may have occurred after the prohibitions became effective. All piping from the entrance of the building to the sink and restroom are copper pipe with lead solder.