


RE: Cooper Farms Cooked Meats  
Report  
Drinking Water Program  
Van Wert County  
PWS ID: OH8134212

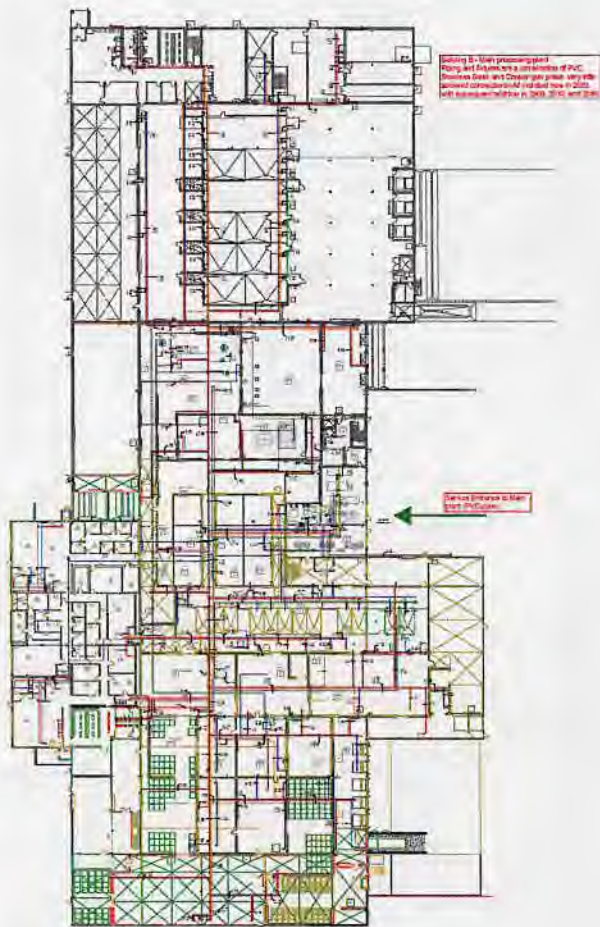



Service Entrance to Main  




Building A - Utility Room pre-occupied

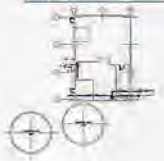

RECEIVED

FEB 10 2017

DDAGW - NWDO