








RE: Midwest Electric  
Report  
Drinking Water Program  
Auglaize County  
PWS ID: OH0637012







RECEIVED

FEB 10 2017






DDAGW - NWDO

Midwest Electric, Inc.  
06029 County Rd. 33A  
St. Marys, OH 45885


-  Copper Pipe w/ Non-Lead Solder (2008) – Cold Water
-  Copper Pipe w/ Non-Lead Solder (2008) – Hot Water
-  Copper Pipe w/ Lead Solder (1963) – Cold Water
-  Copper Pipe w/ Lead Solder (1963) – Hot Water
-  PVC Pipe (2008) – Cold Water
-  1 Fixture fed by Copper Pipe w/ Lead Solder (1963)
-  10 Fixture fed by Copper Pipe w/ Non-Lead Solder (2008)

-  T1 Toilet or Urinal fed by Copper Pipe w/ Lead Solder (1963)
-  T10 Toilet or Urinal fed by Copper Pipe w/ Non-Lead Solder (2008)
-  S1 Shower fed by Copper Pipe w/ Lead Solder (1963)
-  S2 Shower fed by Copper Pipe w/ Non-Lead Solder (2008)
-  WH Water Heater fed by Copper Pipe w/ Lead Solder (1963)
-  WH2 Water Heater fed by Copper Pipe w/ Non-Lead Solder (2008)


**LCR sampling locations \***

- 1) Lineman Bathroom - Lineman's Locker Room Sink Faucet – Steel and Brass (2008) 
- 2) Garage Sink - Garage Sink Faucet – Steel and Brass (2008) 
- 3) Ice Room - Operations Mechanical Room Spigot – Brass (2008) 
- 4) Break Room - Break Room Sink Faucet – Steel, Brass, & Plastic (2016) 
- 5) Community Room - Community Room Sink Faucet – Steel, Brass, & Plastic (2008) 

RECEIVED  
FEB 19 1992  
CIVIL WORK

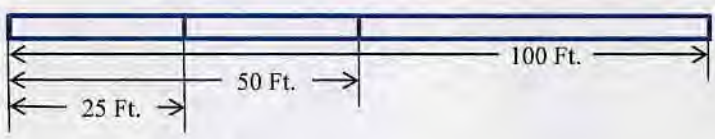


Office Area First Floor

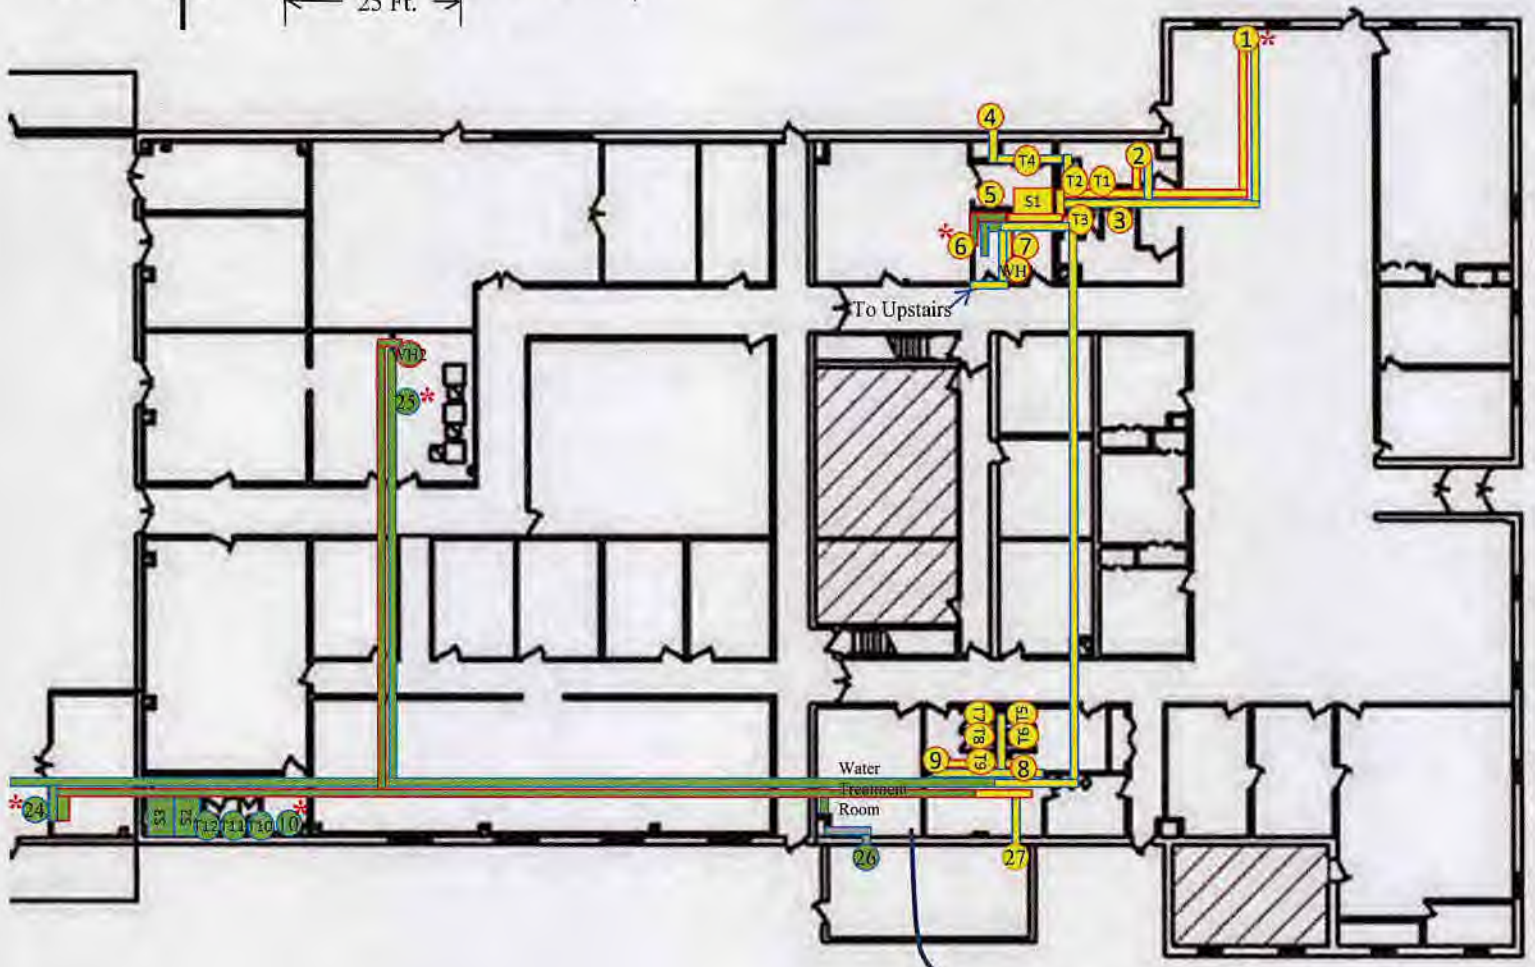



Line from Well



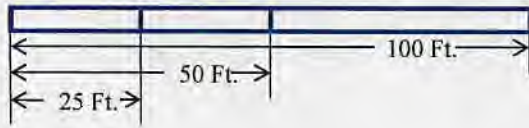

Garage Area First Floor

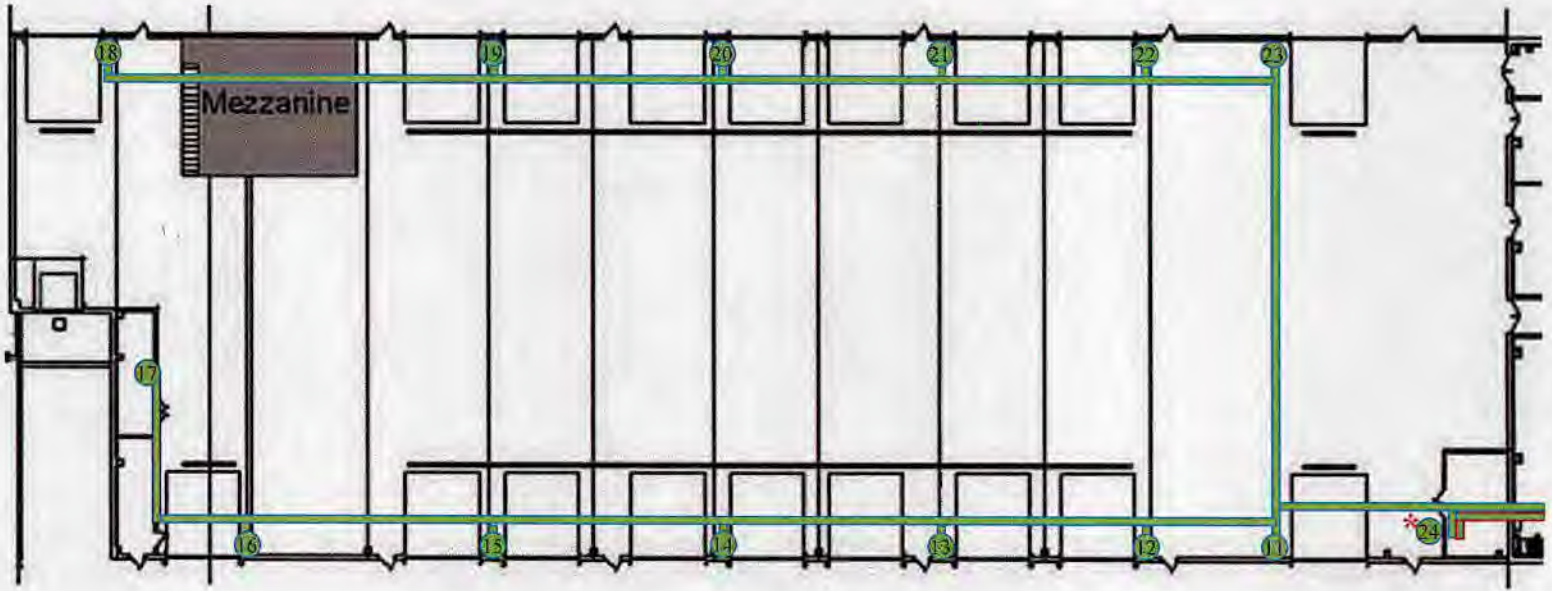

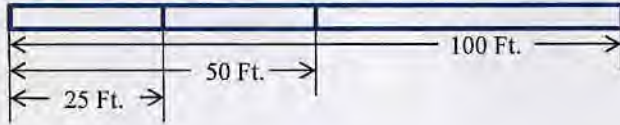

Second Floor





1	Community Room Sink Faucet – Steel, Brass, & Plastic (2008)
2	Men's Community Room Bathroom Sink Faucet – Steel, Brass, & Plastic (2008)
3	Ladies Community Room Bathroom Sink Faucet – Steel, Brass, & Plastic (2008)
4	East Exterior Spigot – Brass (1963)
5	Ladies Locker Room Sink Faucet – Steel, Brass, & Plastic (2012)
6	Break Room Sink Faucet – Steel, Brass, & Plastic (2016)
7	Janitors Room Sink Faucet – Brass and Steel (1963)
8	Ladies West Bathroom Sink Faucet – Steel, Brass, & Plastic (2008)
9	Men's West Bathroom Sink Faucet – Steel, Brass, & Plastic (2008)
10	Lineman's Locker Room Sink Faucet – Steel and Brass (2008)
11	Garage Spigot – Brass (2008)
12	Garage Spigot – Brass (2008)
13	Garage Spigot – Brass (2008)
14	Garage Spigot – Brass (2008)
15	Garage Spigot – Brass (2008)
16	Garage Spigot – Brass (2008)
17	North Mechanical Room Spigot – Brass (2008)
18	Garage Spigot – Brass (2008)
19	Garage Spigot – Brass (2008)
20	Garage Spigot – Brass (2008)
21	Garage Spigot – Brass (2008)
23	Garage Spigot – Brass (2008)
24	Garage Sink Faucet – Steel and Brass (2008)
25	Operations Mechanical Room Spigot (2008)
26	Generator Room Spigot – Brass on PVC Pipe (2008)
27	Generator Room Exterior Spigot – Brass (1963)
28	Upstairs Spigot – Brass (1963)
W11	Rheem Marathon Water Heater Janitor Closet (2008)
W12	Rheem Marathon Water Heater Operations Mechanical Room (2008)
S1	Ladies Locker Room Shower - Steel and Plastic (2008)
S2	Lineman's Locker Room Shower - Steel and Plastic (2008)
S3	Lineman's Locker Room Shower – Steel and Plastic (2008)
T1	Urinal Men's Community Room Restroom (2008)
T2	Toilet Men's Community Room Restroom (2008)

