

RE: Beaverdam Village
Report
Drinking Water Program
Allen County
PWS ID: OH0200012

RECEIVED

FEB 16 2017

OHIO E.P.A.
N.W.D.O.

February 10, 2017


The Village of Beaverdam, Ohio installed a water treatment plant with a distribution system in 1964.

Over the past 2.5 -3 years the Village has been installing meter pits off the Curb box, removing meters from basements, crawl spaces, etc. This past year we finished up and installed a radio read system. The employees found no lead service lines anywhere, all were copper, a few plastic. We have many of the original Cast iron water mains, brass corp stops, curb stops, which I don't know how you want that considered seeing as how these would have lead in the brass casting. Since 1998 the Village has been installing C-900 water mains.

The map I have sent you shows water mains in light blue, covered in green, the thin yellow lines are property lines/ right of way boundaries from the Allen County GIS system. I have colored over the Light blue water line indicators with a green magic marker indicating no lead lines.

If you have any questions and or concerns, please contact me at 419-234-6472.

Thank You,

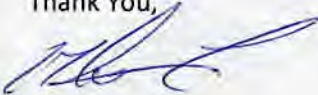

Mike Leis

Village of Beaverdam

Beaverdam Water Map



Main Street